
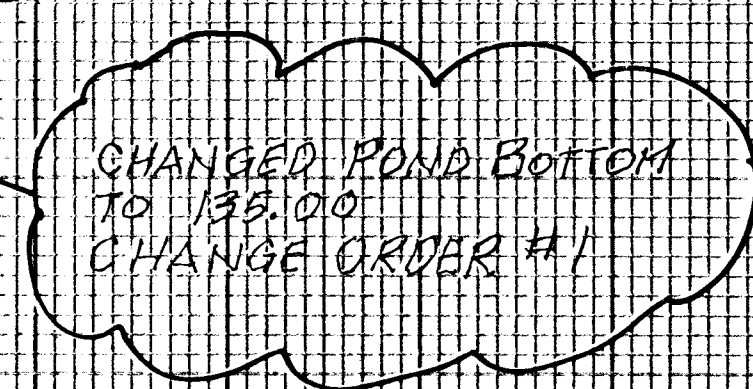


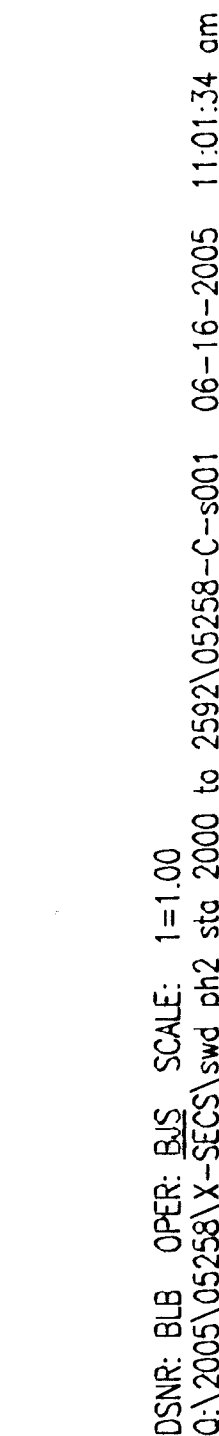

RECORD DRAWING

POND NO. 3
STA 20+00 TO 23+00
SCALE: 1" = 10' VERT.
1" = 10' HORIZ.