


PROFILE	CHECKED	CHECKED	BY	DATE

PLAN	CHECKED	CHECKED	BY	DATE

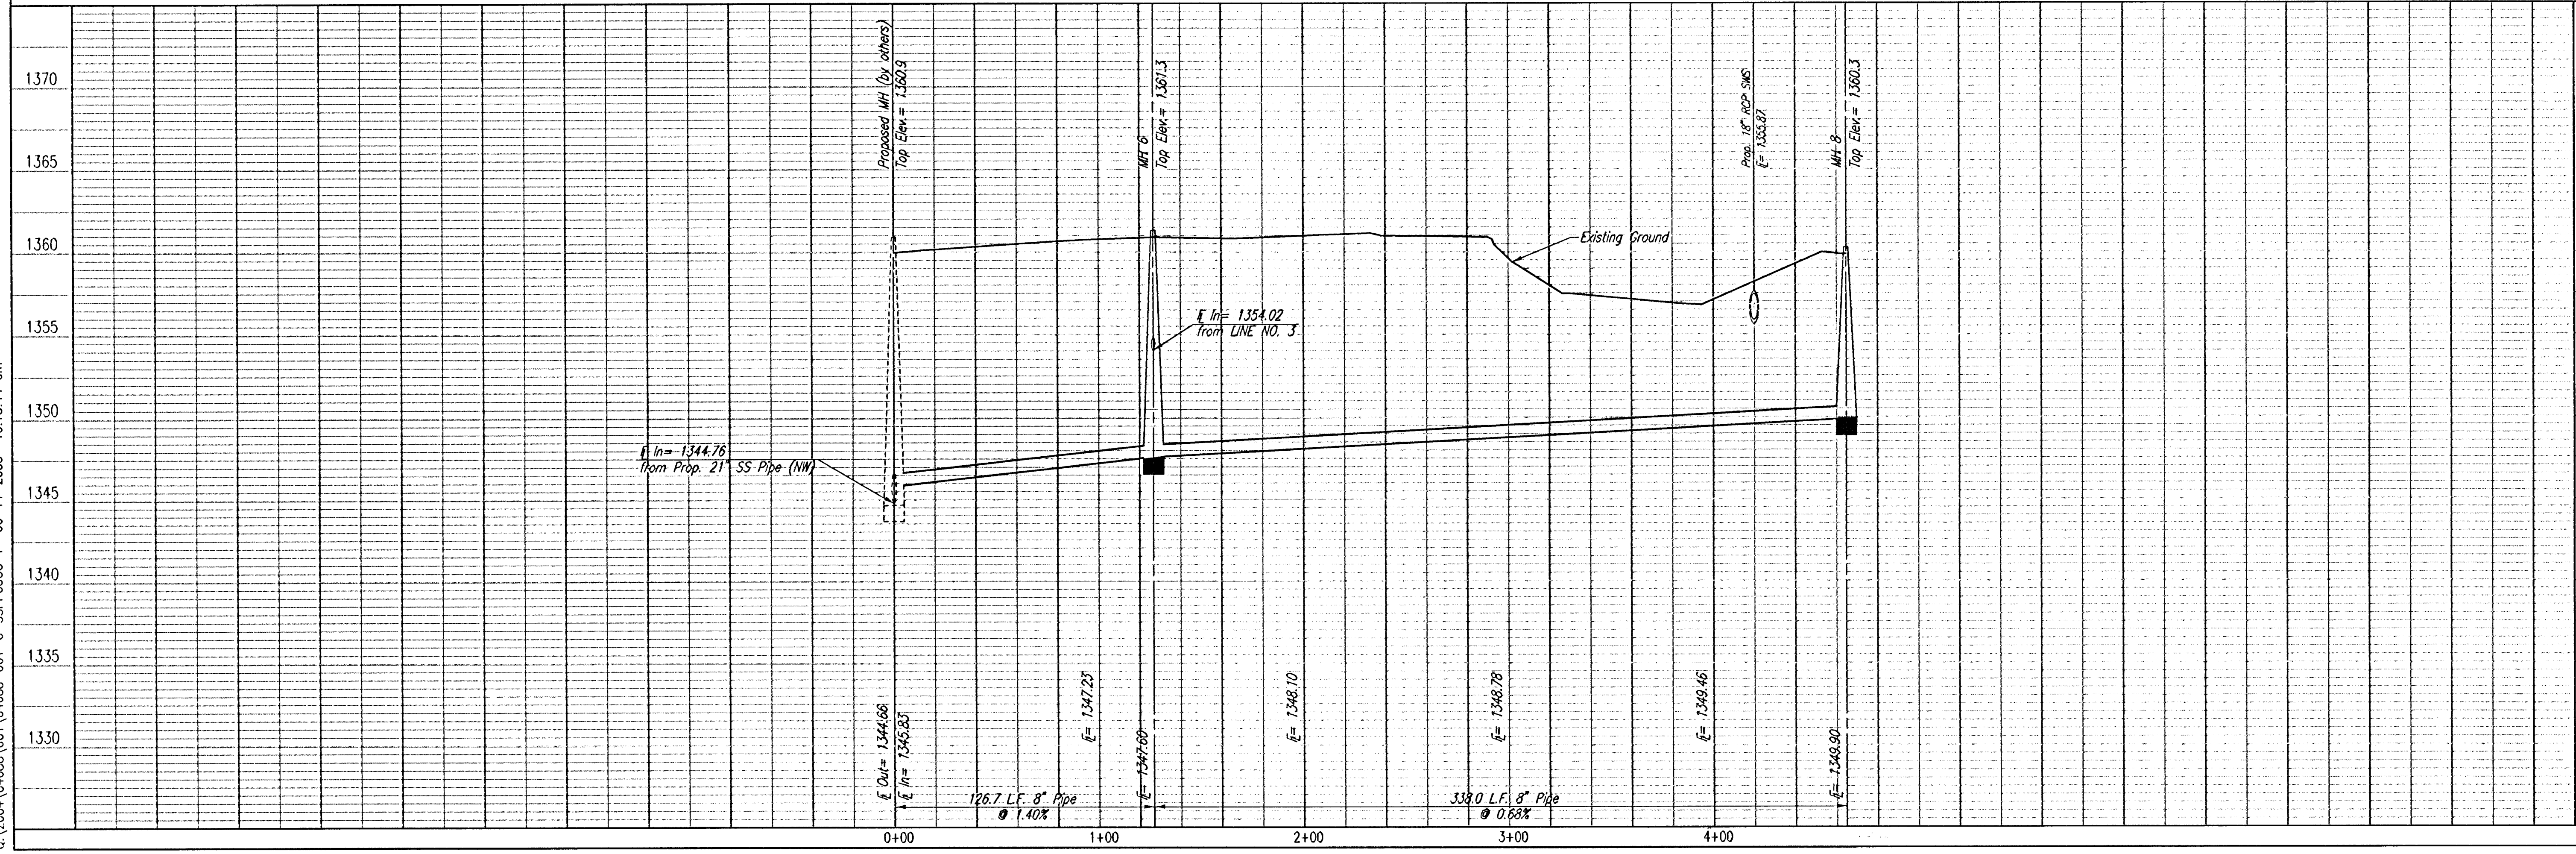

SANITARY SEWER LINE NO. 2


N-386,752.2877, E-2,373,394.0758
Sta. 0+00.0
Proposed Precast Concrete MH (by others).
Plug and stake end of Pipe for future
connection by others. See detail sheet no. 8

N-386,628.5397, E-2,373,366.9898
Sta. 1+26.7
Const. MH 6
Outside Drop MH


~~N-386,528.1371, E-2,373,397.1236~~
~~Sta. 2+24.2~~
~~Const. MH 7~~
~~Standard MH~~
MH 7 OMITTED

CAUTION !!!
Proposed 18" RCP Storm
Sewer (by others)

N-386,304.8246, E-2,373,464.1464
Sta. 4+64.7
Const. MH 8
Standard MH

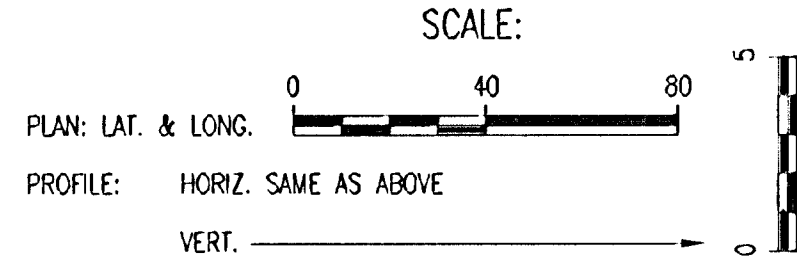

SEE SHEET NO. 3 & 4
FOR PLAT COORDINATES

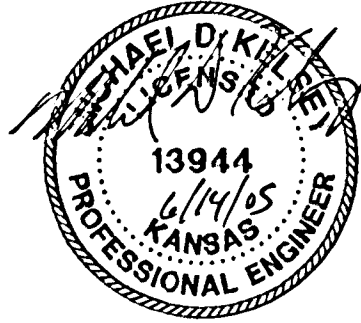

No.	By	Date
1	MDK	06/14/05

CHANGE ORDER #1- SANITARY SEWER ALIGNMENT CHANGE

Revision

LATERAL 1, MAIN 16
OF THE FOUR MILE CREEK SEWER

SANITARY SEWER LINE NO. 2

JAMES L. ARMOUR, P.E. - ACTING CITY ENGINEER
CITY OF WICHITA PROJECT NO. 488-83984

Professional Engineering Consultants, P.A.
303 S. TOPEKA • WICHITA, KANSAS 67202
316-262-2691 • FAX 316-262-3003

Job No. 35-04688-001 Date January 2005

Designed By MDK
Drawn By TLB

Sheet 7 of 18
CHANGE ORDER #1