

James L. Armour, P.E. Acting City Engineer

468-83758


744105

City Disc In T.C. Adj. to F.H. 17.5
North of Monterey. At the South
West Corner of Lot 10 Block C
Auburn Hills 15th Addition.
Elev. = 177.39 (City Datum)

City Disc In T.C. Adj. to F.H. 27'
North of Monterey. At the
Intersection of Monterey and
Auburn Hills.
Elev. = 179.40 (City Datum)

Title Sheet	1
Line 1	2
Lines 1A, 2 & 2A	3
Line 3	4
Line 3A	5
Riser Plan Sheet	6
Standard Manhole Detail	7
Ring & Cover Detail	8
Riser Detail	9
Erosion Control Plan	10
Erosion Control Details	11-14
Copy of Plat	15


Utility Contractors, Inc.- Contractor
Edingfield, Baughman Co.- Inspector
Released 11/2/05
As-Built
Piers & Stubs
.pdf by JDL.

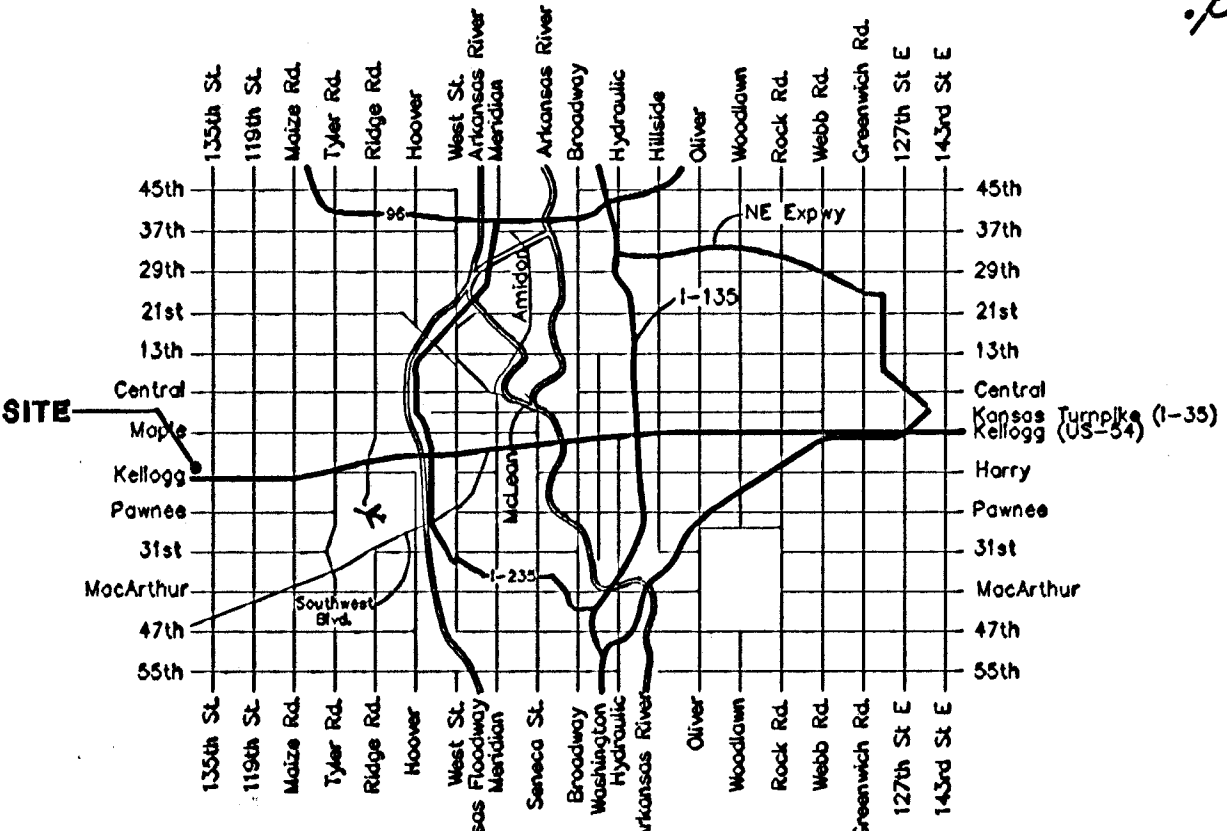

Vicinity Map



Baughman Company, P.A. 315 Ellis St. Wichita, KS 67211 P 316-262-7271 F 316-262-0149
ENGINEERING | SURVEYING | PLANNING | LANDSCAPE ARCHITECTURE

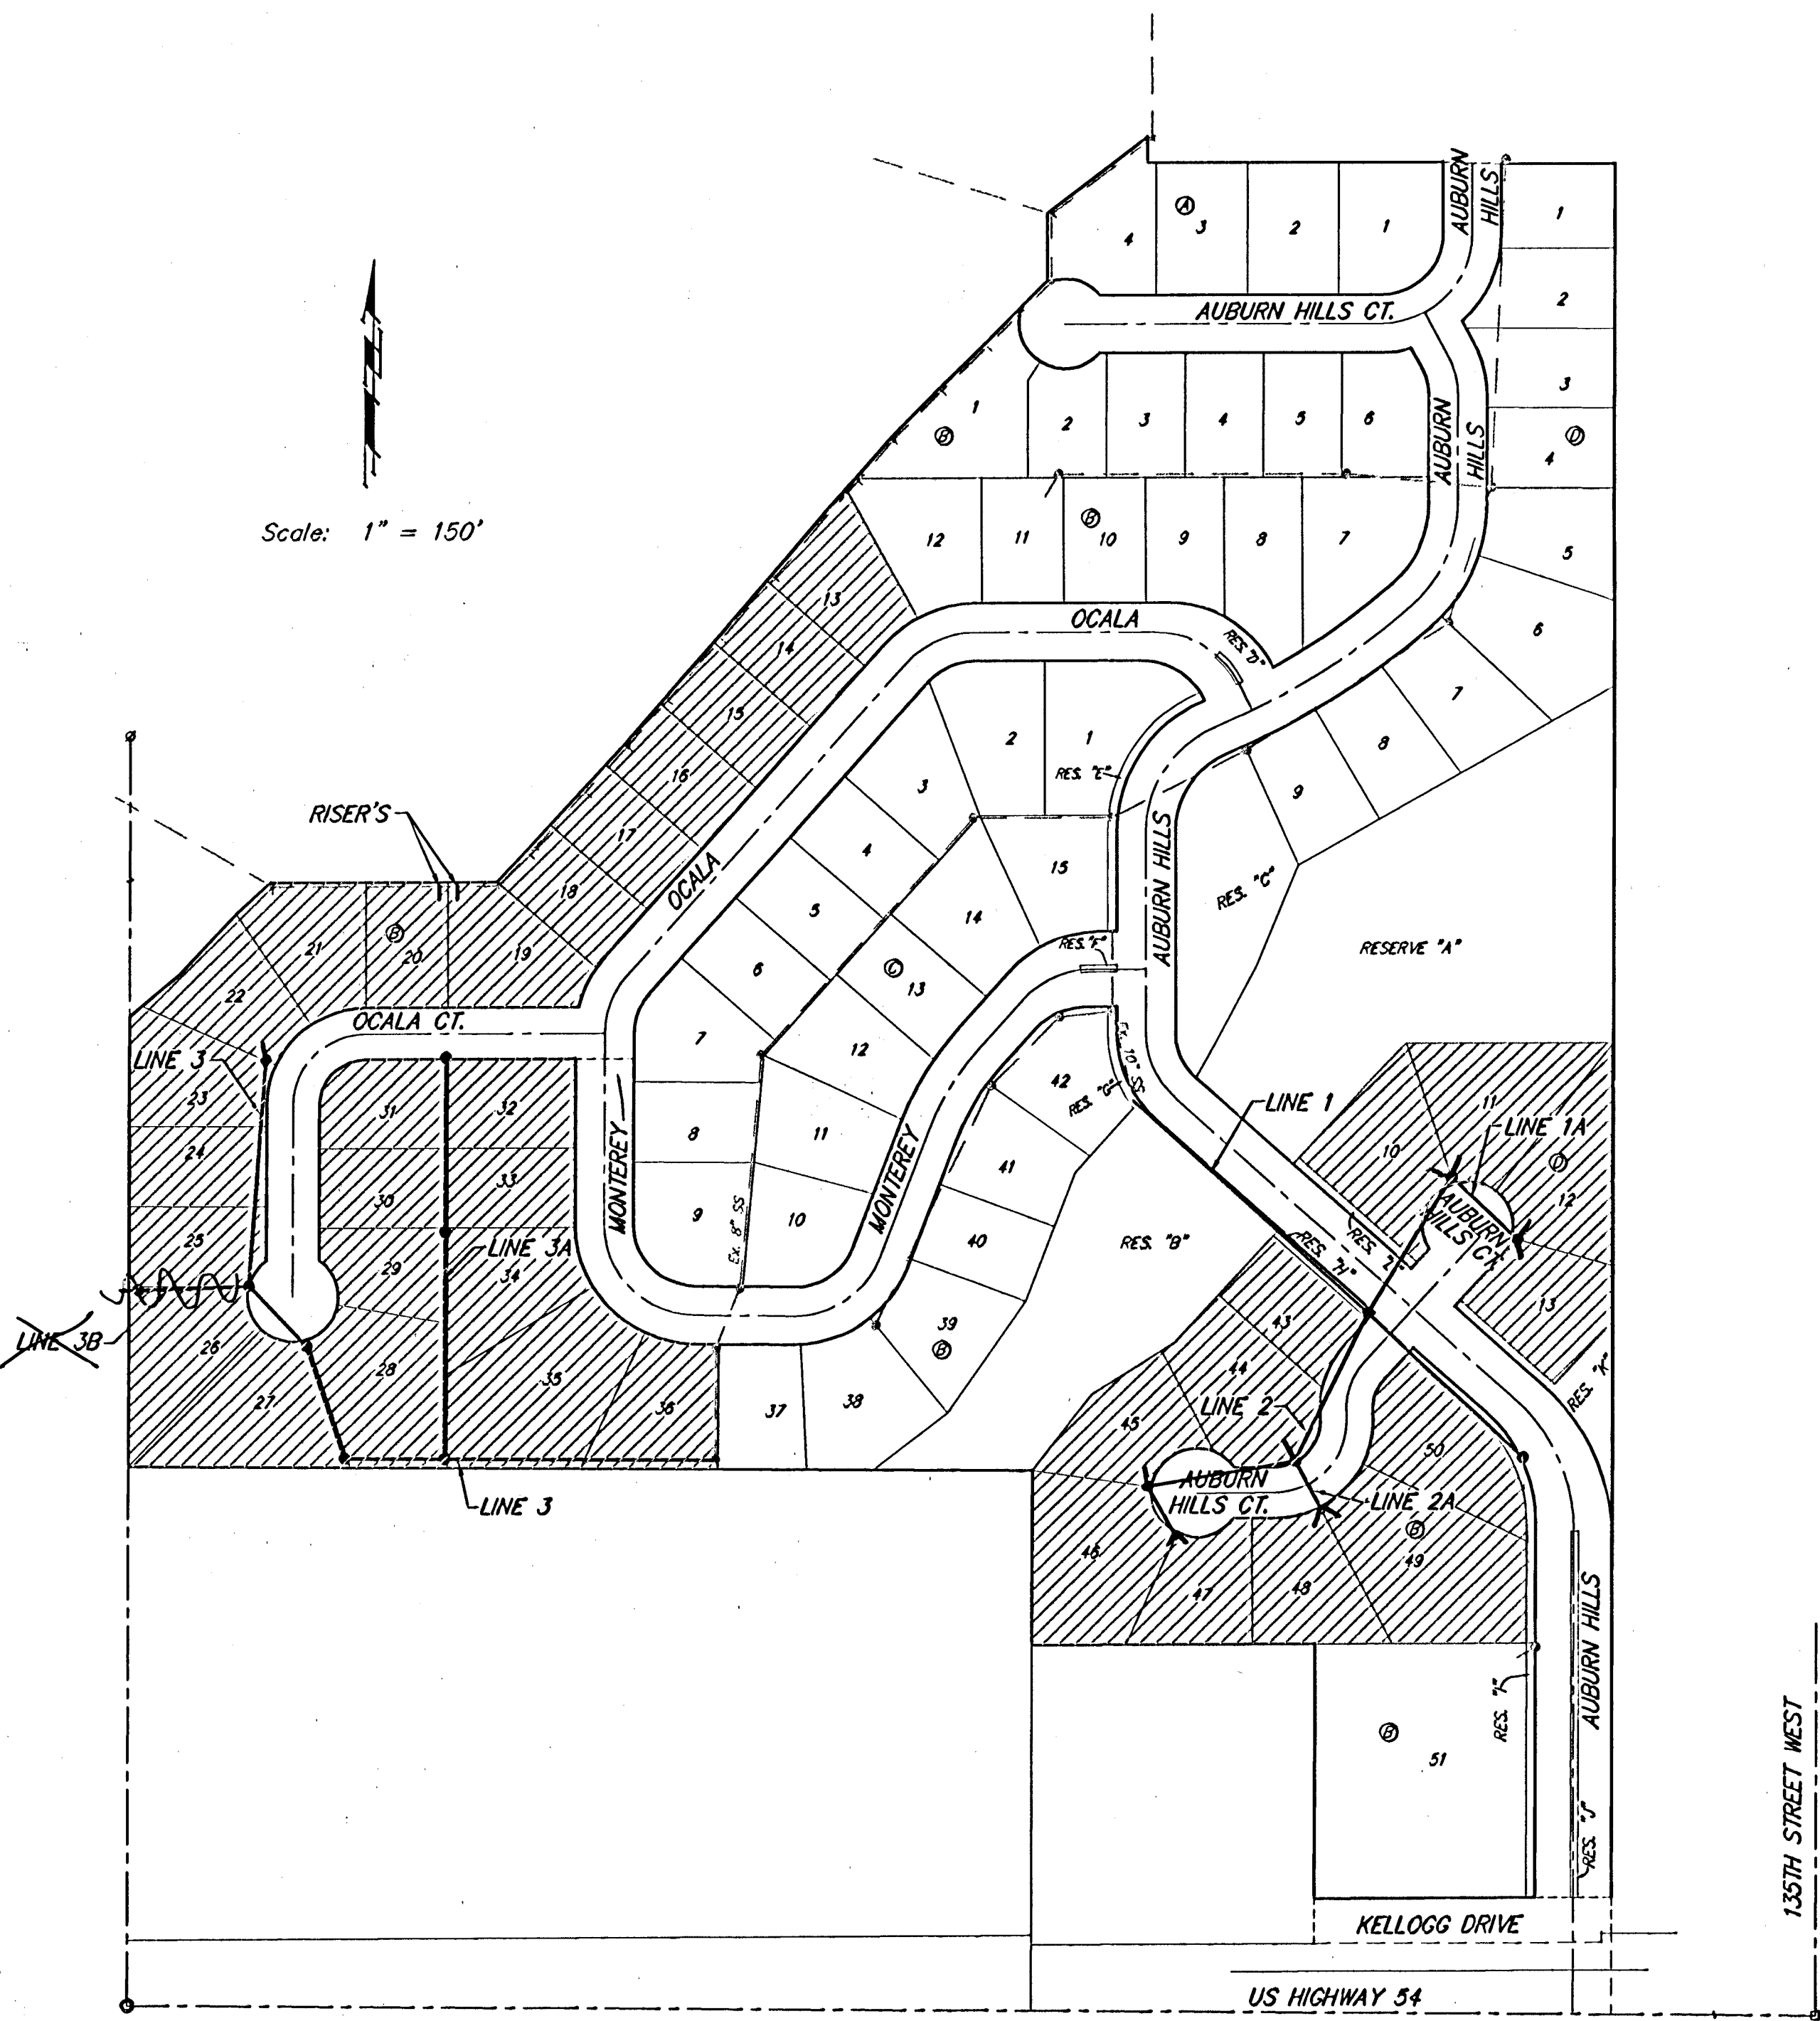Benefit District 

1. Contractor will be required to provide notice to utility companies a minimum of twenty-four (24) hours prior to any excavation, as follows:

Kansas One-Call 687-2470

The Contractor must notify the following in case of an emergency:

Cox Communications	262-4270
Kansas Gas Service	1-888-482-4950
Wastor Energy	383-8650
Aquila Energy	1-800-303-0357
SBC	268-2245
City of Wichita Water Dept.	268-4543
City of Wichita Sewer Maint.	268-4024
City of Wichita Storm Sewer Maint.	268-4036
City of Wichita Traffic Maint.	268-4036
Conoco Pipeline Co.	1-800-231-2551
Southern Star Pipeline Co.	529-6660
Phillips Pipeline Co.	1-800-766-8230
Jayhawk Pipeline Co.	1-888-542-9575

2. Utility service lines, poles, valve boxes, meters, and etcetera are to be adjusted as necessary by others prior to construction unless the plans specifically call for their adjustment by the Contractor or unless the plans specifically identify a utility to be adjusted by its owner during construction. Existing utilities and their location, as shown on the plans, represent the best information obtainable for design. The Contractor will be required to work around existing utilities within the right-of-way which do not conflict with proposed construction.
3. Rubble from the removal of miscellaneous structures and excess excavation which is to be wasted shall be disposed of on sites to be provided by the Contractor. These sites shall be approved by the Engineer as to suitability, appearance and site location. Location in the opinion of the Engineer, that will leave an unsightly appearance will not be approved. All disposal sites must be approved by the Kansas Department of Health and Environment. Material either stockpiled or disposed of in a flood plain would require a Kansas State Board of Agriculture permit. Any material dumped in waters of the United States or waters subject to the Corps of Engineers permitting regulations. Any material buried or stockpiled beyond approved construction limits would require additional archaeological investigations unless buried in a previously approved borrow location.
4. Trees and shrubs in public right-of-way which are in direct conflict with proposed new construction shall be removed by the Contractor with the Engineer's approval. Trees and shrubs which are not in direct conflict with proposed new construction shall be saved and protected from damage.
5. The Contractor shall give all property owners and/or tenants of developed property abutting the construction of this project a minimum of ten (10) days advance notice prior to start of construction.
6. The Contractor shall be responsible for preserving property irons. The Contractor will be required to re-establish any irons which are damaged or destroyed by his construction operations. Such irons shall be re-established by a licensed land surveyor in accordance with state laws