

BENCHMARK:


City Disc In T.C. Adj. to F.H.
17.5' North of Monterey. At the
South West Corner of Lot 10
Block C Auburn Hills 15th
Addition.
Elev. = 177.39 (City Datum)

City Disc In T.C. Adj. to F.H.
27' North of Monterey. At the
Intersection of Monterey and
Auburn Hills.
Elev. = 179.40 (City Datum)

Contractor shall not remove or
damage any trees for Sanitary
Sewer Construction on Line 3.
Any tree damage shall require
replacement by Contractor at no
additional cost to the project.


All sprinkler lines shall be
protected from damage during
construction. Contractor shall
repair or replace all damaged
sprinkler lines & heads at no
additional cost to the project.

Scale: 1" = 40' Horizontal
1" = 5' Vertical
• = Iron

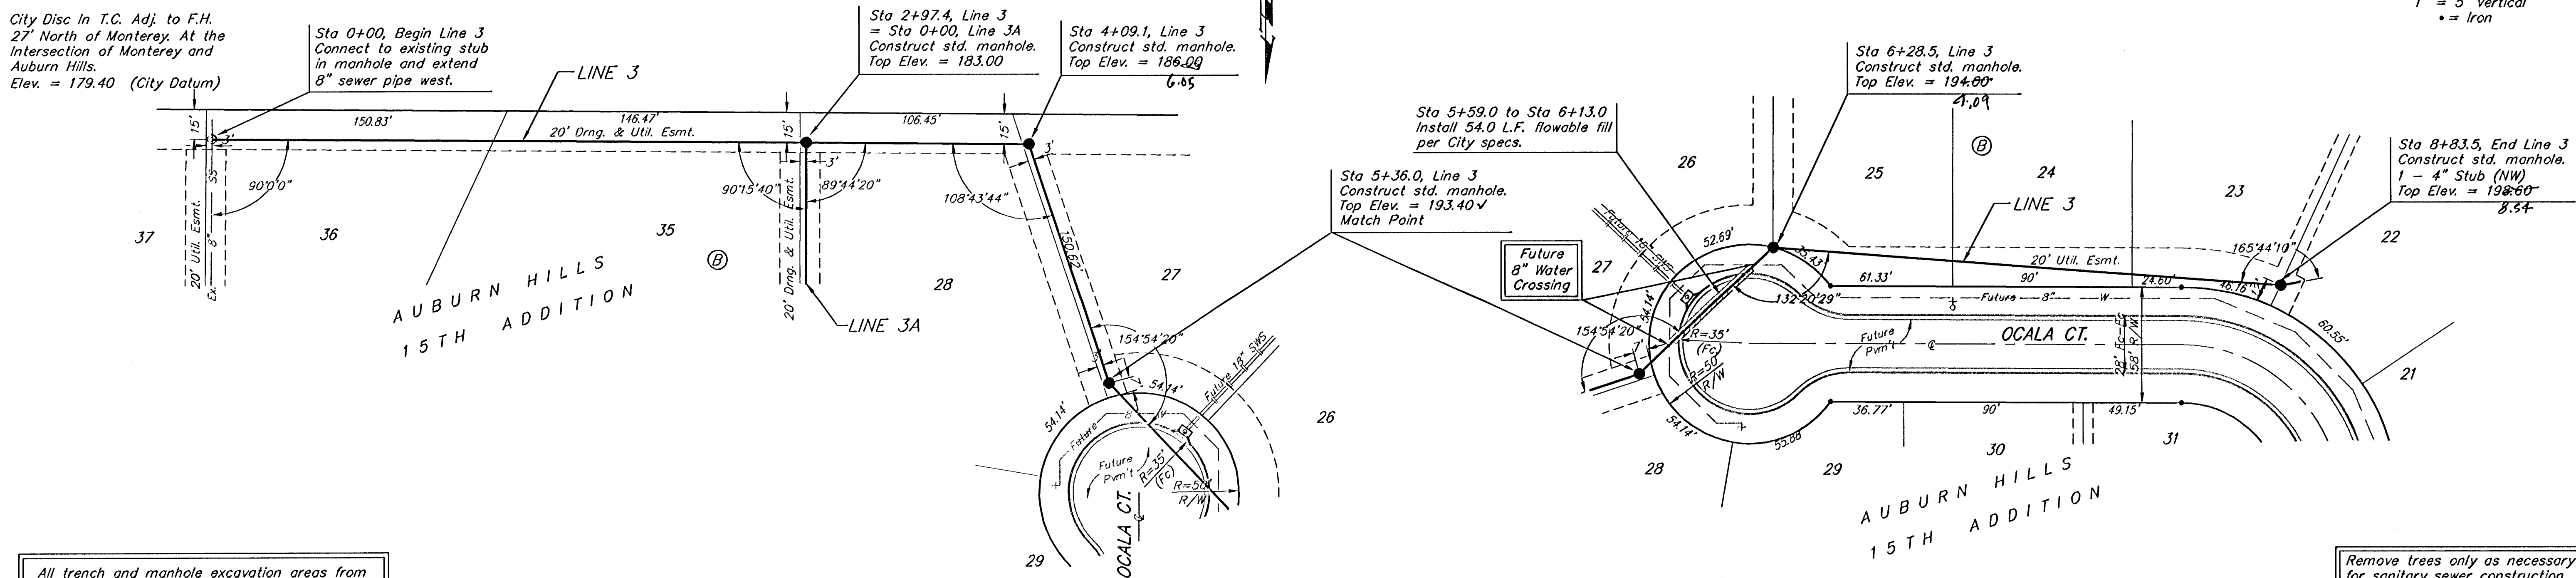

All trench and manhole excavation areas from
Sta. 6+28.5 to Sta. 8+83.5, Line 3 shall be
backfilled with sand. The sand backfill shall be
within two feet of existing grade and shall be
water-jetted and vibrated during backfilling. All
costs shall be subsidiary to pipe cost.

Remove trees only as necessary
for sanitary sewer construction
and only with permission of
Developer or Baughman Co.
Cost of removal to be incidental
to lump sum bid item "Site
Clearing & Restoration".

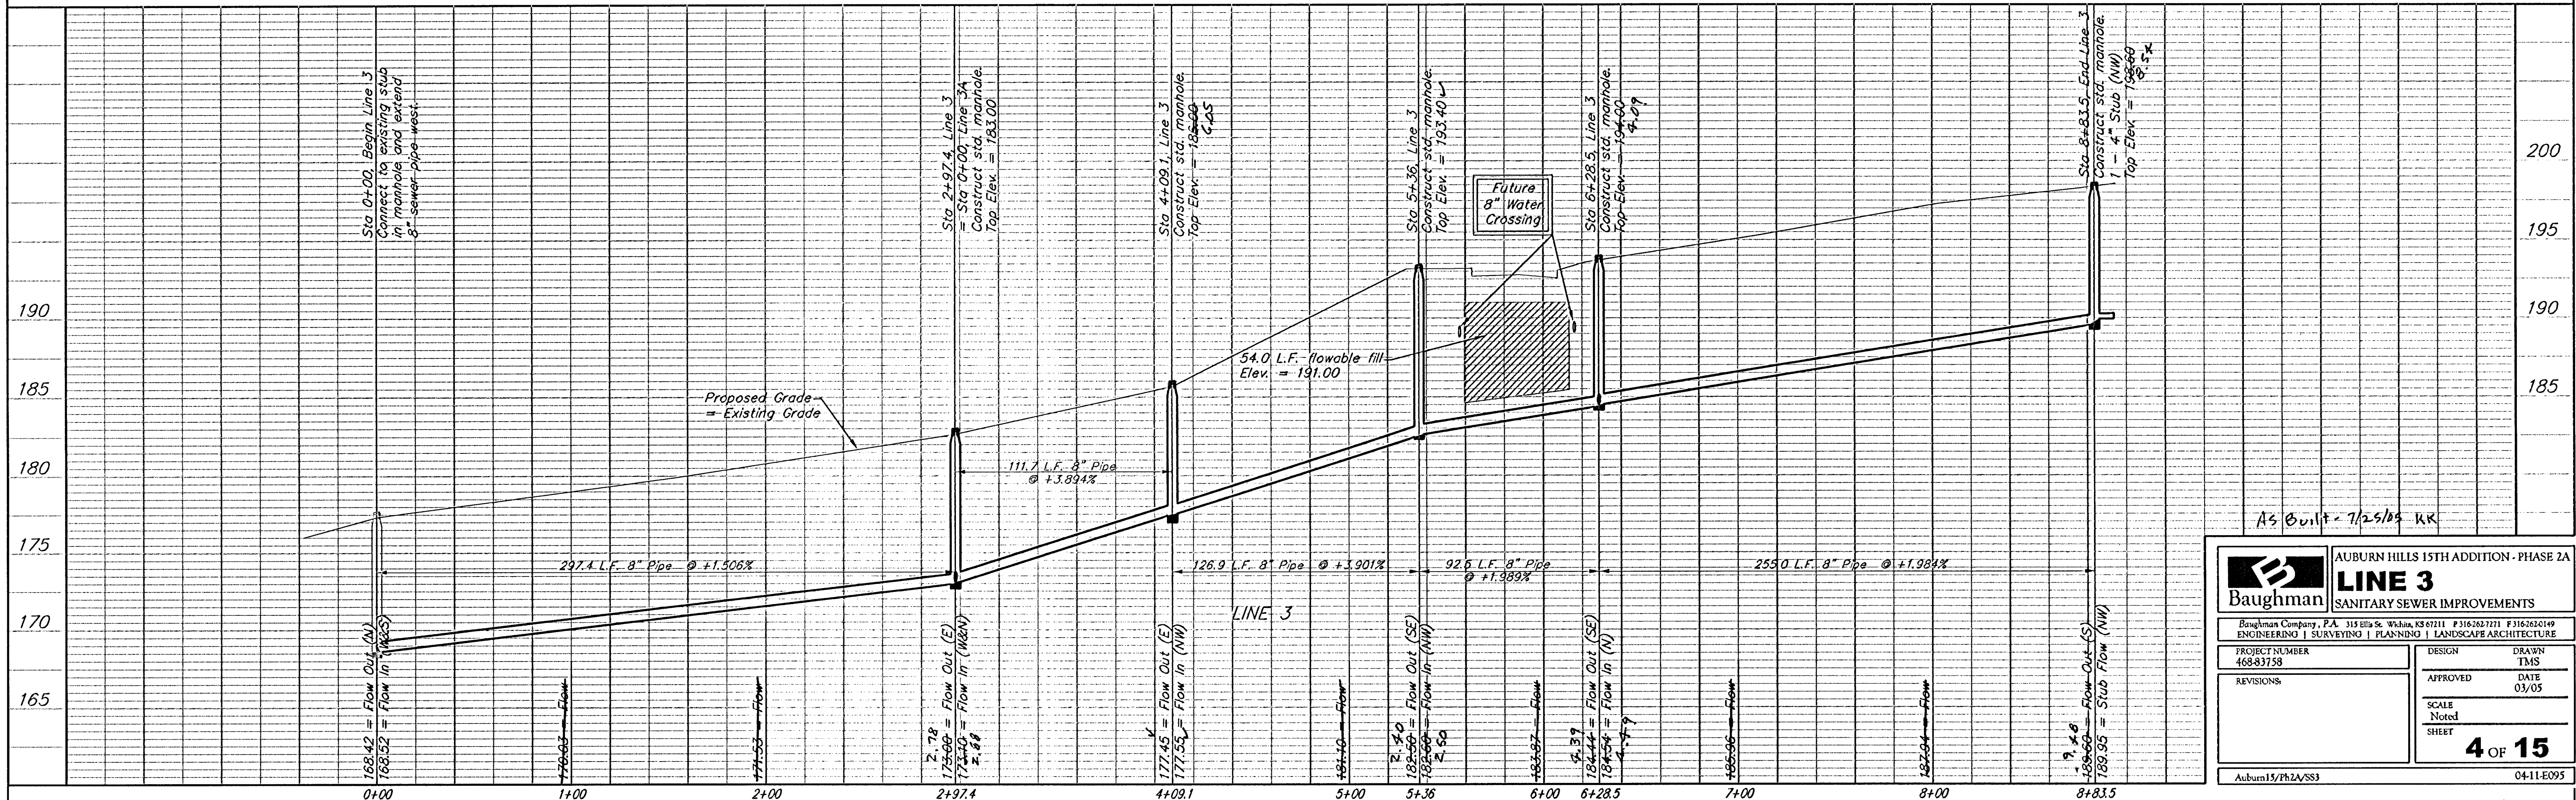

AS BUILT - 7/25/03 K.R.

Baughman		AUBURN HILLS 15TH ADDITION - PHASE 2A	
LINE 3		SANITARY SEWER IMPROVEMENTS	
Baughman Company, P.A. 315 11th St. W. Suite 100, P.O. Box 100, P.O. Box 100, P.O. Box 100			
ENGINEERING SURVEYING PLANNING LANDSCAPE ARCHITECTURE			
PROJECT NUMBER 468-83759		DESIGN TMS	
REVISIONS		APPROVED DATE 03/05	
		SCALE Noted SHEET	
		4 OF 15	
Auburn15/Ph2A/SS3		04-11-E095	