


BENCHMARK:
R.R. SPIKE IN HLP, 150' E. & 30'
S. OF THE S.W. COR., S.E. 1/4,
SEC. 12-26-1W.
ELEV. = 1338.96 M.S.L.
ELEV. = 151.56 City Datum


"O" IN OPEN, TOP FLANGE OF
FIRE HYDRANT AT THE S.W.
CORNER OF 61ST. ST. N. &
MERIDIAN AVE.
ELEV. = 1339.16 M.S.L.
ELEV. = 151.76 City Datum

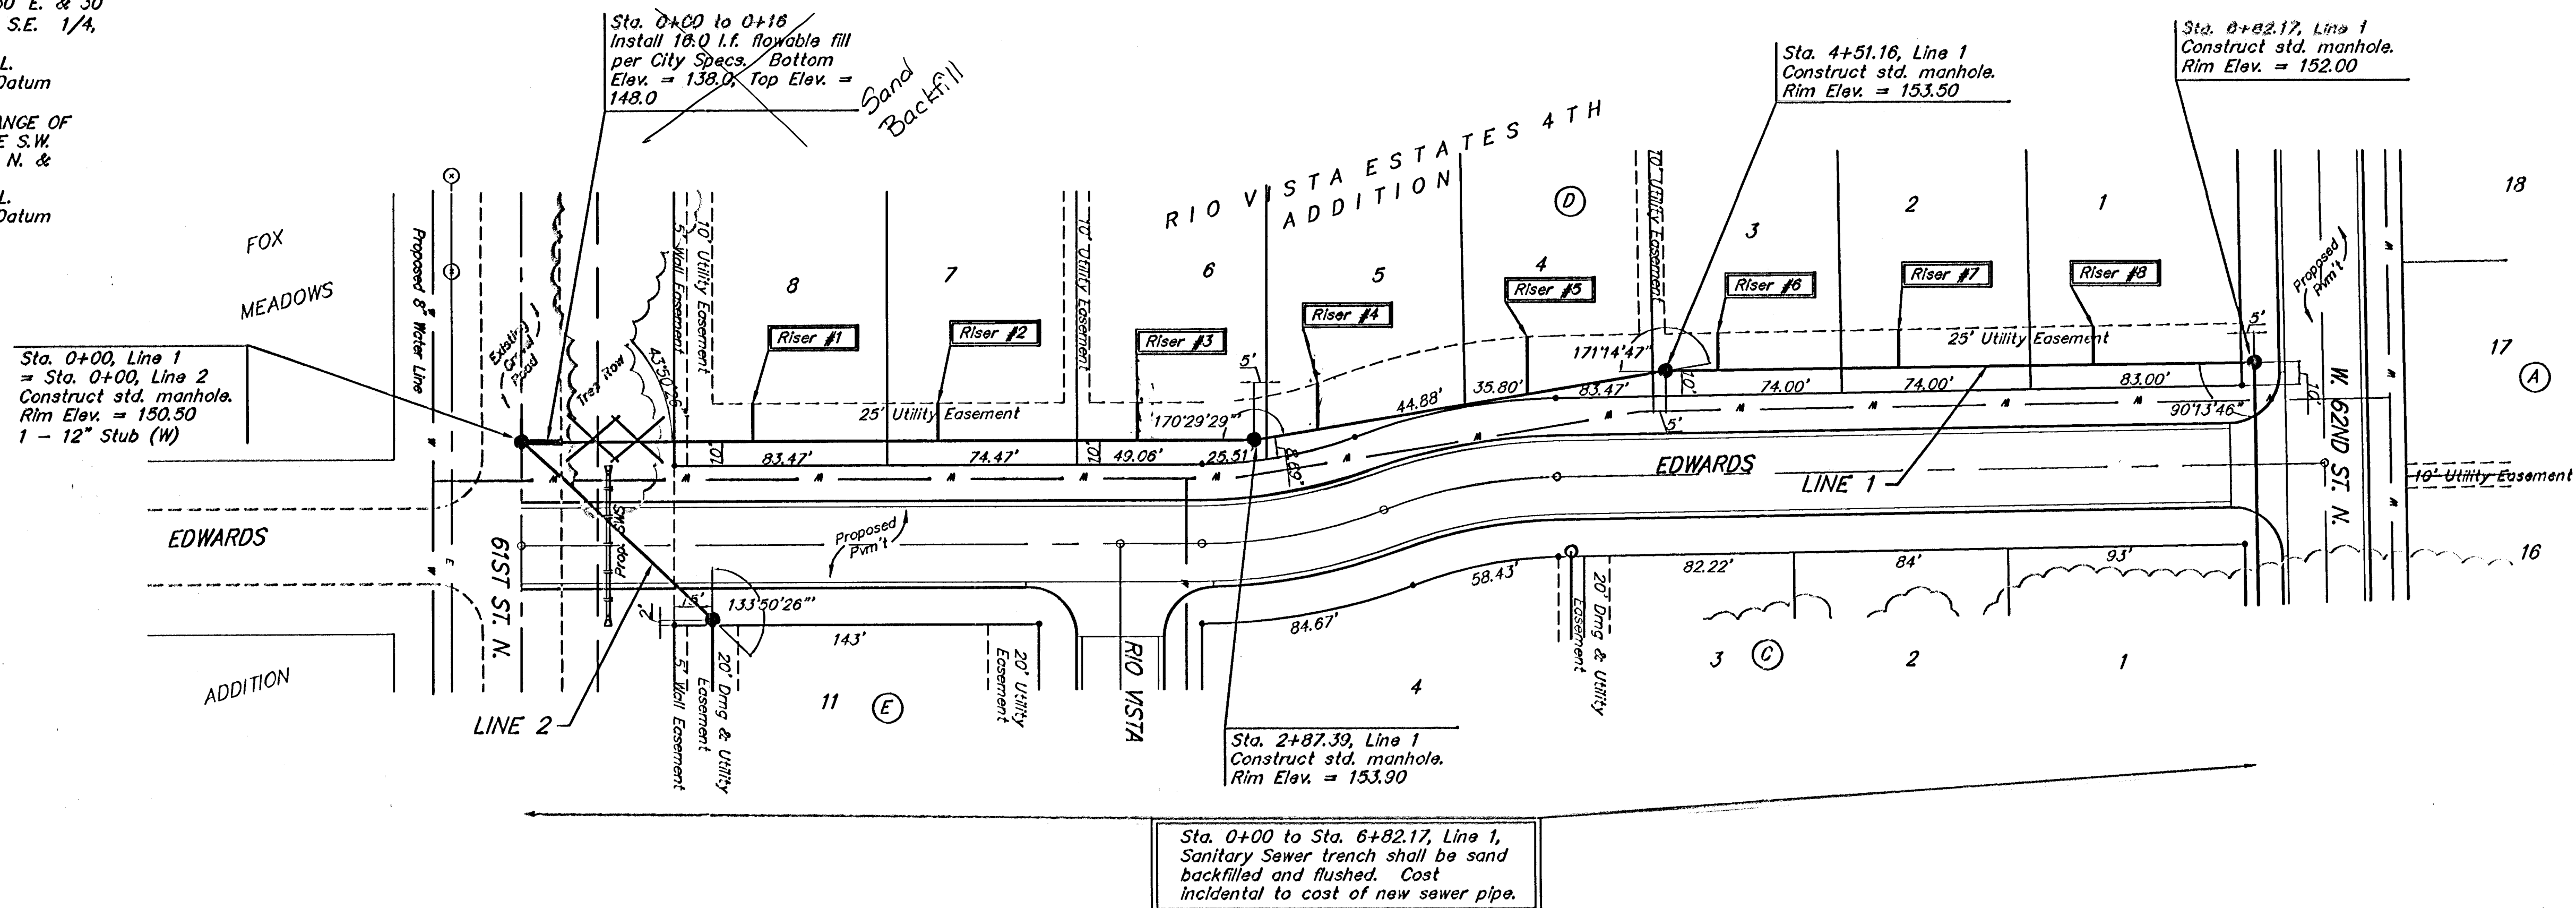

Scale: 1" = 40' Horizontal
1" = 5' Vertical
= Iron

Denotes Trees to be
Removed by the
Sanitary Sewer Contractor

SEWER SERVICE TABLE - See Sheet 6

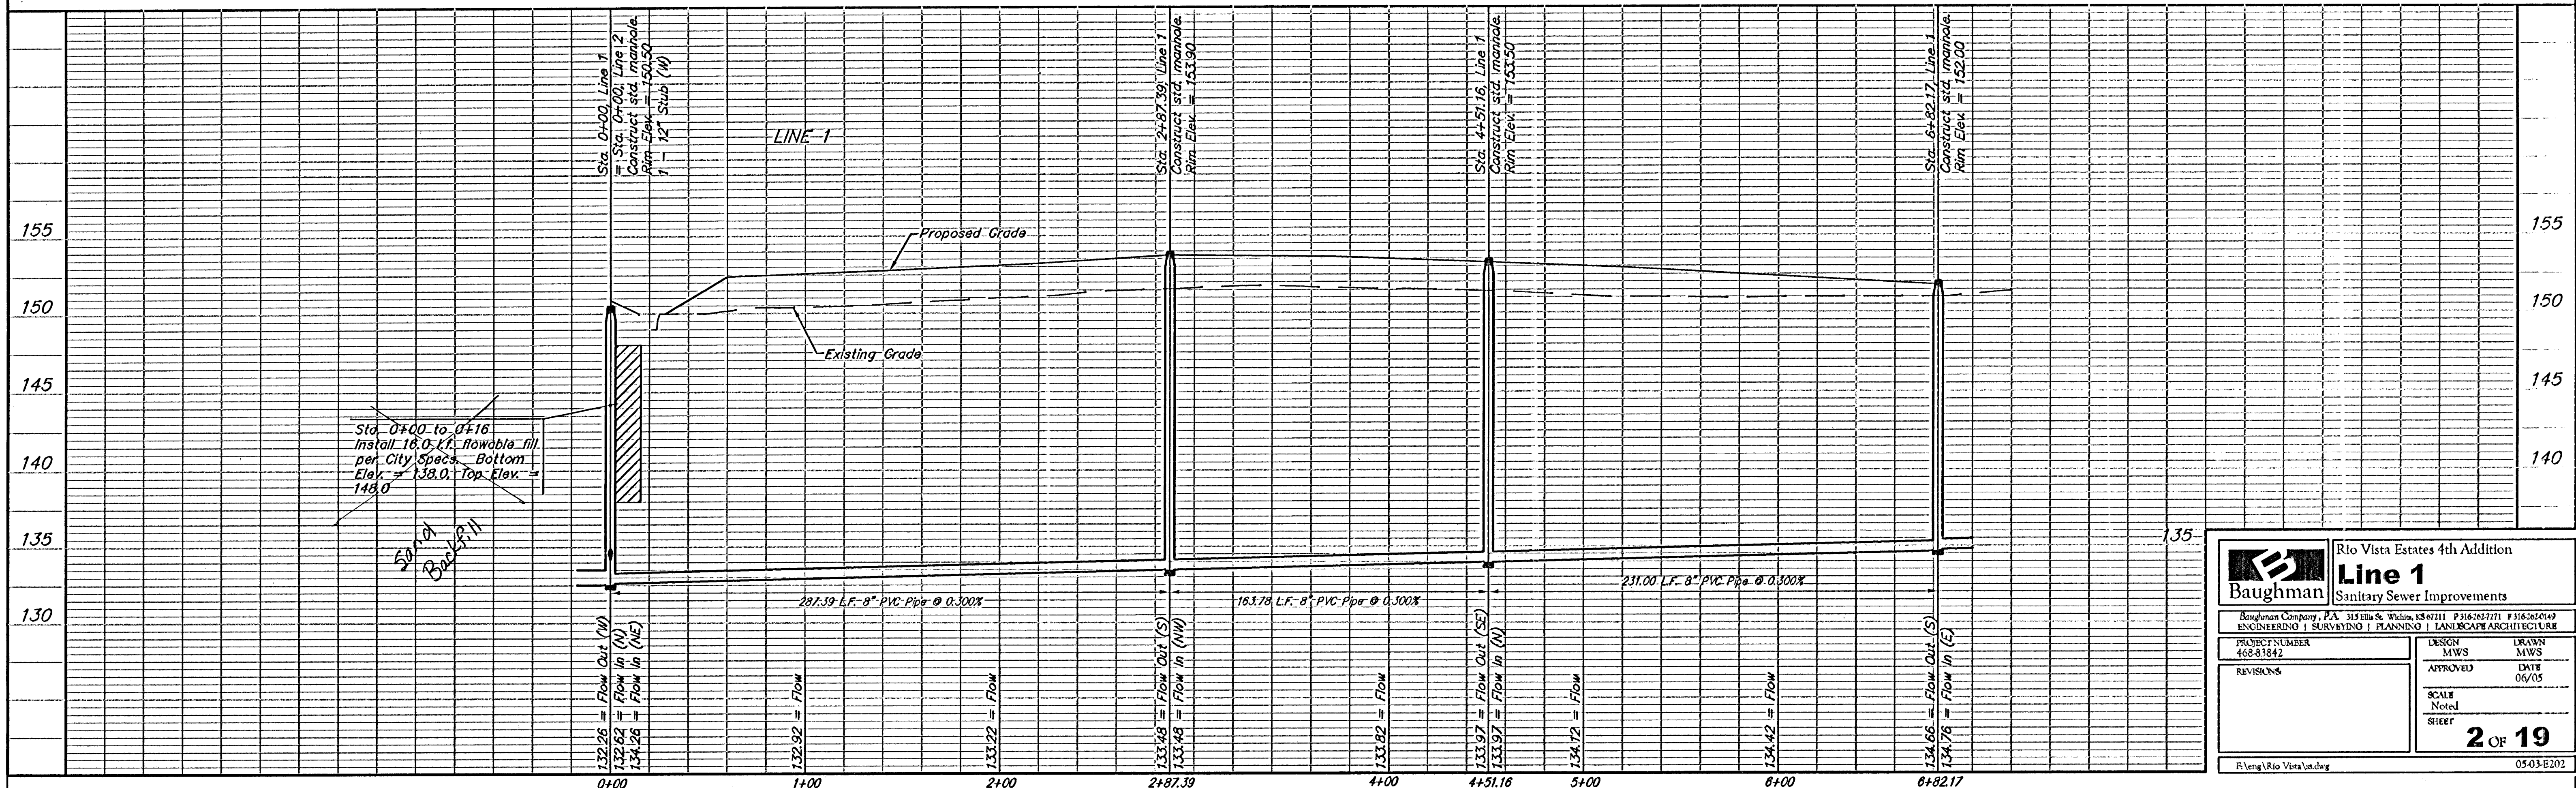

Baughman		Rio Vista Estates 4th Addition	
Line 1		Sanitary Sewer Improvements	
Baughman Company, P.A. 315 Ellis St. Windsor, MI 48090 P 313-282-7771 F 313-282-0149		ENGINEERING SURVEYING PLANNING LANDSCAPE ARCHITECTURE	
PROJECT NUMBER 488-1842	DESIGN MVS	DRAWN MVS	DATE 06/05
REVISIONS	APPROVED	SCALE Noted	SHEET 2 OF 19
Rio Vista Estates 4th Addition		05-03-B202	