
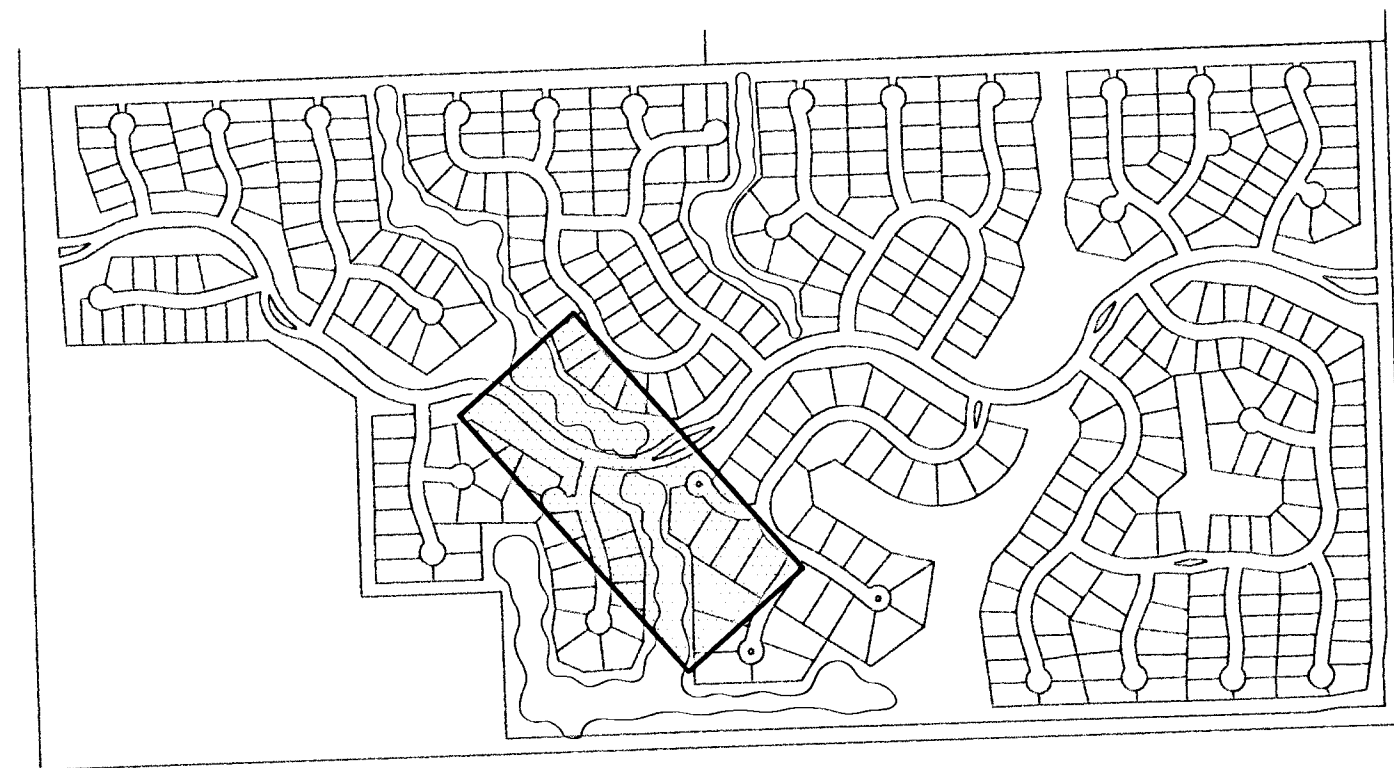



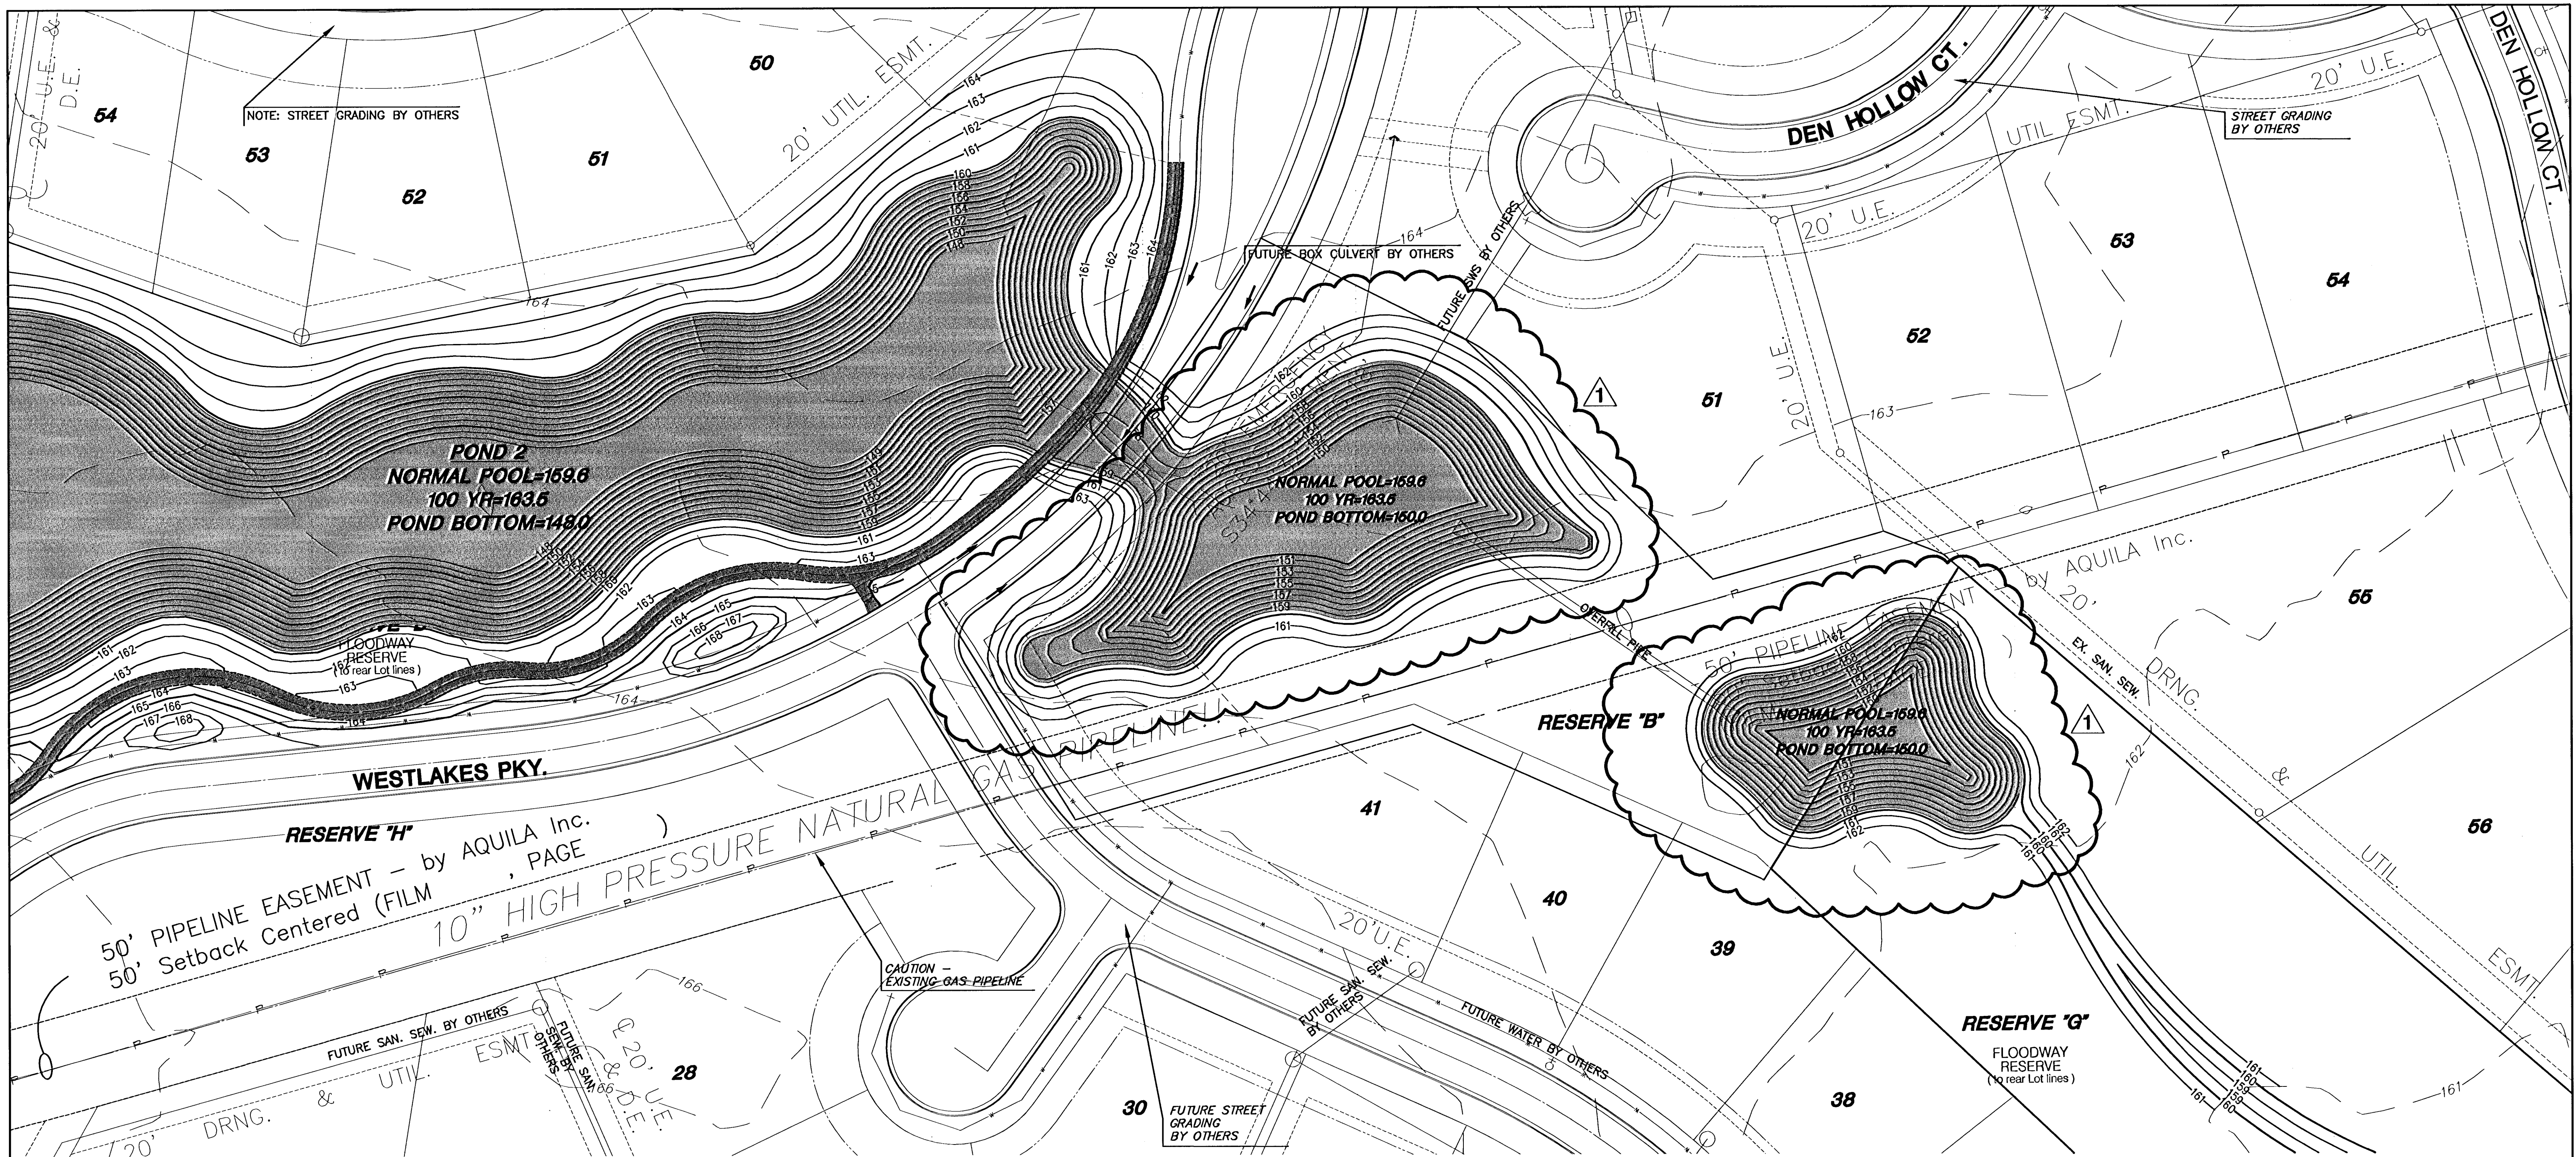


KEY

EARTHWORK SUMMARY

PHASE 3	
EXCAVATION	135,500 C.Y.
COMPACTED FILL (90% DENSITY)	118,100 C.Y.
COMPACTED FILL (95% DENSITY)	21,100 C.Y.
DITCH EXCAVATION	1,700 C.Y.

NOTE: 20% HAS BEEN ADDED TO FILL QUANTITIES TO ALLOW FOR COMPACTION.

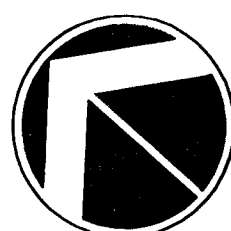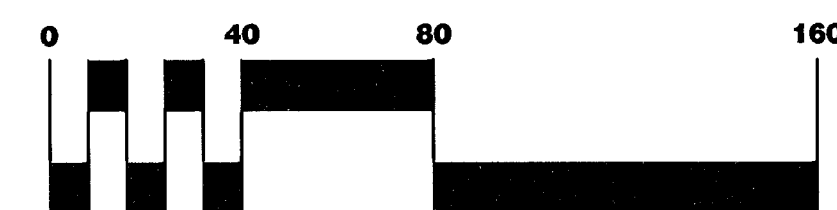

LEGEND

— W —	— WATER LINE
— S —	— SAN. SEWER LINE
— 1.355 —	— EXIST. CONTOURS
— 1.355 —	— PROP. CONTOURS
■■■■■■■■■■	— LIMITS OF POND GRADING
— — — — —	— ADD ALTERNATE #1

1 REVISED - SEPTEMBER 15, 2004

REVISED POND GRADES REFLECT THE ORIGINAL EARTHWORK QUANTITY AS SET AT BID. POND CONTOURS REVISED WITH A REDUCE DEPTH OF POND BY 2 FEET. NEW POND DEPTH SHALL BE ELEV.=150.00

G:\CIVIL\99118\dwg\Grad\Ph-3\LAKE\LAKE_GRD_2a.dwg 09/15/2004 10:47:01 AM CST



FOX RIDGE
PROJECT NAME

PHASE 3 LAKE GRADING - PONDS
SHEET TITLE

SRS/DG DESIGN BY:	DM DRAWN BY:	GJA CHECKED BY:
MAY 2004 DATE	LAK_GRD_2 JOB NO.	6 / 16 SHEET/OF