



PLAN	CHECKED	DATE

PROFILE	CHECKED	DATE

DSNR: OPER ILS SCALE: 1"=40.00
Q:\2004\04442\001\sspp03 03-27-2004 02:25:27 pm

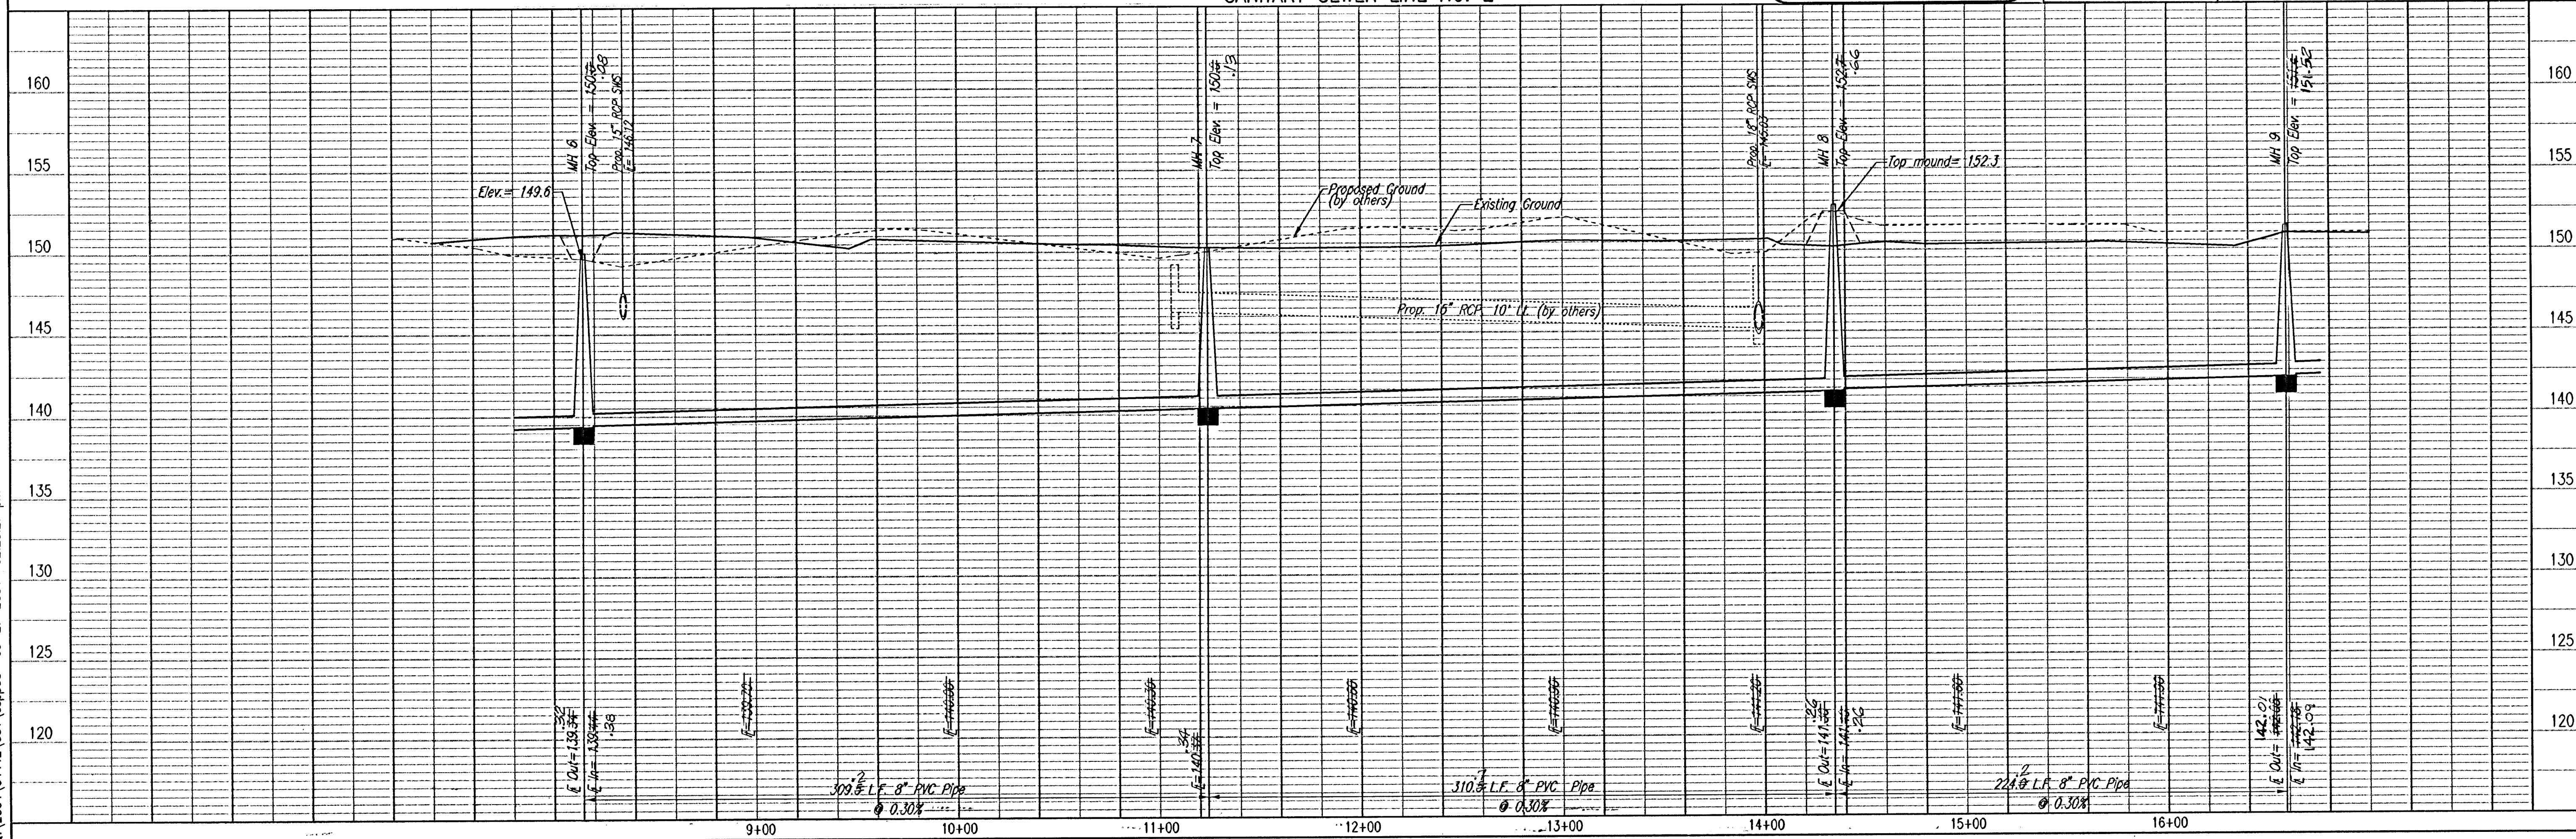

SANITARY SEWER LINE NO. 2

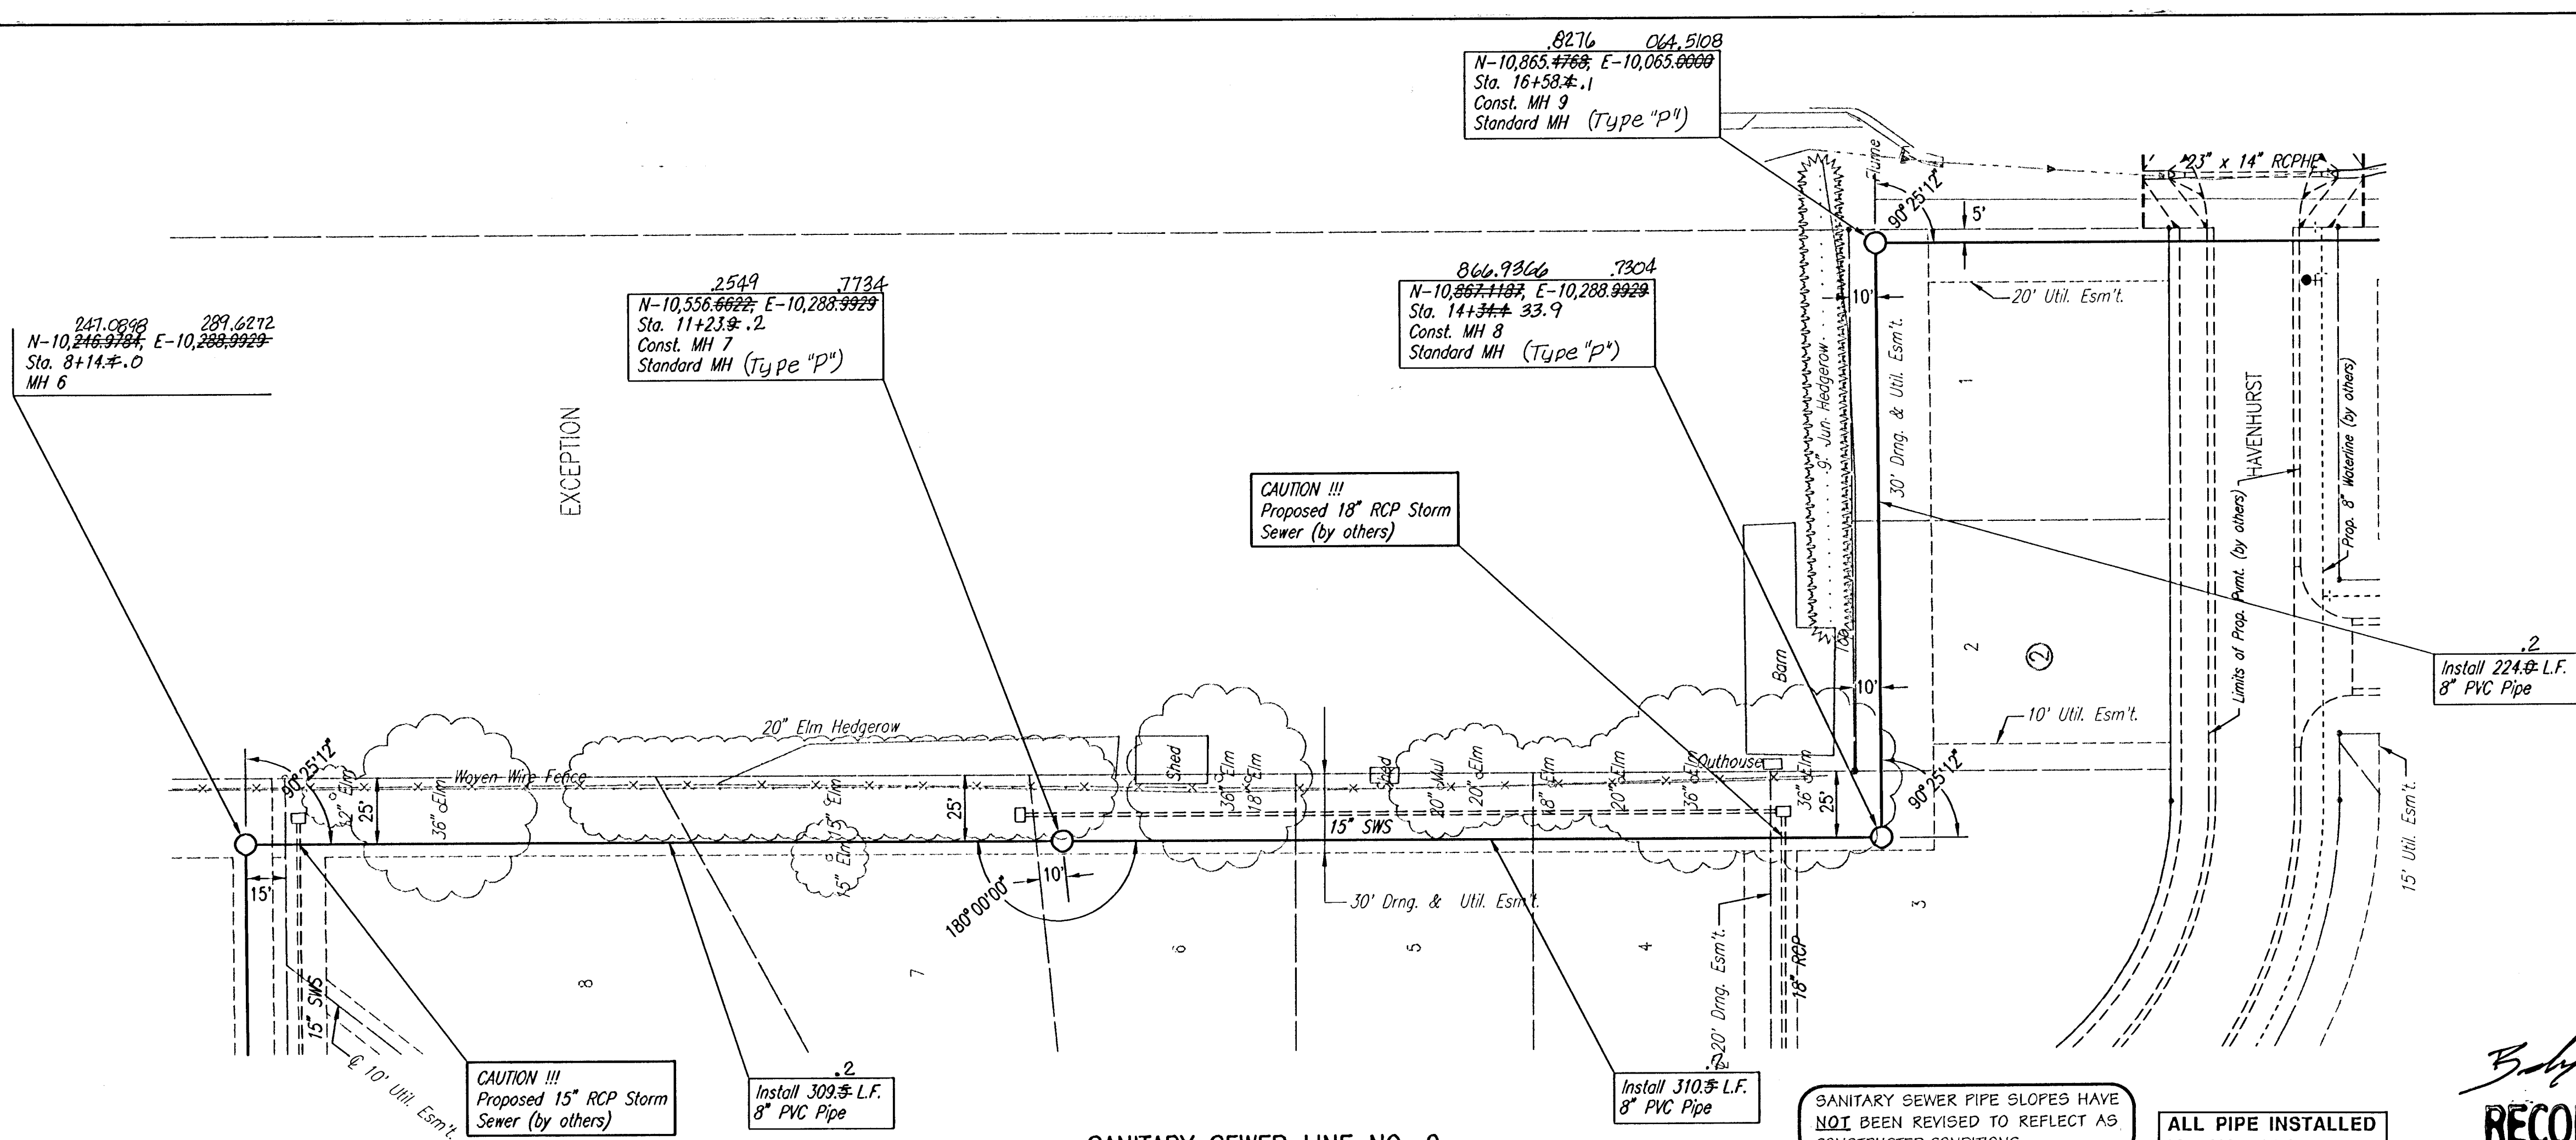

SCALE: 0 40 80
PLAN: LAT. & LONG.
PROFILE: HORIZ. SAME AS ABOVE
VERT. 0 5



RECORD DRAWING
23 JUL 05

SANITARY SEWER PIPE SLOPES HAVE NOT BEEN REVISED TO REFLECT AS CONSTRUCTED CONDITIONS.
ALL PIPE INSTALLED IS PVC PIPE.

Professional Engineering Consultants, P.A.
303 S. TORREY WICHITA, KANSAS 67202
316-262-2601 • FAX 316-262-3003

Sanitary Sewer Line No. 2
LATERAL 16, MAIN 19 OF THE
SOUTHWEST INTERCEPTOR SEWER

James L. Armour, P.E., Acting City Engineer
City of Wichita Project No. 445-5748

Job No. 35-04442-001-042
Date July 2004

Designed By MDK
Drawn By JCA

Sheet 6 of 17