


PLAN	CHECKED	DATE

PROFILE	CHECKED	DATE

DSNR: OPER. ILS SCALE: 1"=40.00
Q:\2004\04442\001\sspp04 08-27-2004 02:26:51 pm

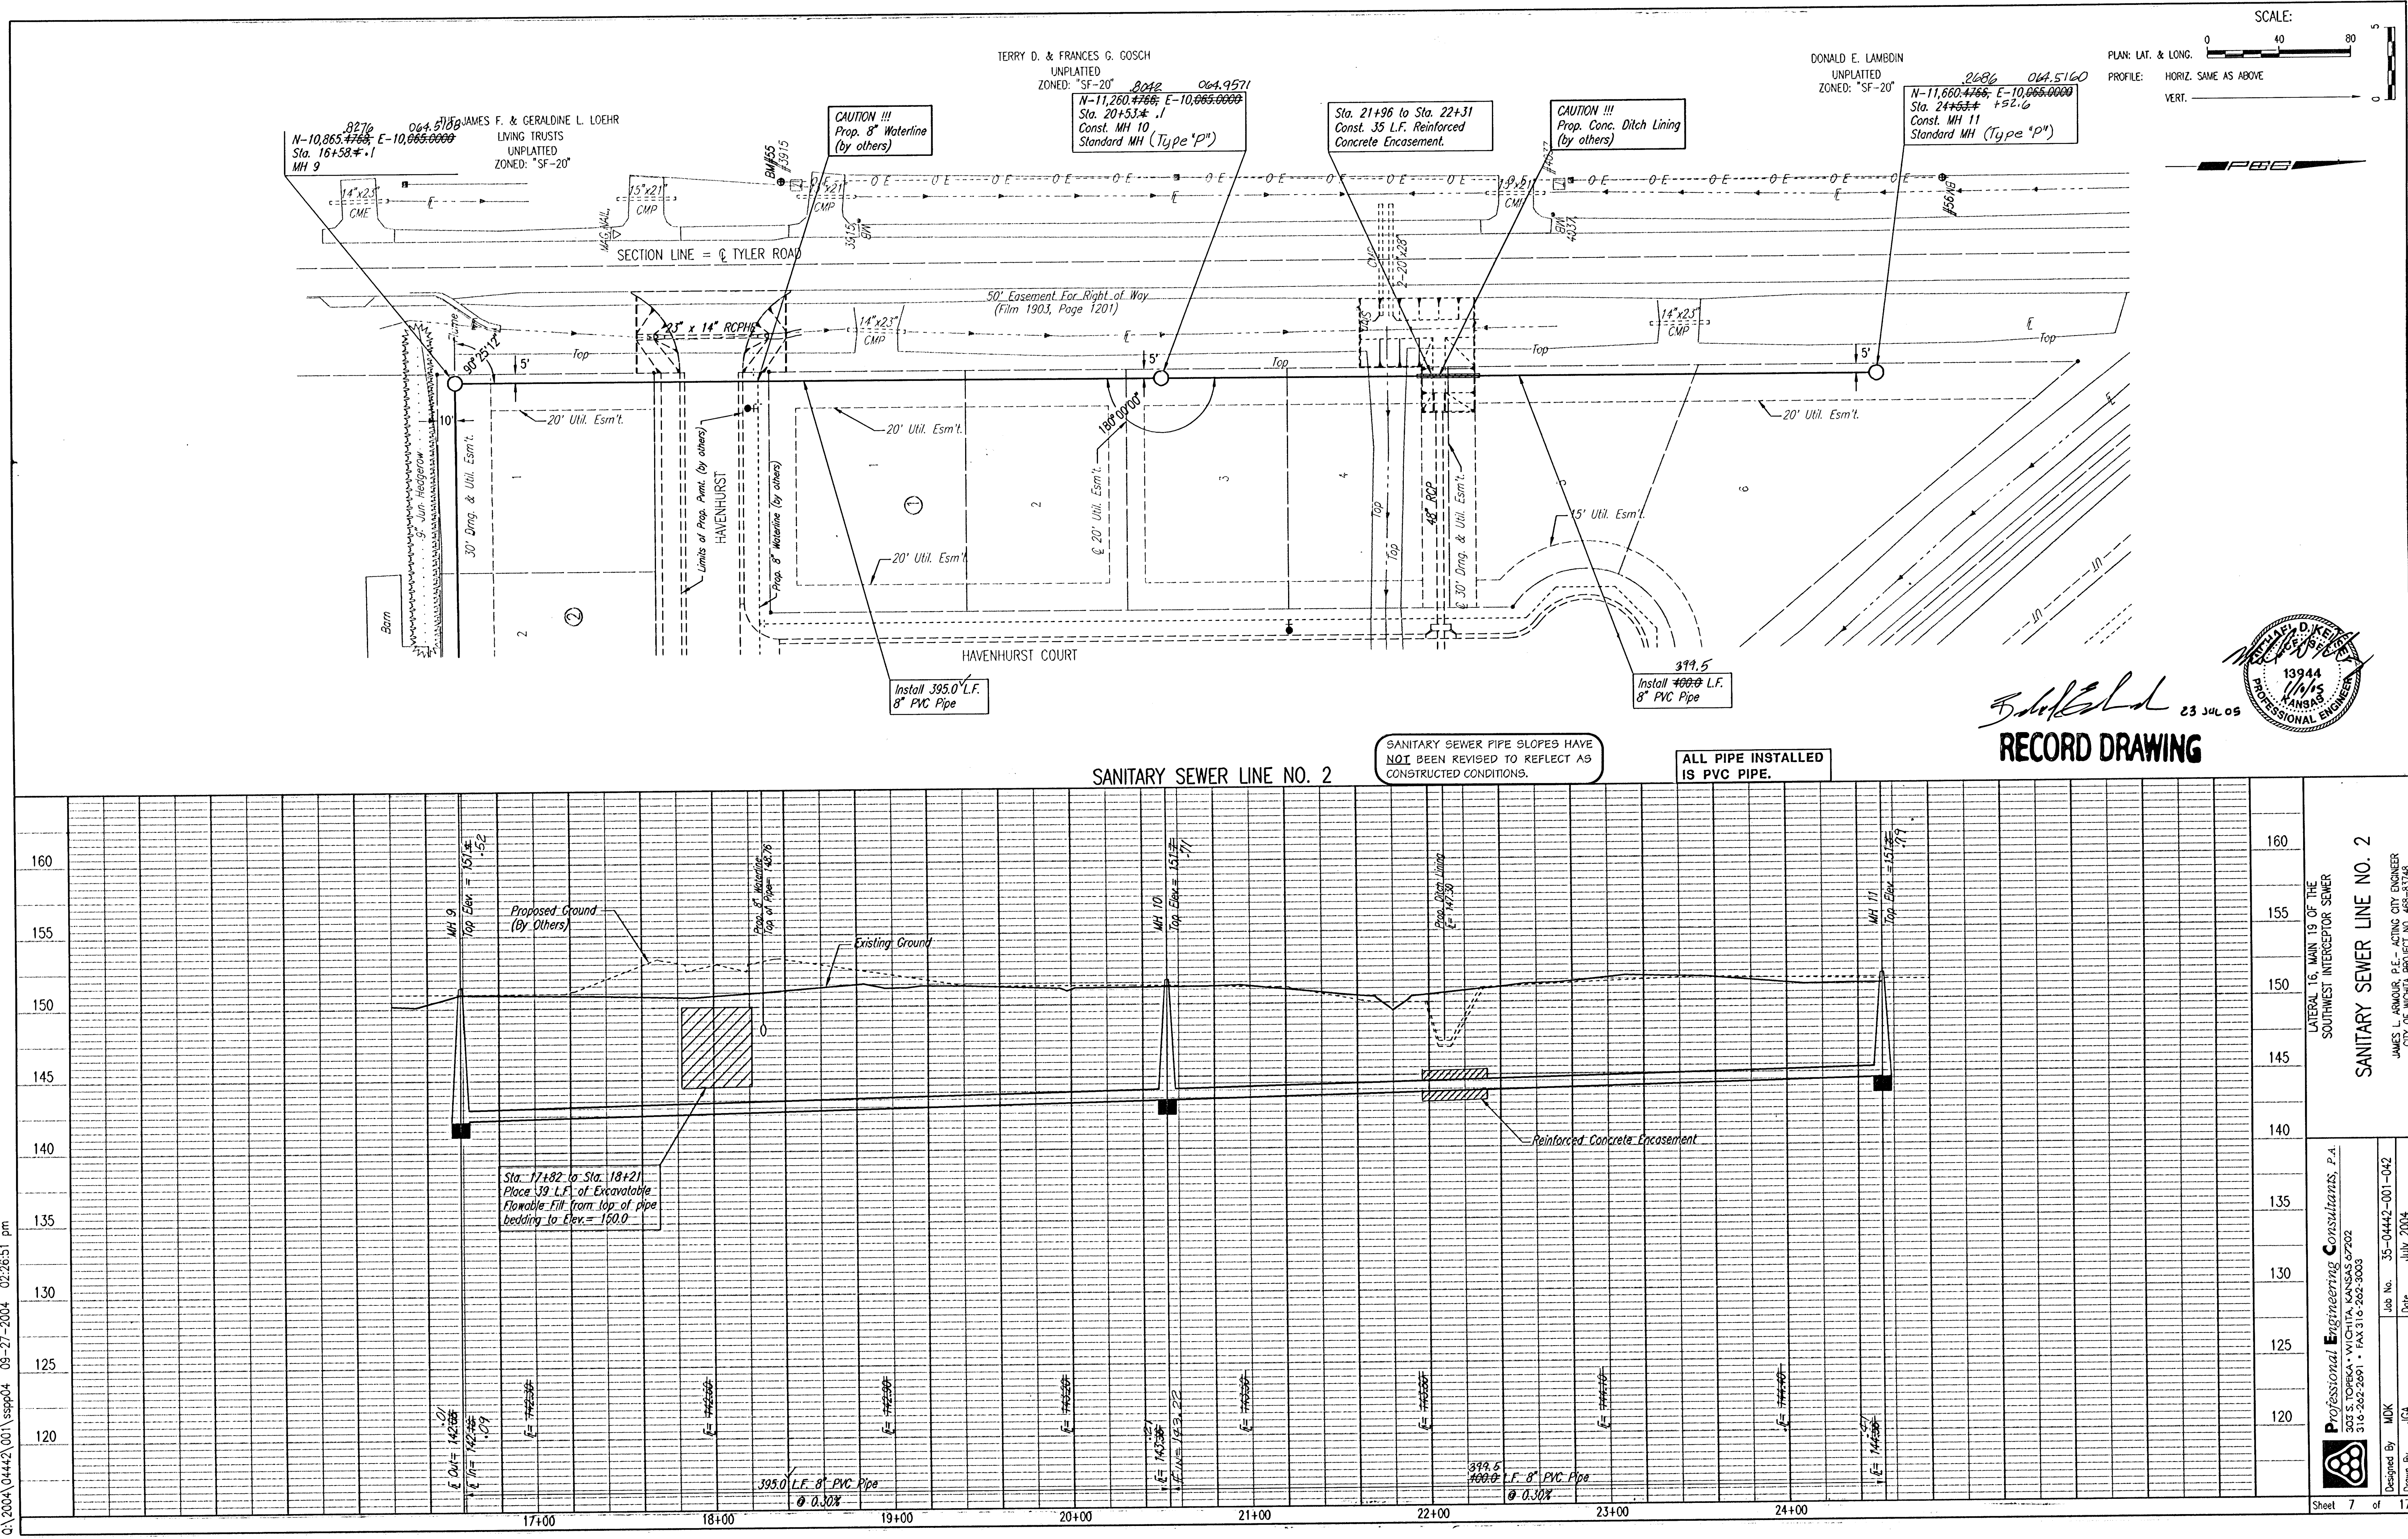

RECORD DRAWING

SANITARY SEWER LINE NO. 2

LATERAL 16, MAIN 19 OF THE
SOUTHWEST INTERCEPTOR SEWER

Professional Engineering Consultants, P.A.
303 S. TOPICKA • WICHITA, KANSAS 67202
316-262-2691 • FAX 316-362-3063

Designed By: MDK
Drawn By: JCA

Job No.: 35-04442-001-042
Date: July 2004

Sheet 7 of 17