



PLAN	CHECKED	DATE

PROFILE	CHECKED	DATE

DSNR: OPER. ILS SCALE: 1"=40.00
 C:\2004\04442\001\sspp06 09-27-2004 02:29:57 pm

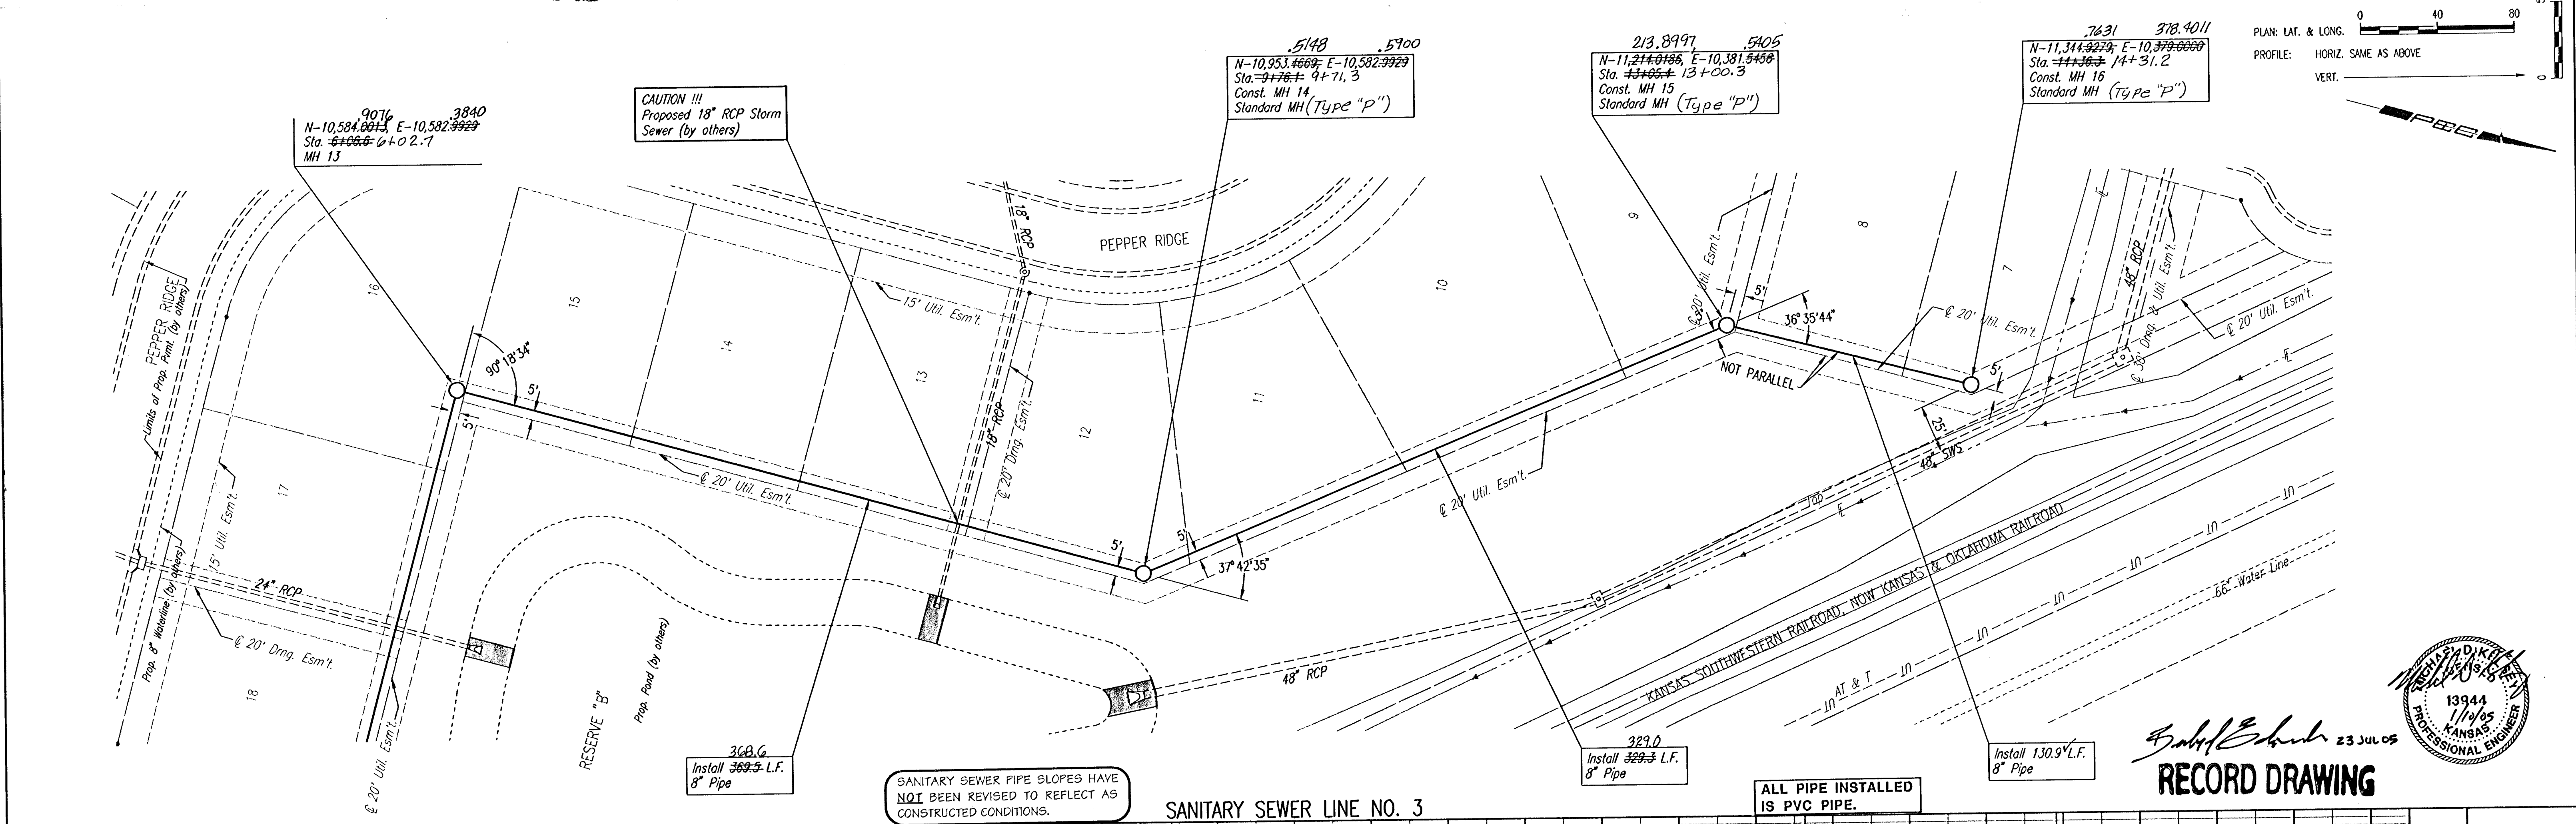

RECORD DRAWING
 23 JUL 05

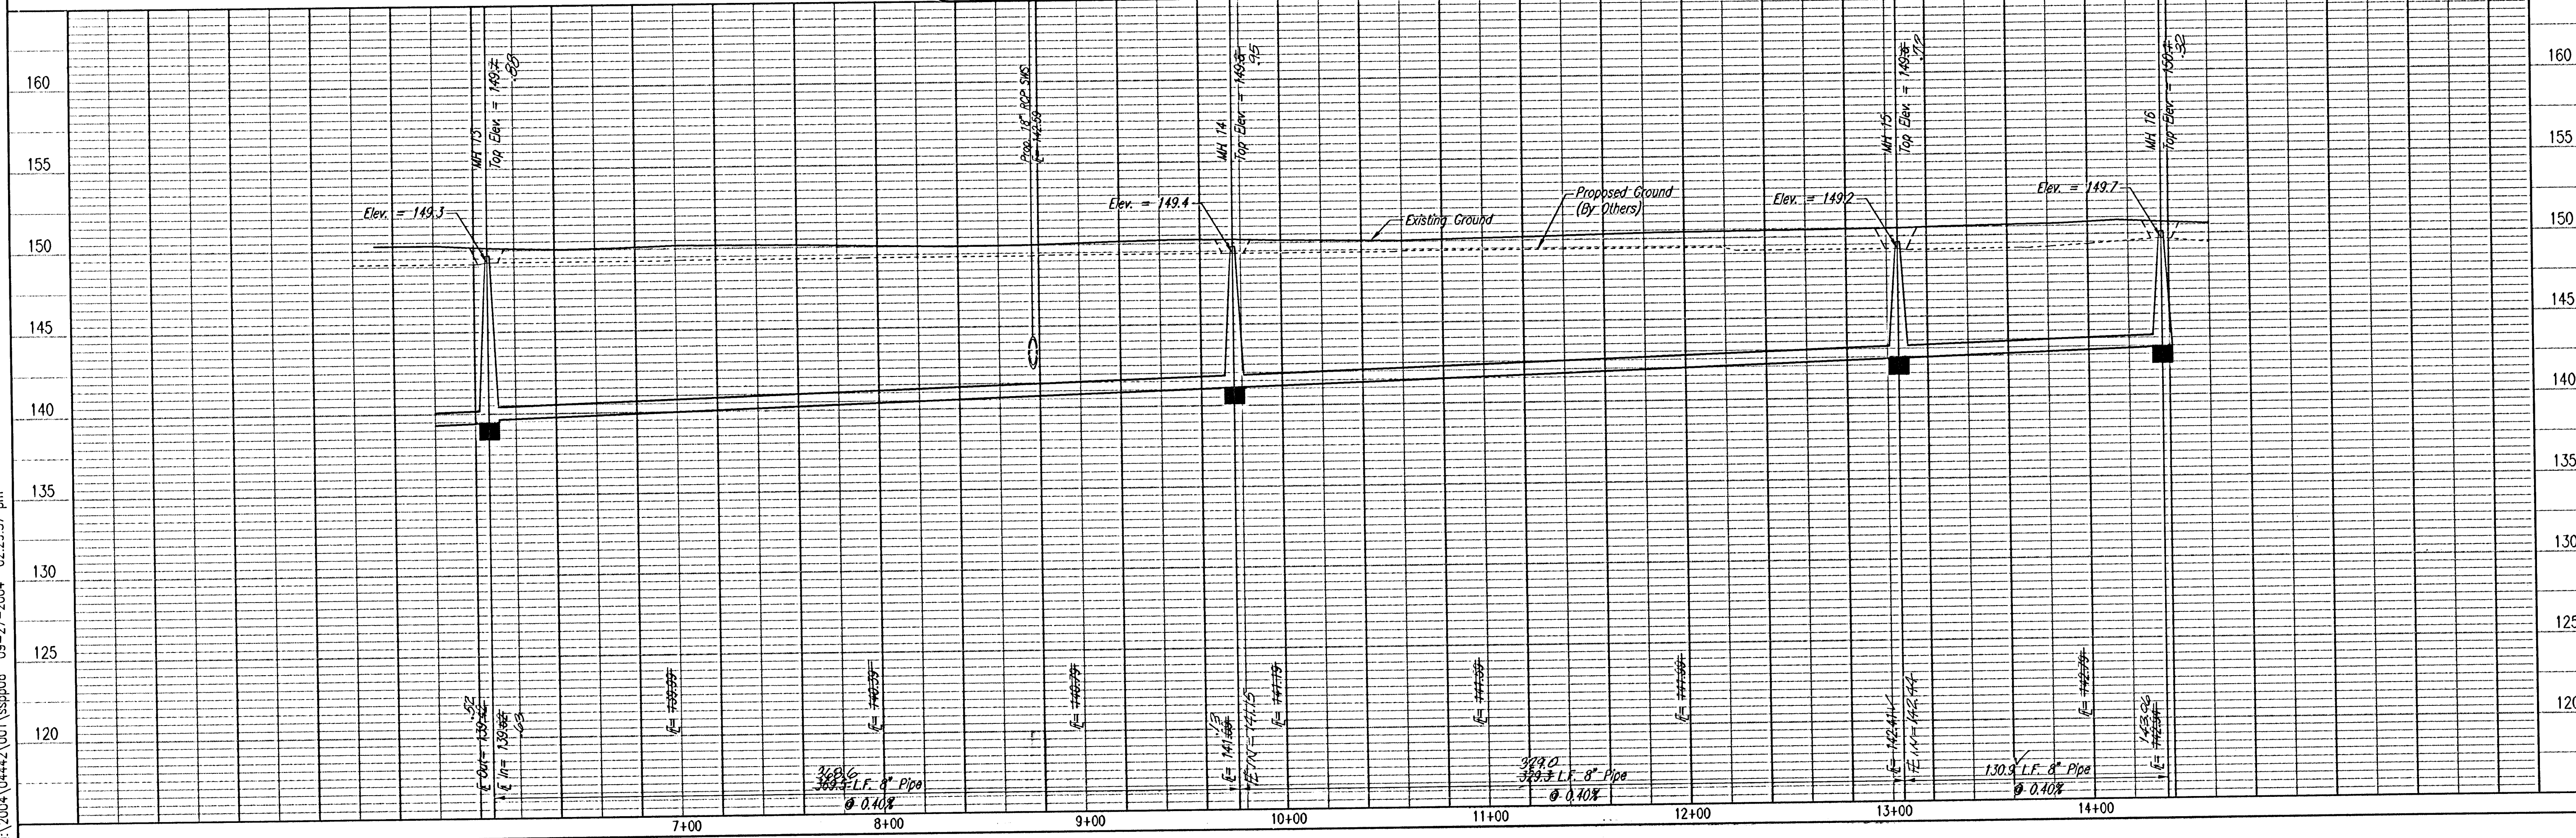

Professional Engineering Consultants, P.A. 303 S. TOPICKA • WICHITA, KANSAS 67202 316-262-2691 • FAX 316-262-3065	
Designed By: MDK	Job No.: 35-04442-001-042
Drawn By: JCA	Date: July 2004
Sheet 9 of 17	

SANITARY SEWER LINE NO. 3
 LATERAL 16, MAIN 19 OF THE
 SOUTHWEST INTERCEPTOR SEWER

JAMES L. ARMOUR, P.E. - ACTING CITY ENGINEER
 CITY OF WICHITA PROJECT NO. 483-87748