
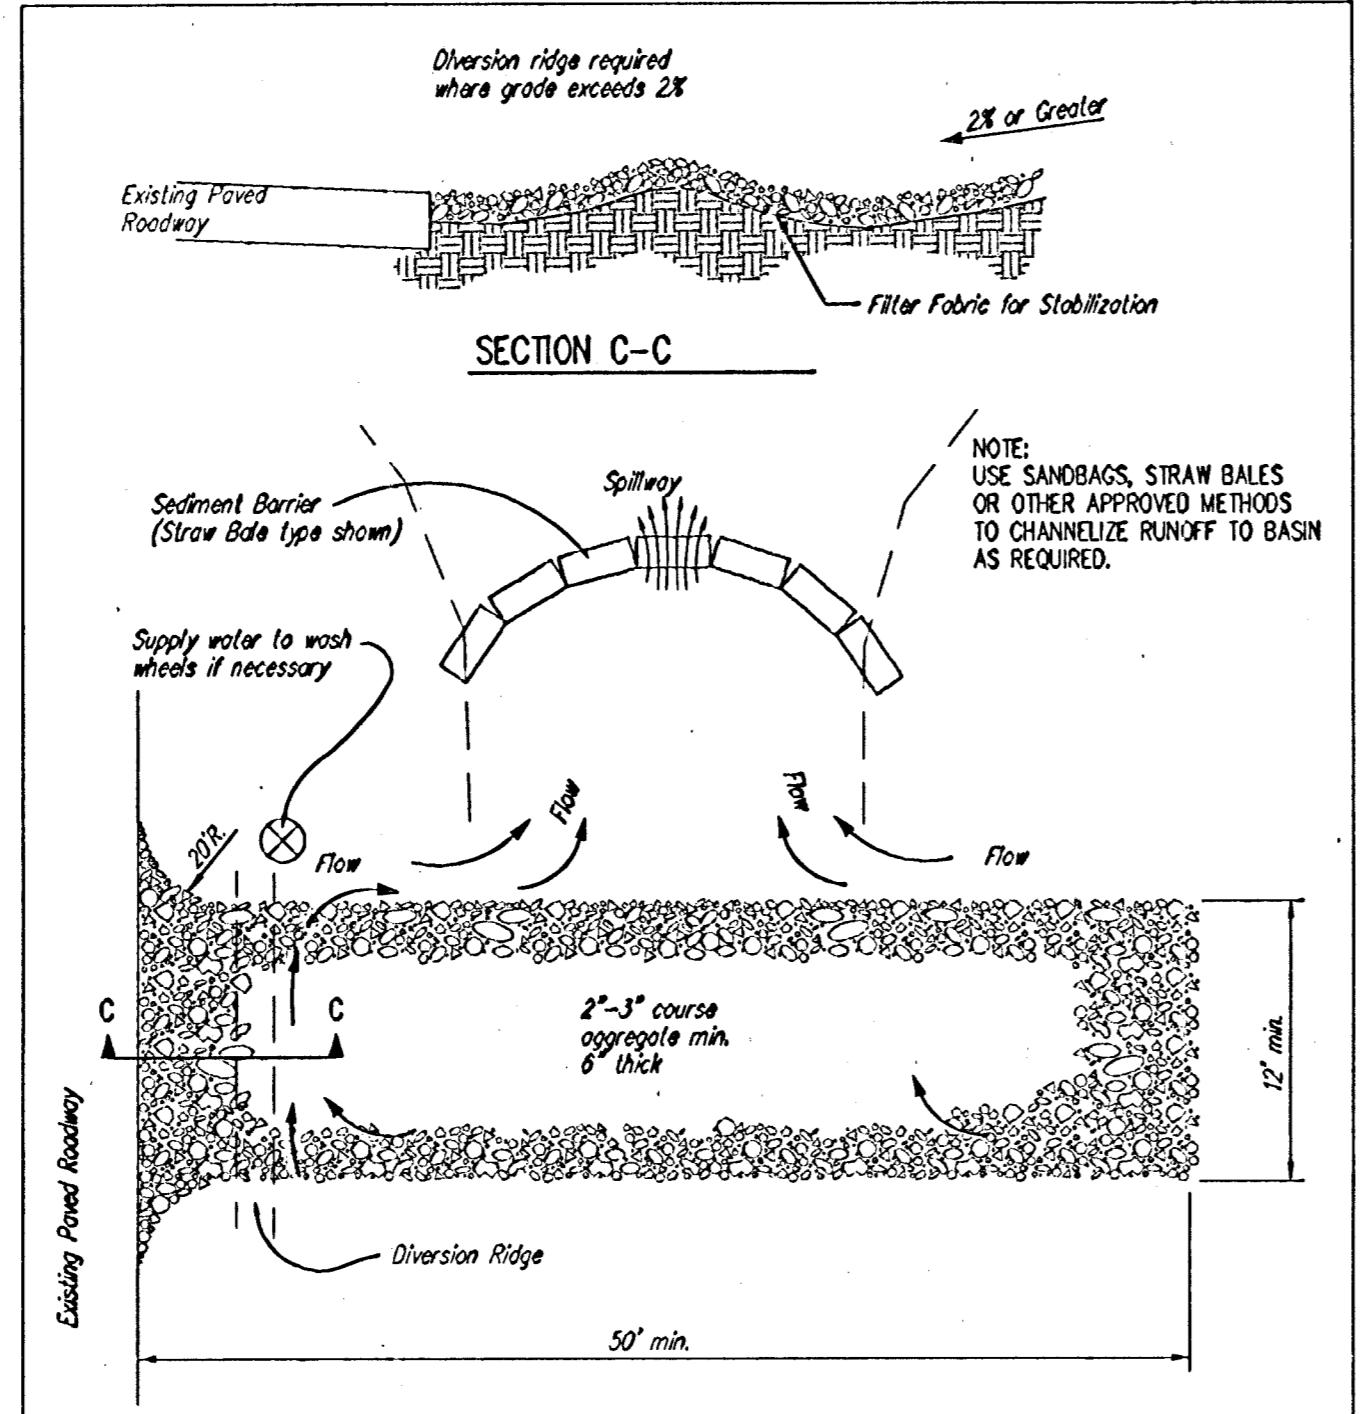


Scale:
 1" = 40' Horizontal
 • = Iron

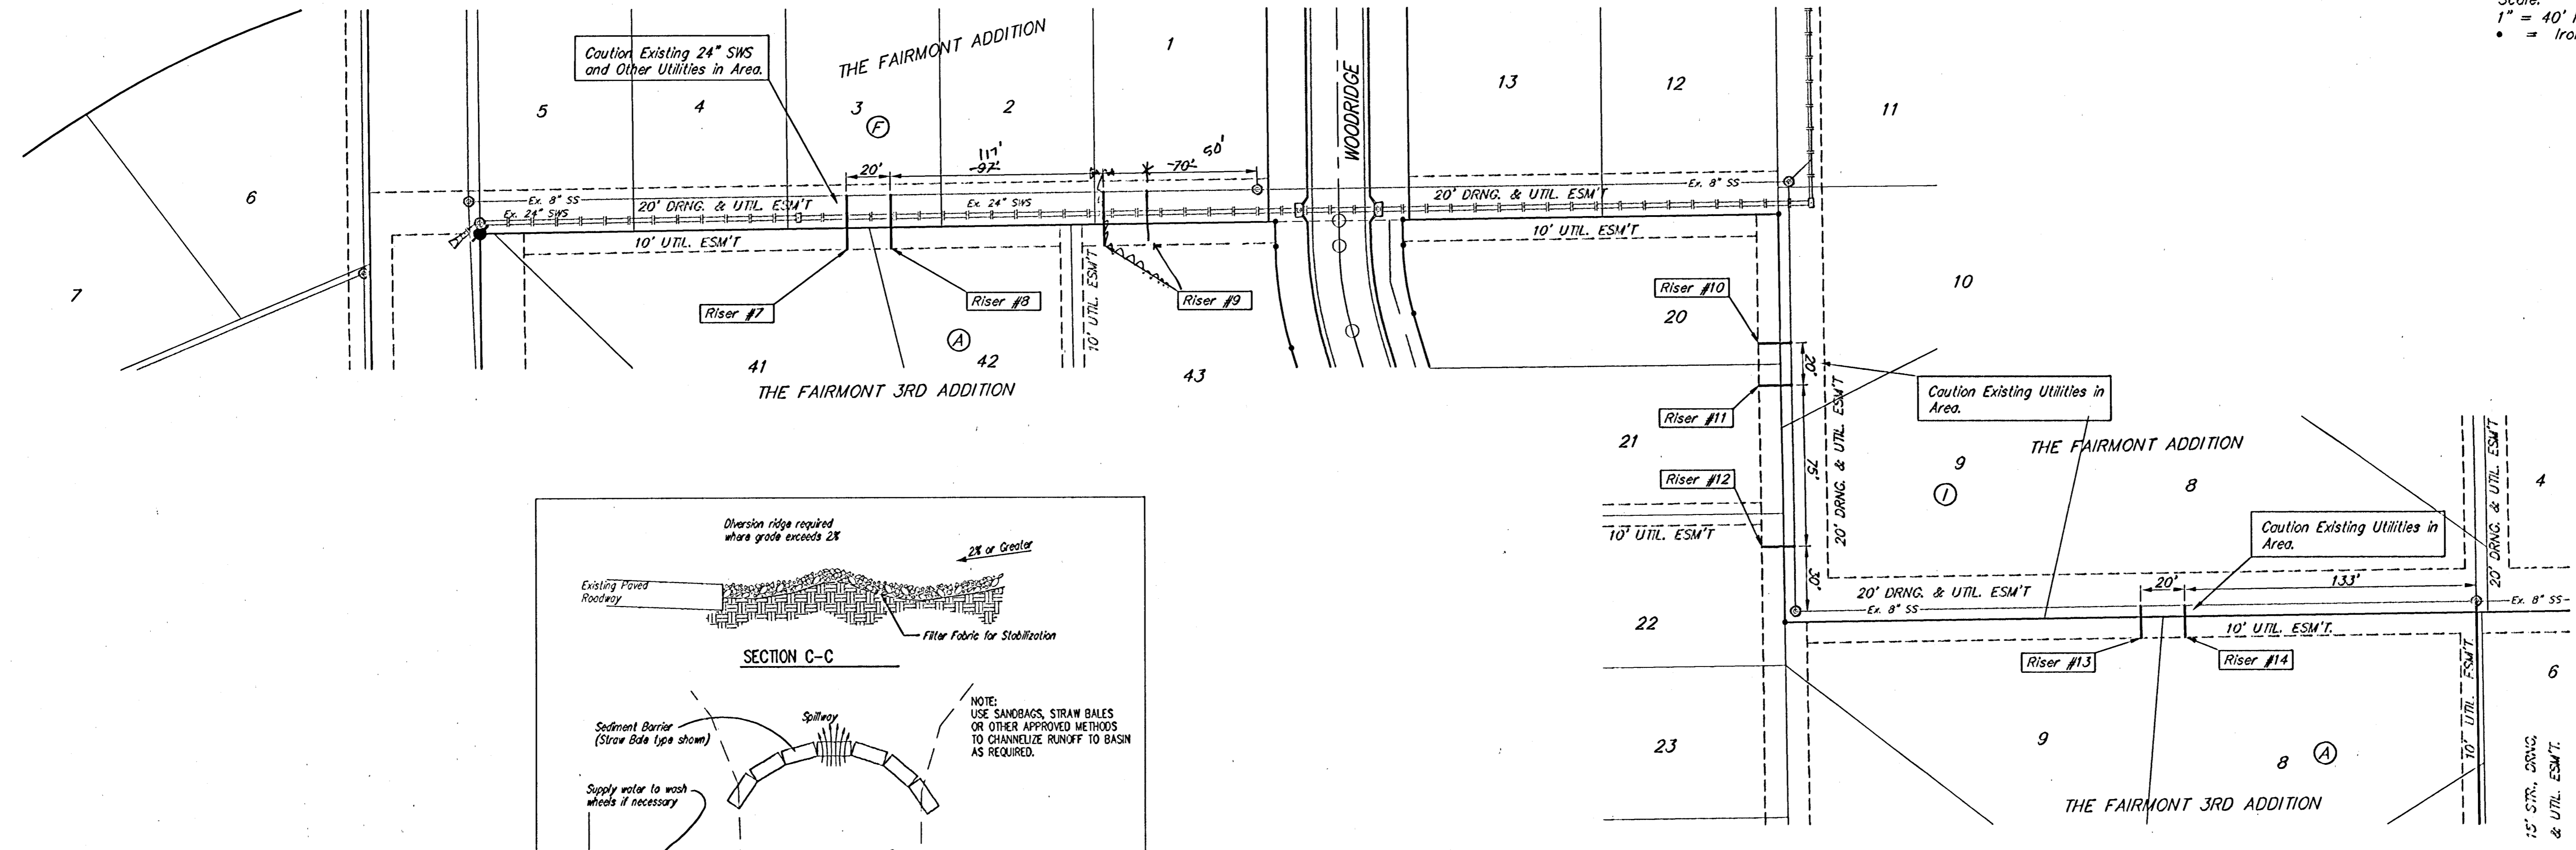

- NOTES:
1. THE ENTRANCE SHALL BE MAINTAINED IN A CONDITION THAT WILL PREVENT TRACKING OR FLOWING OF SEDIMENT ONTO PUBLIC RIGHTS-OF-WAY. THIS MAY REQUIRE TOP DRESSING, REPAIR AND/OR CLEANOUT OF ANY MEASURES USED TO TRAP SEDIMENT.
 2. WHEN NECESSARY, WHEELS SHALL BE CLEANED PRIOR TO ENTRANCE ONTO PUBLIC RIGHT-OF-WAY.
 3. WHEN WASHING IS REQUIRED, IT SHALL BE DONE ON AN AREA STABILIZED WITH CRUSHED STONE THAT DRAINS INTO AN APPROVED SEDIMENT TRAP OR SEDIMENT BASIN, AS SHOWN ABOVE.
 4. DRIVE ENTRANCES ONTO RESIDENTIAL LOTS WILL NOT BE REQUIRED TO HAVE THE SEDIMENT BARRIER SHOWN, BUT WHEEL WASHING MAY BE REQUIRED IF STABILIZED ENTRANCE IS NOT SUFFICIENT TO KEEP MUD FROM BEING TRACKED ONTO ADJACENT STREET. ENTRANCE SHALL EXTEND FROM BACK OF CURB TO DWELLING.

Contractor to verify depth & location of existing sanitary sewer line and utilities prior to construction.

SEWER SERVICE TABLE

NUMBER	TYPE	LOCATION			FOR INFORMATION ONLY	
		LOT NO.	BLOCK NO.	LINE NO.	STATION/DIRECTION	APPROXIMATE LENGTH 4" PIPE
7	8" X 4" Tee Saddle	41	A	Existing	Right	16.5' 25.0'
8	8" X 4" Tee Saddle	42	A	Existing	Right	16.5' 25.0'
9	8" X 4" Tee Saddle	43	A	Existing	Right	16.5' 75.0'-15.0'
10	8" X 4" Tee Saddle	20	A	Existing	Right	16.5' 15.0'
11	8" X 4" Tee Saddle	21	A	Existing	Right	16.5' 15.0'
12	8" X 4" Tee Saddle	22	A	Existing	Right	16.5' 15.0'
13	8" X 4" Tee Saddle	9	A	Existing	Right	16.5' 15.0'
14	8" X 4" Tee Saddle	8	A	Existing	Right	16.5' 15.0'

NOTE: Vertical Riser Pipe shall be extended to 2' minimum above ground water elevation and 4' maximum below proposed ground elevation. Contractor shall use method "B" for riser construction. (See Detail, Sheet 10)

As Built 4/12/05 KK

THE FAIRMONT 3rd
RISER PLAN
 SANITARY SEWER IMPROVEMENTS

BAUGHMAN COMPANY P.A.
 ENGINEERING, SURVEYING, & PLANNING
 314-262-7271 • 315 ELLIS • WICHITA, KANSAS 67211

DESIGN A/D	DRAWN DSM	APPROVED	DATE 12/04	SCALE NOTED	SHEET 7 OF 16
------------	-----------	----------	------------	-------------	---------------