

BENCHMARK:
Arkansas River bridge & 63rd St. S. City of
Wichita Benchmark Disc. SW Cor. of bridge,
top of hubguard, 500'± E. of Grove.
Elev. = 1269.95 NGVD29 (per City record)

Brass plate on the NE wingwall of Arkansas
River bridge & 63rd St. S.
Elev. = 1267.48 NGVD29 (per County record)

Sta. 0+76.1, Line 2
Const. Special Reinf. Conc.
Manhole. (8'x8' O.D.) w/
grated lid (Neenah R-2501
or equivalent)
Top Elev. = 1252.80

Construct Erosion Control
Straw Bale Barrier Around
Inlet. See Detail, Sheet 28

Sta. 2+52.9, Line 2
Const. Std Type-1A Double
Curb Inlet. (10' x 3')
Top Elev. = 1258.00

Sta. 2+94.2, Line 2
Const. Std Type-1A Double
Curb Inlet. (10' x 3')
Top Elev. = 1258.00
Match Point

CAUTION!
2" Gas Line
Crossing

CLIFTON COVE ADDITION


POND DATA:
STATIC POOL ELEVATION: 1246.6 NGVD29
100 YEAR DWS: 1256.0 NGVD29

RESERVE "B"

Sta. 0+76.8, Line 2
Begin Construction of 60"
RCP w/ 60" Reinf. Concrete
Headwall and 58 S.Y. light
stone rip-rap.

Remove Existing Trees Only as ABSOLUTELY
Necessary For Construction. Trees Not in
Direct Conflict With Proposed New
Construction Shall Remain And Be Protected
From Damage. Cost to be Included in Bid
Item "Site Clearing & Restoration"

SCALE:
1" = 20' HORIZONTAL
1" = 5' VERTICAL
• = IRON

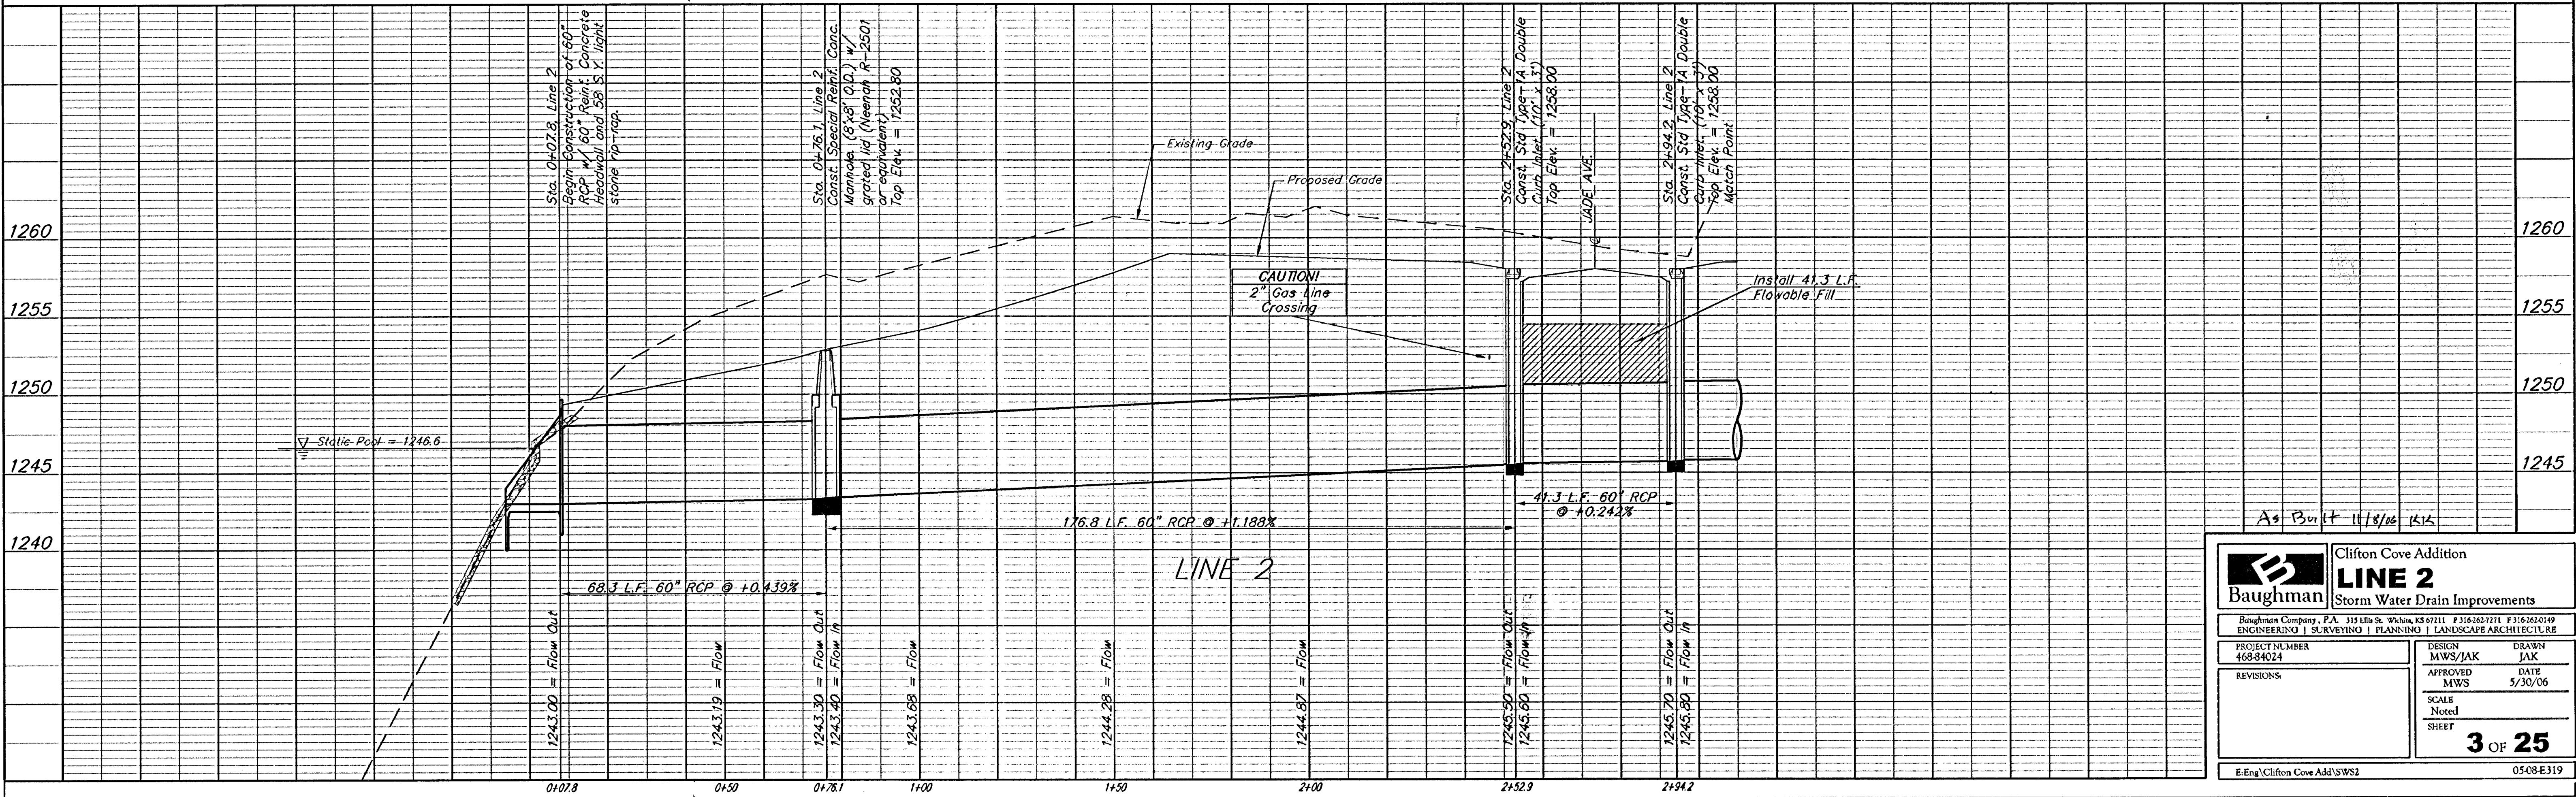

As Built 11/8/06 JAK

Baughman		Clifton Cove Addition LINE 2 Storm Water Drain Improvements	
Baughman Company, P.A. 315 Ellis St. Wichita, KS 67211 P 316-262-7271 F 316-262-0149 ENGINEERING SURVEYING PLANNING LANDSCAPE ARCHITECTURE			
PROJECT NUMBER 46894024		DESIGN JAWS/JAK	DRAWN JAK
REVISIONS:		APPROVED MWS	DATE 5/30/06
		SCALE Noted	SHEET 3 OF 25
E:\Eng\Clifton Cove Add\SWSI		05-08-E319	