

1000 North 127th East Avenue

North Golf Course  
South Golf Course

# Crestview Country Club

Wichita, Kansas

## AS BUILT RECORD COMPOSITE IRRIGATION LAYOUT


South Course

FOR INFORMATION  
PURPOSES ONLY  
NOT TO SCALE

### IRRIGATION LEGEND


- Existing Sprinkler Head (Not To Be Replaced)
- Rain Bird Model 510S/51DR; Nozzle Set 18x11.5
- Rain Bird Model 47DS; Nozzle Set 16
- Rain Bird Model 910S/91DR; Nozzle Set 13/32x15/64
- △ Existing Quick Coupler Valve
- Rain Bird EFA Series Remote Control Valve (Not To Be Replaced)
- Rain Bird PES-PRS Remote Control Valve (Part of System Expansion)
- Existing TH Type Valve - To Be Replaced By Rain Bird PES-PRS Series
- ☐ Rain Bird SBM-1230-SS Satellite Controller (Designated By Path & Device #)
- ms- Controller/Station Valve Assignment
- \* Designates Station & Heads Assigned To MSR-4 Multi-Station Relay
- x Existing Manual Drain Valve
- x Isolation Valve
- Underground Wire Path
- Main Line Isolation Valve; Cast Iron, ANWA Standards; Full Line Size
- Property Line or Road Centerline
- Irrigation Main Pipe Line; Size As Noted; Gasket Joints
- Irrigation Sub-Main Pipe Line; Size Per Specifications; Solvent Weld Joints
- Combination Air/Vacuum Relief Valve; Location Approximate; Best Sited Location To Be Selected During Installation
- Stream Bed or Lake Shoreline

0 100 200  
SCALE IN FEET

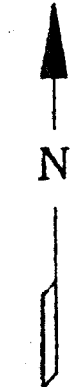

DSNR: OPER JGA SCALE: 1=100.00  
C:\2002\02633\Irrigation Map South 09-22-2004 05:51:51 pm

NEWCREST.DWG  
ASBUILT,  
May 7, 1991

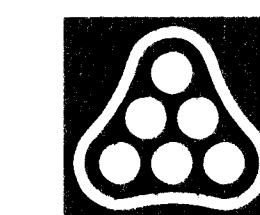

No.	Revision	By	Date
MAIN 17, FOUR MILE CREEK CRESTVIEW SEWER - PHASE 1 <b>GOLF COURSE IRRIGATION PLAN</b> <b>SOUTH PORTION</b> JAMES L. ARMOUR, P.E. - ACTING CITY ENGINEER CITY OF WICHITA PROJECT NO. 468-83903 <b>Professional Engineering Consultants, P.A.</b> 303 S. TOPEKA • WICHITA, KANSAS 67202 316-262-2691 • FAX 316-262-3003			
Designed by	MDK	Job No.	35-02633-3697
Drawn by	JGA	Date	JULY 2004
			Sh. 15 of 23