
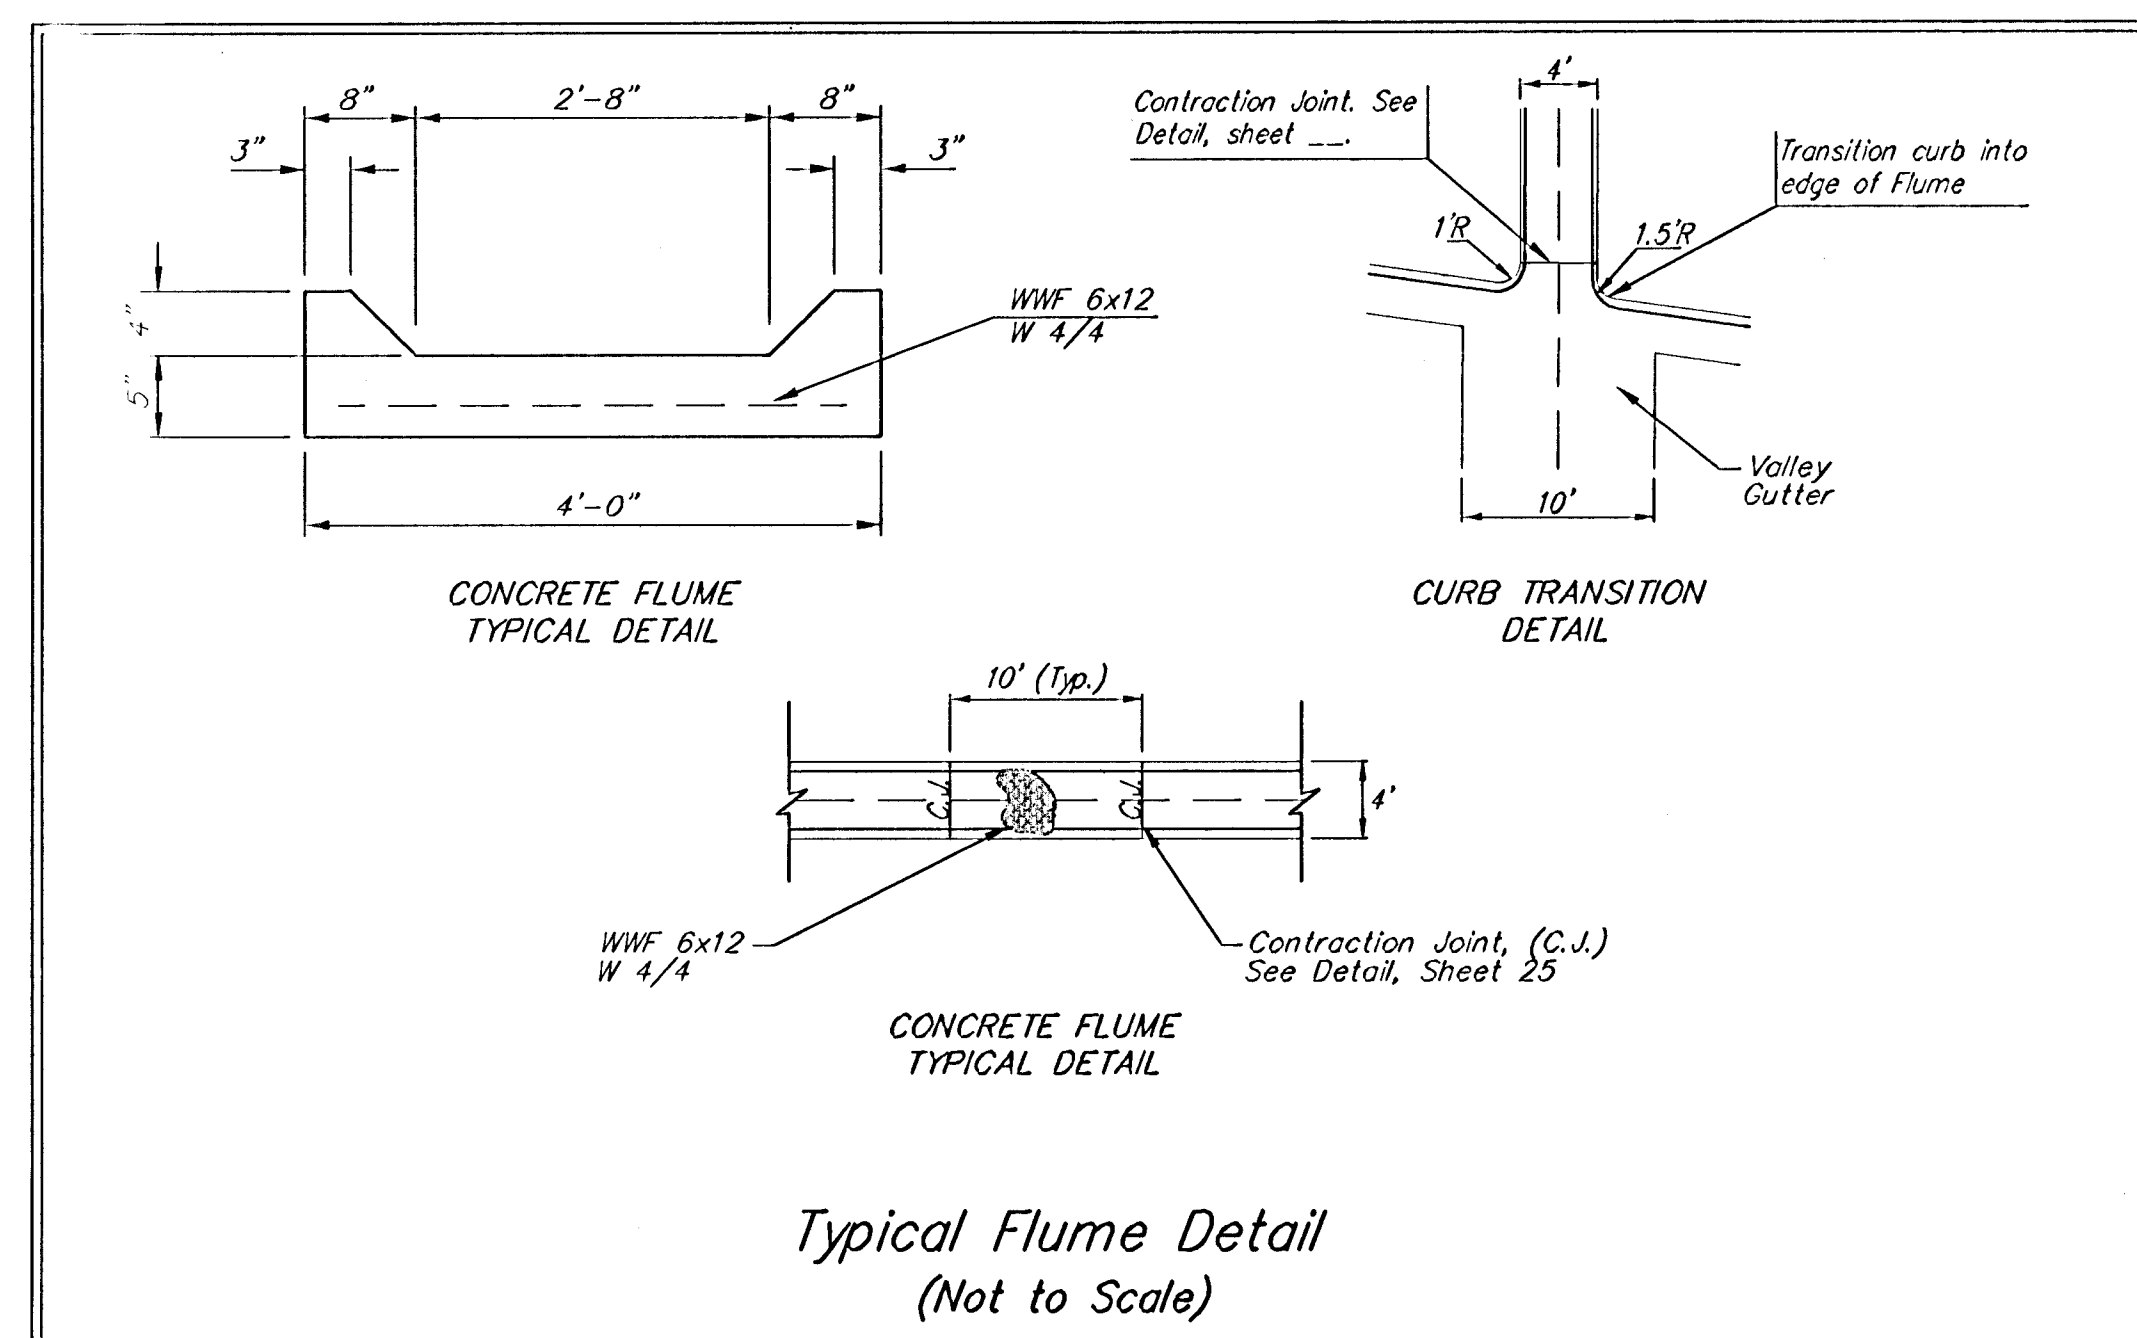


DISC IN BACK OF CURB,
NORTH OF FRONT CORNER
COMMON TO LOTS 23 AND 24,
BLOCK D, AUBURN HILLS 12TH
ADD.
ELEV. = 1379.24 NGVD29

"□" CUT ON CENTER OF
CATCH BASIN, NORTH OF LOT
CORNER COMMON TO LOTS 1
AND 15, BLOCK B, AUBURN
HILLS 14TH ADD.
ELEV = 1381.05 NGVD29

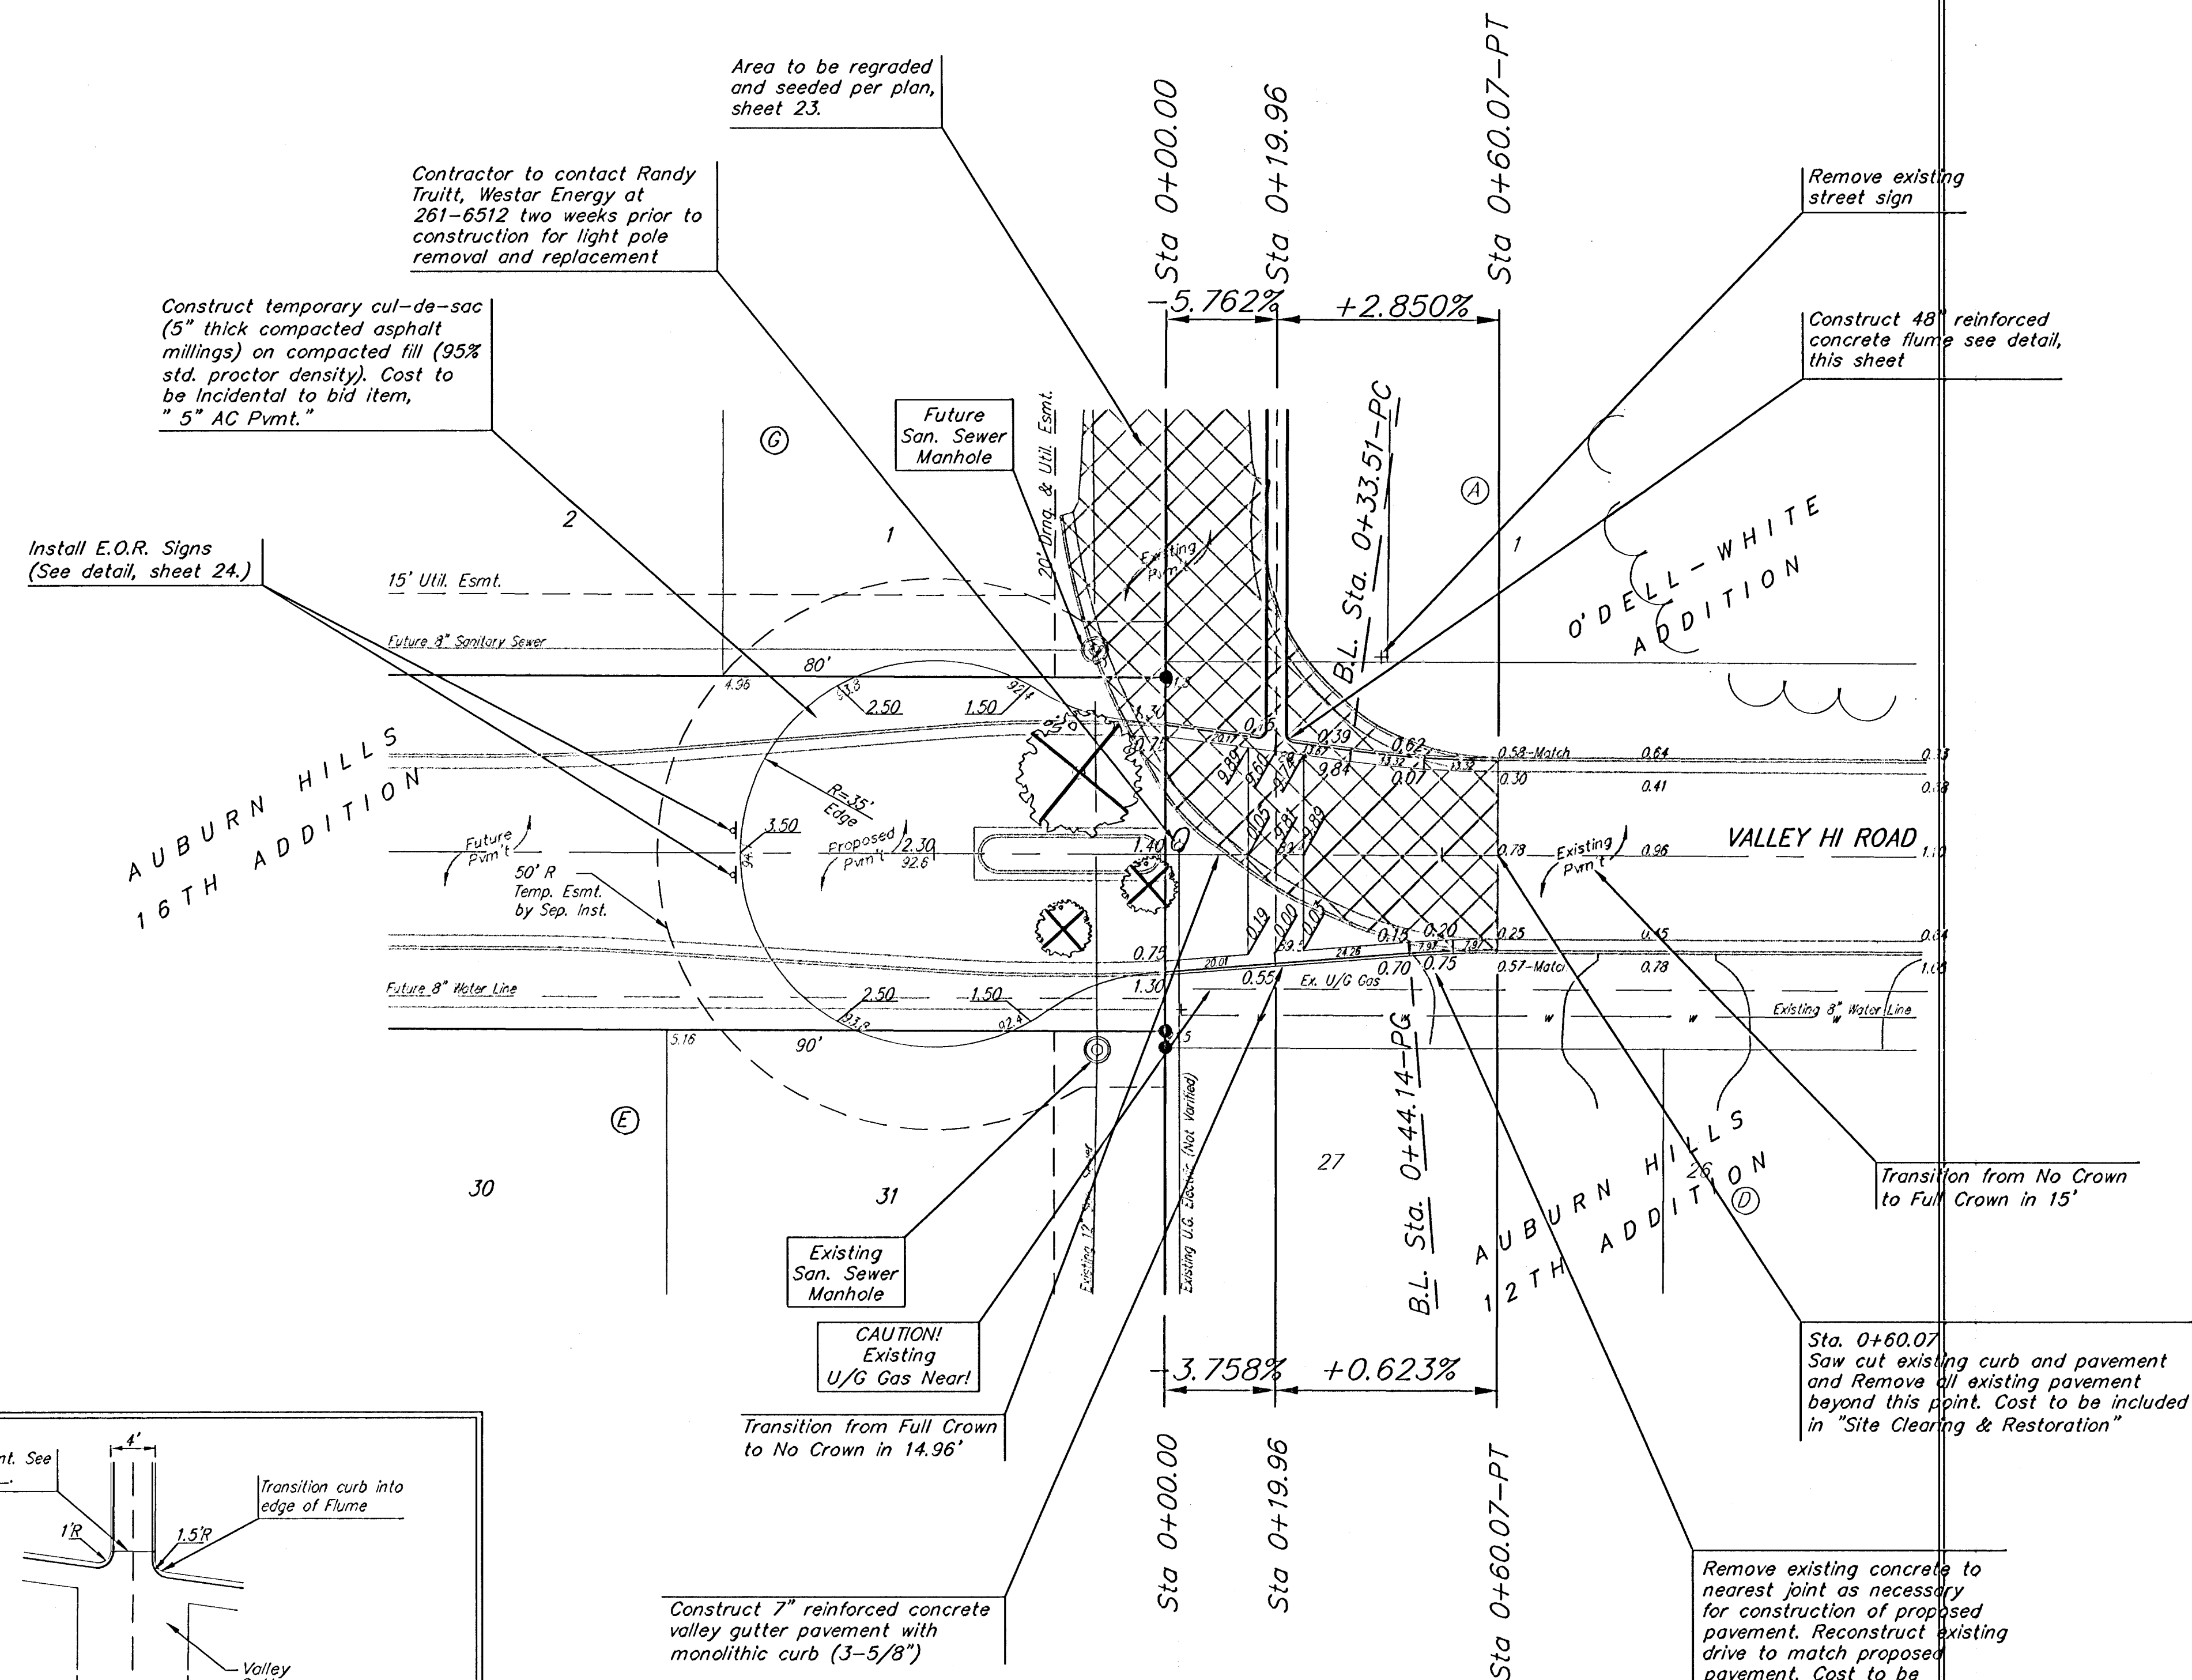

As Built 8/14/06

 Baughman ENGINEERING	Auburn Hills 16th Addition Valley Hi Road Street Plan Storm Water Drain Improvements
	Baughman Company, P.A. 315 Sila St. Wixom, MI 48391 P 313.622.7771 F 313.622.0149 ENGINEERING SURVEYING PLANNING LANDSCAPE ARCHITECTURE
PROJECT NUMBER 468-84092	DESIGN AEG DRAWN RDM APPROVED DATE 03/08/2006 SCALE Noted SHEET
REVISIONS:	22 OF 47