

"□" CUT ON CENTER OF
CATCH BASIN, NORTH OF LOT
CORNER COMMON TO LOTS 1
AND 15, BLOCK B, AUBURN
HILLS 14TH ADD.
ELEV = 1381.05 NGVD29

Scale: 1" = 20'

● = Iron

MAPLE HILL
5TH ADDITION

Leave this portion of existing gravel road undisturbed to be used as private drive

Install type 1 barricade
w/ E.O.R. marker as
shown.
(See detail, sheet 24.)

*Regrade existing
floodway as shown*

Remove existing 4 - 24" RCP. Cost to be included in "Site Clearing and Restoration" (Approx. 250 L.F. 24" RCP)

Install 2 S.Y. Light
Stone Rip Rap

Construct 220 L.F. R.C.
Flume @ 0.750% slope
See detail, sheet 25

Existing light pole
to be removed

Existing U.G. Electric
(Contractor to verify)

CITY VIEW (TO BE VACATED)

AUBURN HILLS
16TH ADDITION


Install W14-2 sign
per detail, sheet 24
at this location

Remove entire gravel road from this point to the South


Remove existing tree
growing over 24" RCP

Remove existing pavement
and curb & gutter. Approx.
655 S.Y. Pavement and
200 L.F. Curb & Gutter

Remove 3 existing trees.
Cost to be included in "Site
Clearing and Restoration"

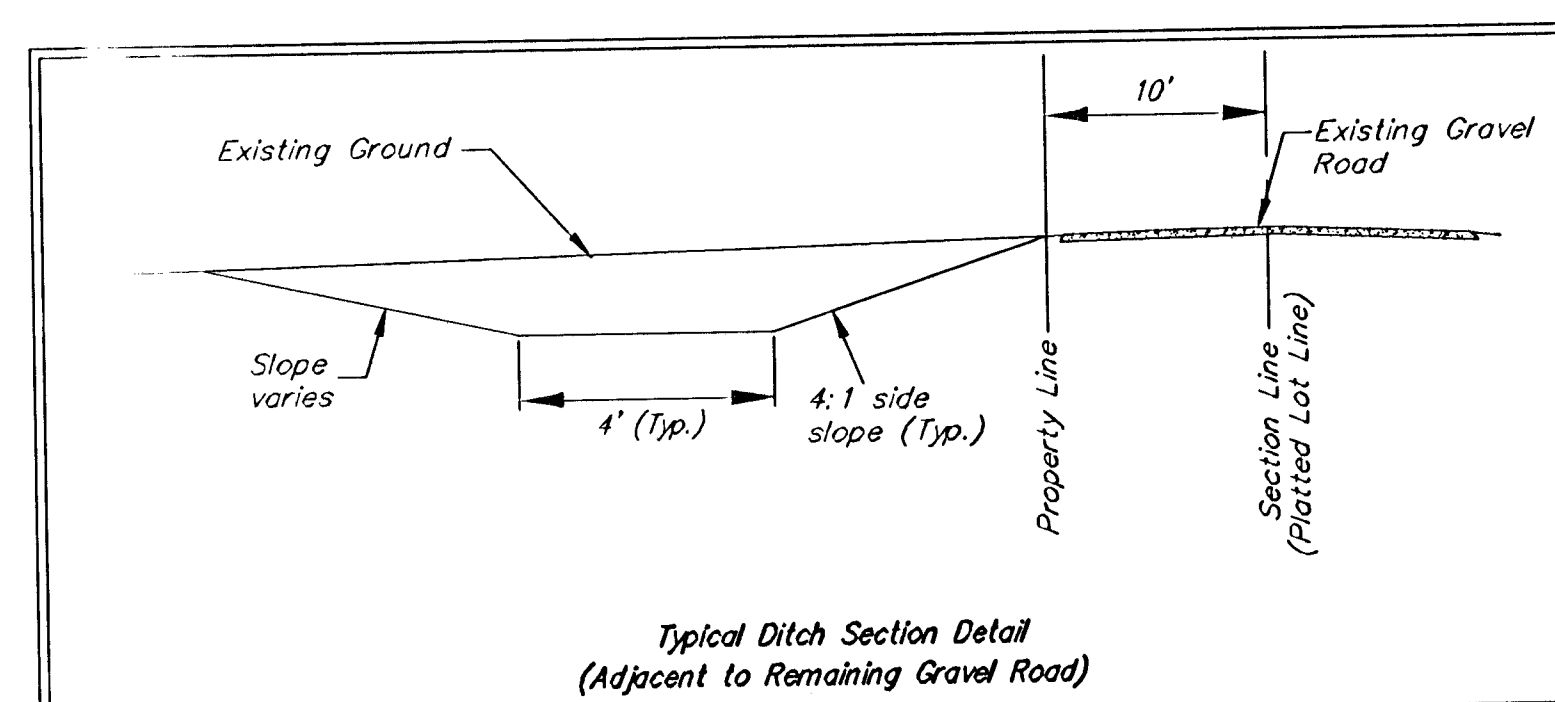

Remove trees only as necessary for street construction and only with permission of Developer or Baughman Co. Cost of removal to be incidental to lump sum bid item "Site Clearing & Restoration".

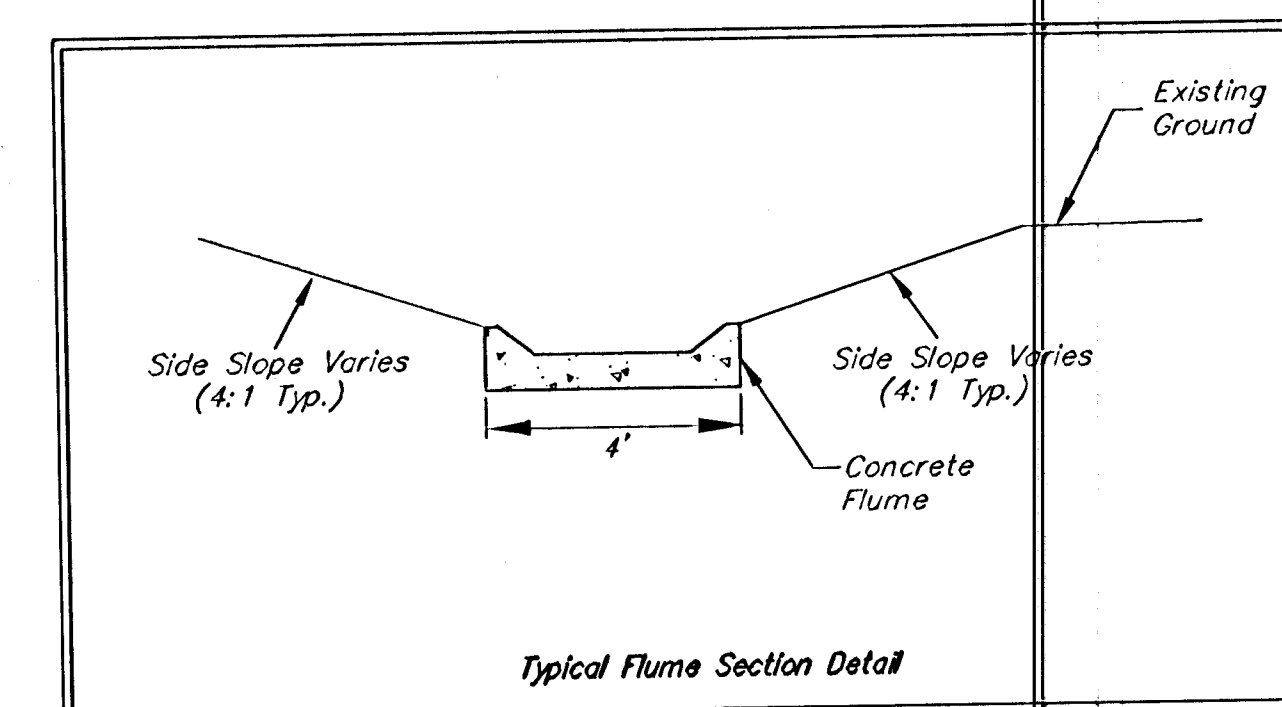

As Built 8/14/06 KK

B
Baughman
Auburn Hills 16th Addition
**City View Street
Closure Plan**
Storm Water Drain Improvements

Baughman Company, P.A. 315 Ellis St. Wichita, KS 67211 P 316-262-7271 F 316-262-0144
ARCHITECTS • PLANNING • LANDSCAPE ARCHITECTURE

ENGINEERING	SURVEYING	PLANNING	LANDSCAPE ARCHITECTURE
PROJECT NUMBER 468-84092		DESIGN AEG	DRAWN RDM

REVISIONS: _____ APPROVED _____ DATE 03/08/2000

	SCALE	
	Noted	

NOTED
SHEET **23** OF **47**

E:\Auburn Hills 16th\SWD\Mass_7.dwg