


SEWER SERVICE TABLE

NUMBER	TYPE	LOCATION			FOR INFORMATION ONLY		
		LOT NO.	BLOCK NO.	LINE NO.	STATION \ DIRECTION	APPROXIMATE LENGTH 4" PIPE	
1	8" X 4" Tee Saddle	9	1	1	1+ <del>00</del> /L	13' 7"	10'
2	8" X 4" Tee Saddle	7	1	1	1+ <del>00</del> /R	45.5' 7"	10'
3	8" X 4" Tee Saddle	8	1	1	2+ <del>00</del> /L	10.5' 8"	10'
4	4" MH Riser	23	2	1	3+ <del>00</del> /R	26.44' 9"	29'
5	8" X 4" Tee Saddle	22	2	1	4+ <del>00</del> /R	14.44' 9"	10'
6	8" X 4" Tee Saddle	21	2	1	8+ <del>00</del> /R	83.02' 9"	14'
7	8" X 4" Tee Saddle	20	2	1	9+ <del>00</del> /R	78.02' 9"	14'

NOTE: Vertical Riser Pipe shall be extended to 2' minimum above ground water elevation and 4' maximum below proposed ground elevation.

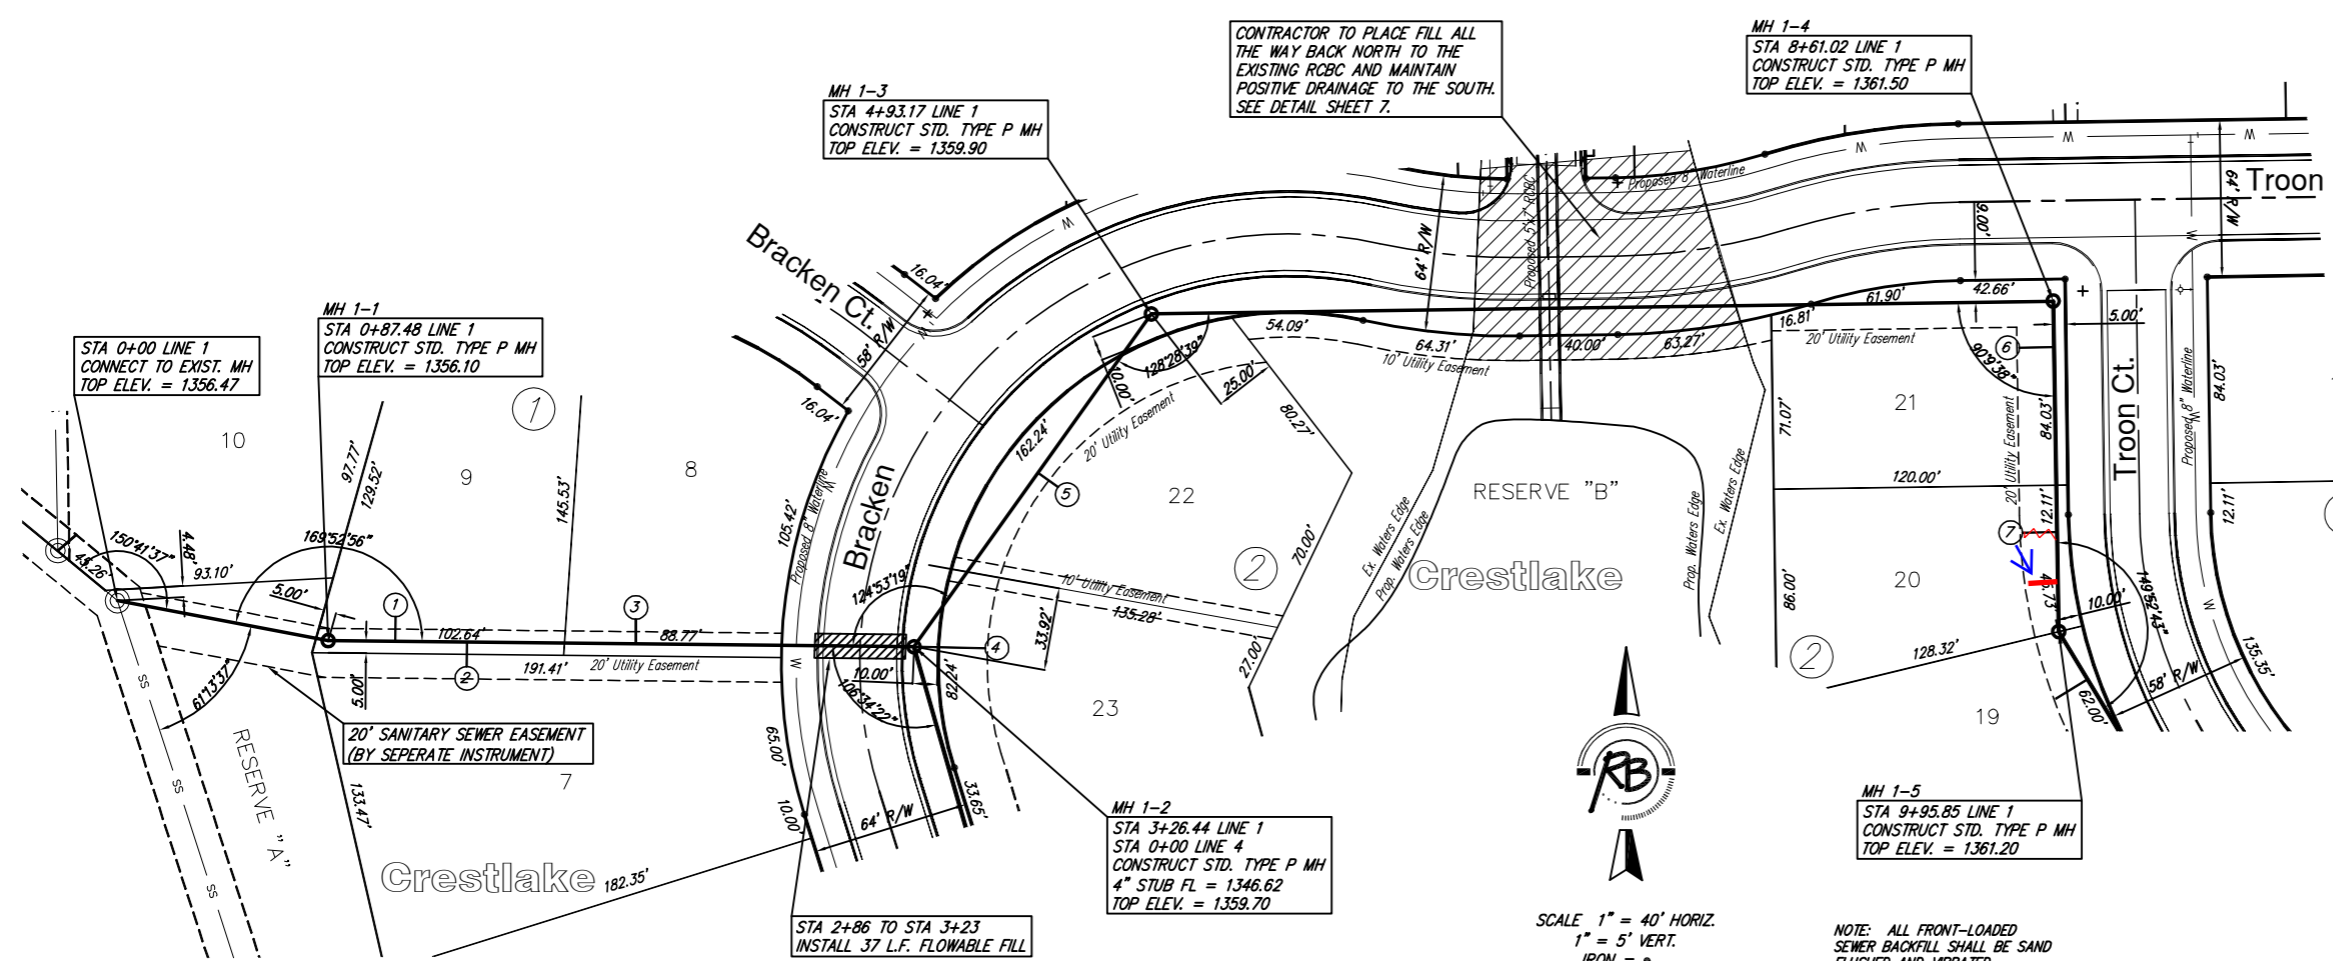

CONTRACTOR TO PLACE FILL ALL THE WAY BACK NORTH TO THE EXISTING RCBC AND MAINTAIN POSITIVE DRAINAGE TO THE SOUTH. SEE DETAIL SHEET 7.

MH 1-4  
STA 8+61.02 LINE 1  
CONSTRUCT STD. TYPE P MH  
TOP ELEV. = 1361.50

MH 1-3  
STA 4+93.17 LINE 1  
CONSTRUCT STD. TYPE P MH  
TOP ELEV. = 1359.90

MH 1-1  
STA 0+87.48 LINE 1  
CONSTRUCT STD. TYPE P MH  
TOP ELEV. = 1356.10

STA 0+00 LINE 1  
CONNECT TO EXIST. MH  
TOP ELEV. = 1356.47


MH 1-2  
STA 3+26.44 LINE 1  
STA 0+00 LINE 4  
CONSTRUCT STD. TYPE P MH  
4" STUB FL = 1346.62  
TOP ELEV. = 1359.70

MH 1-5  
STA 9+95.85 LINE 1  
CONSTRUCT STD. TYPE P MH  
TOP ELEV. = 1361.20

STA 2+86 TO STA 3+23  
INSTALL 37 L.F. FLOWABLE FILL

SCALE 1" = 40' HORIZ.  
1" = 5' VERT.  
IRON = ●

NOTE: ALL FRONT-LOADED SEWER BACKFILL SHALL BE SAND FLUSHED AND VIBRATED.

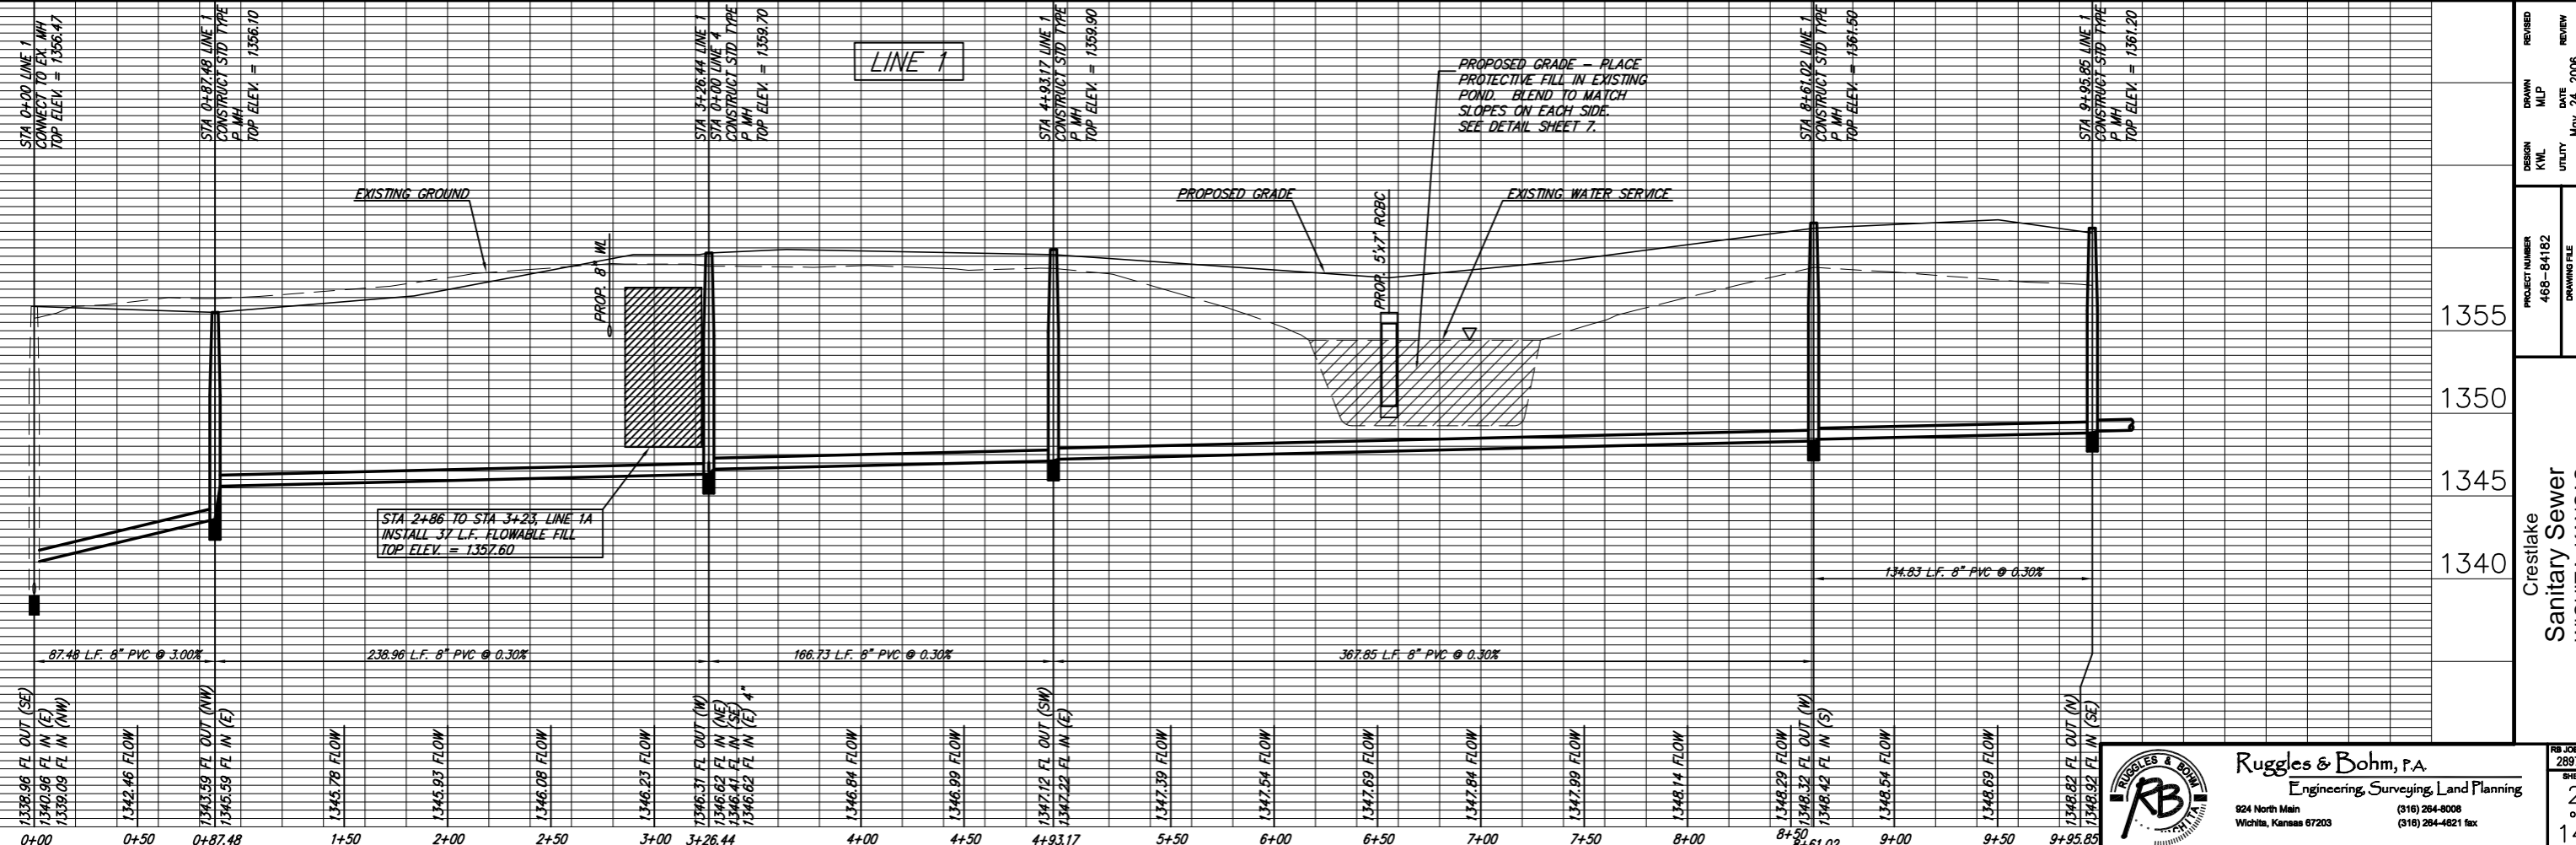

DESIGN	REVISION
KWL	MLP
UTILITY	DATE
	May, 24, 2006
PROJECT NUMBER	468-84182
DRAWING FILE	Sanitary Sewer {LINE 1-1}

1355  
1350  
1345  
1340

Crestlake  
Sanitary Sewer



Ruggles & Bohm, P.A.  
Engineering, Surveying, Land Planning  
924 North Main  
Wichita, Kansas 67203  
(316) 264-8008  
(316) 264-4821 fax