
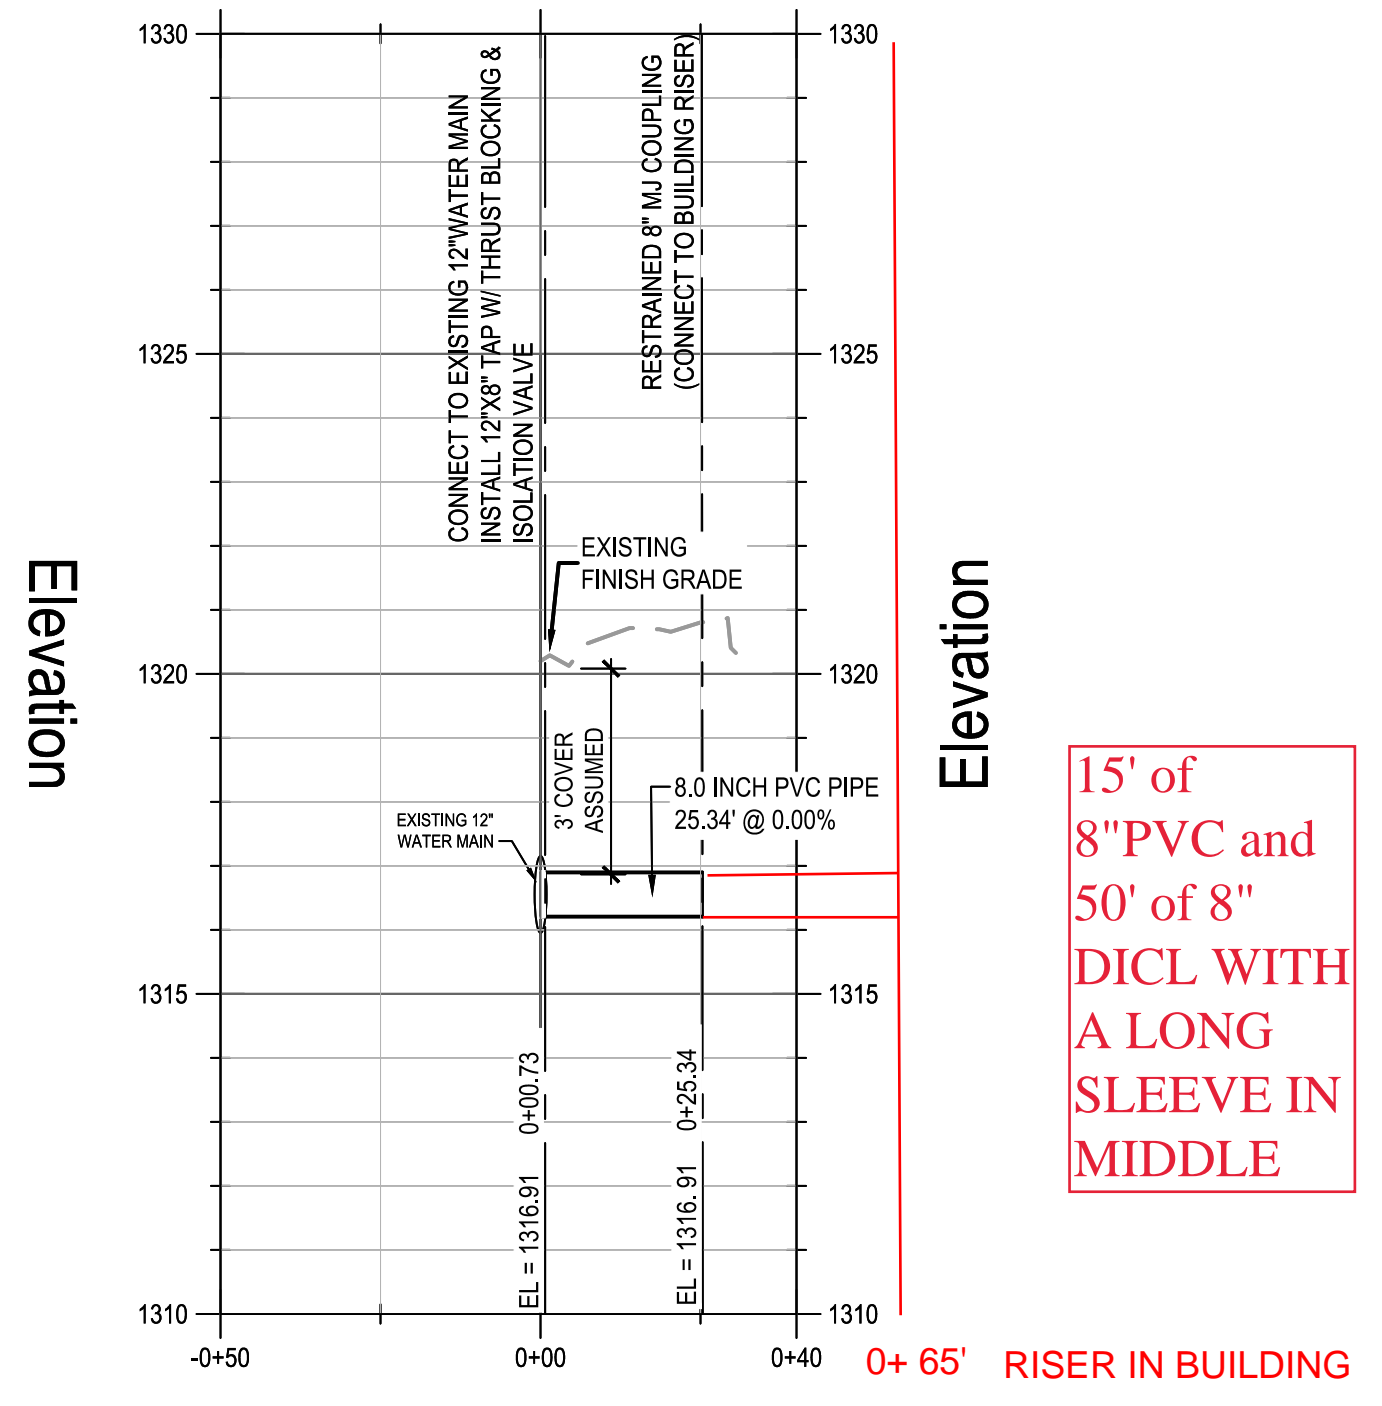
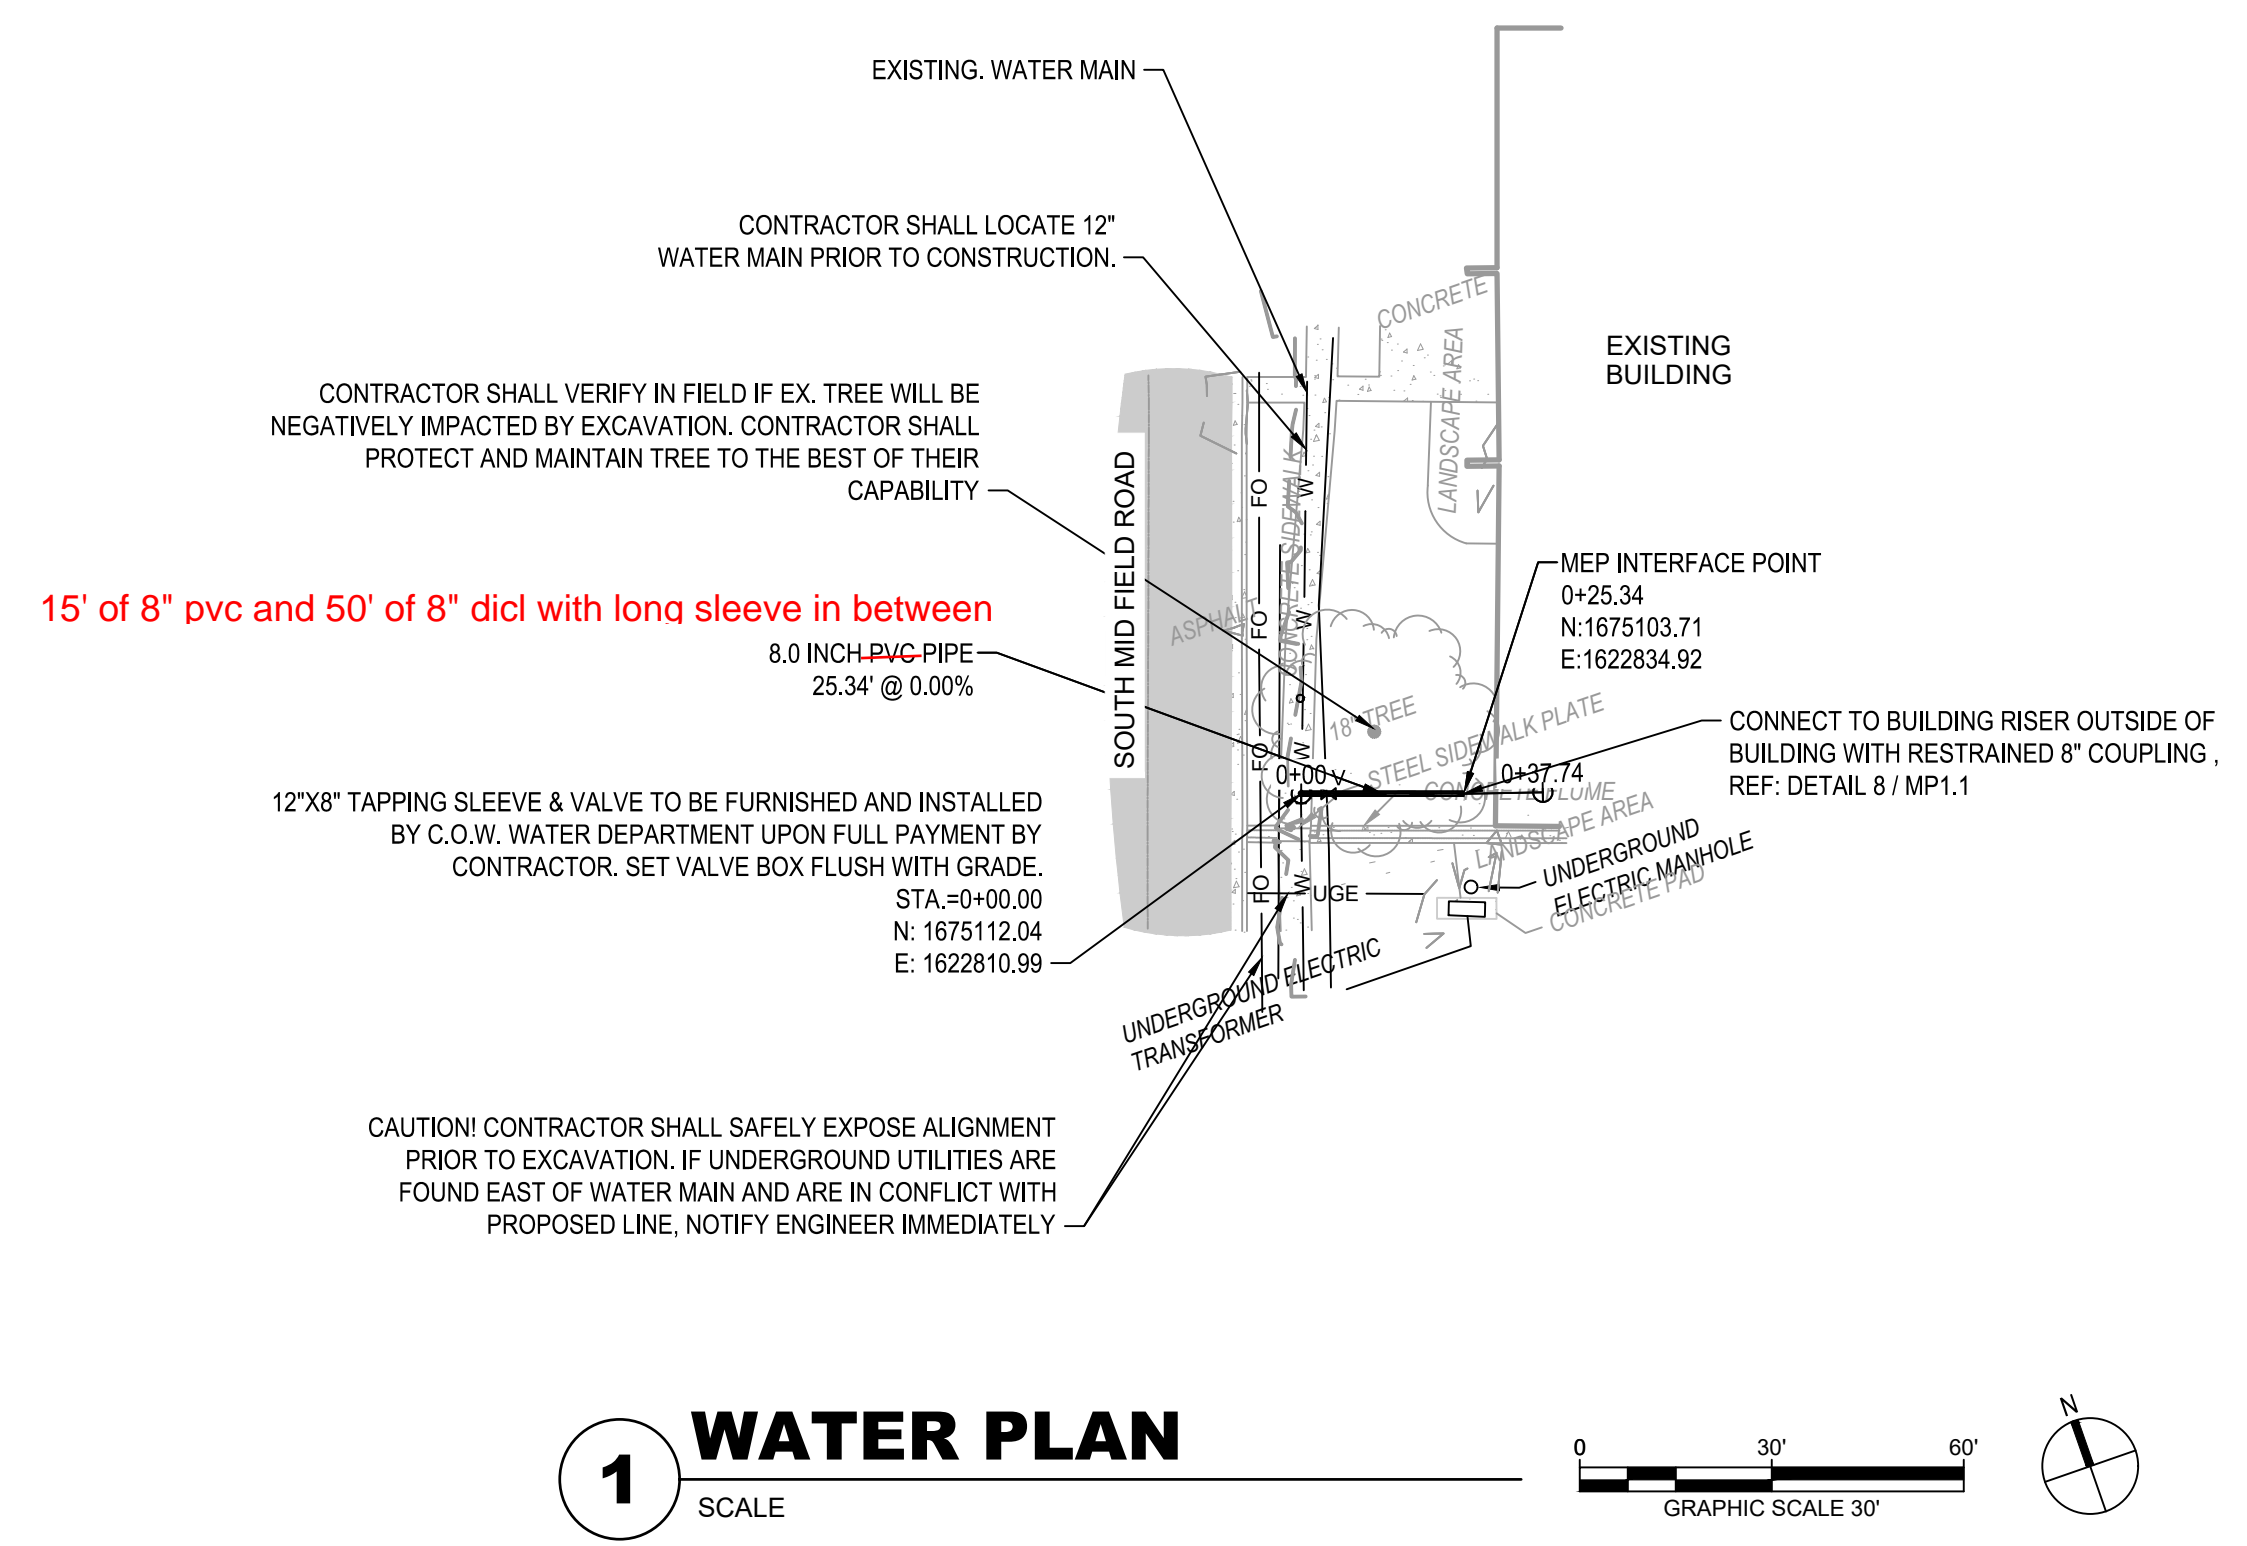


AS BUILTS



KEMILLER
ENGINEERING PA

117 E. Lewis,
Wichita, KS 67202 (316)264-0242



YINGLING AVIATION
WAREHOUSE REMODEL
 1962 MIDFIELD ROAD DWIGHT D. EISENHOWER
 NATIONAL AIRPORT, WICHITA KS

DESCRIPTION	DATE
PROJECT NO:	13038R2004
STATUS:	ISSUE FOR CONSTRUCTION
DATE:	12/19/2023
DRAWN BY:	RLN
CHECKED BY:	KLH

WATER
 PLAN &
 PROFILES

CU230

