
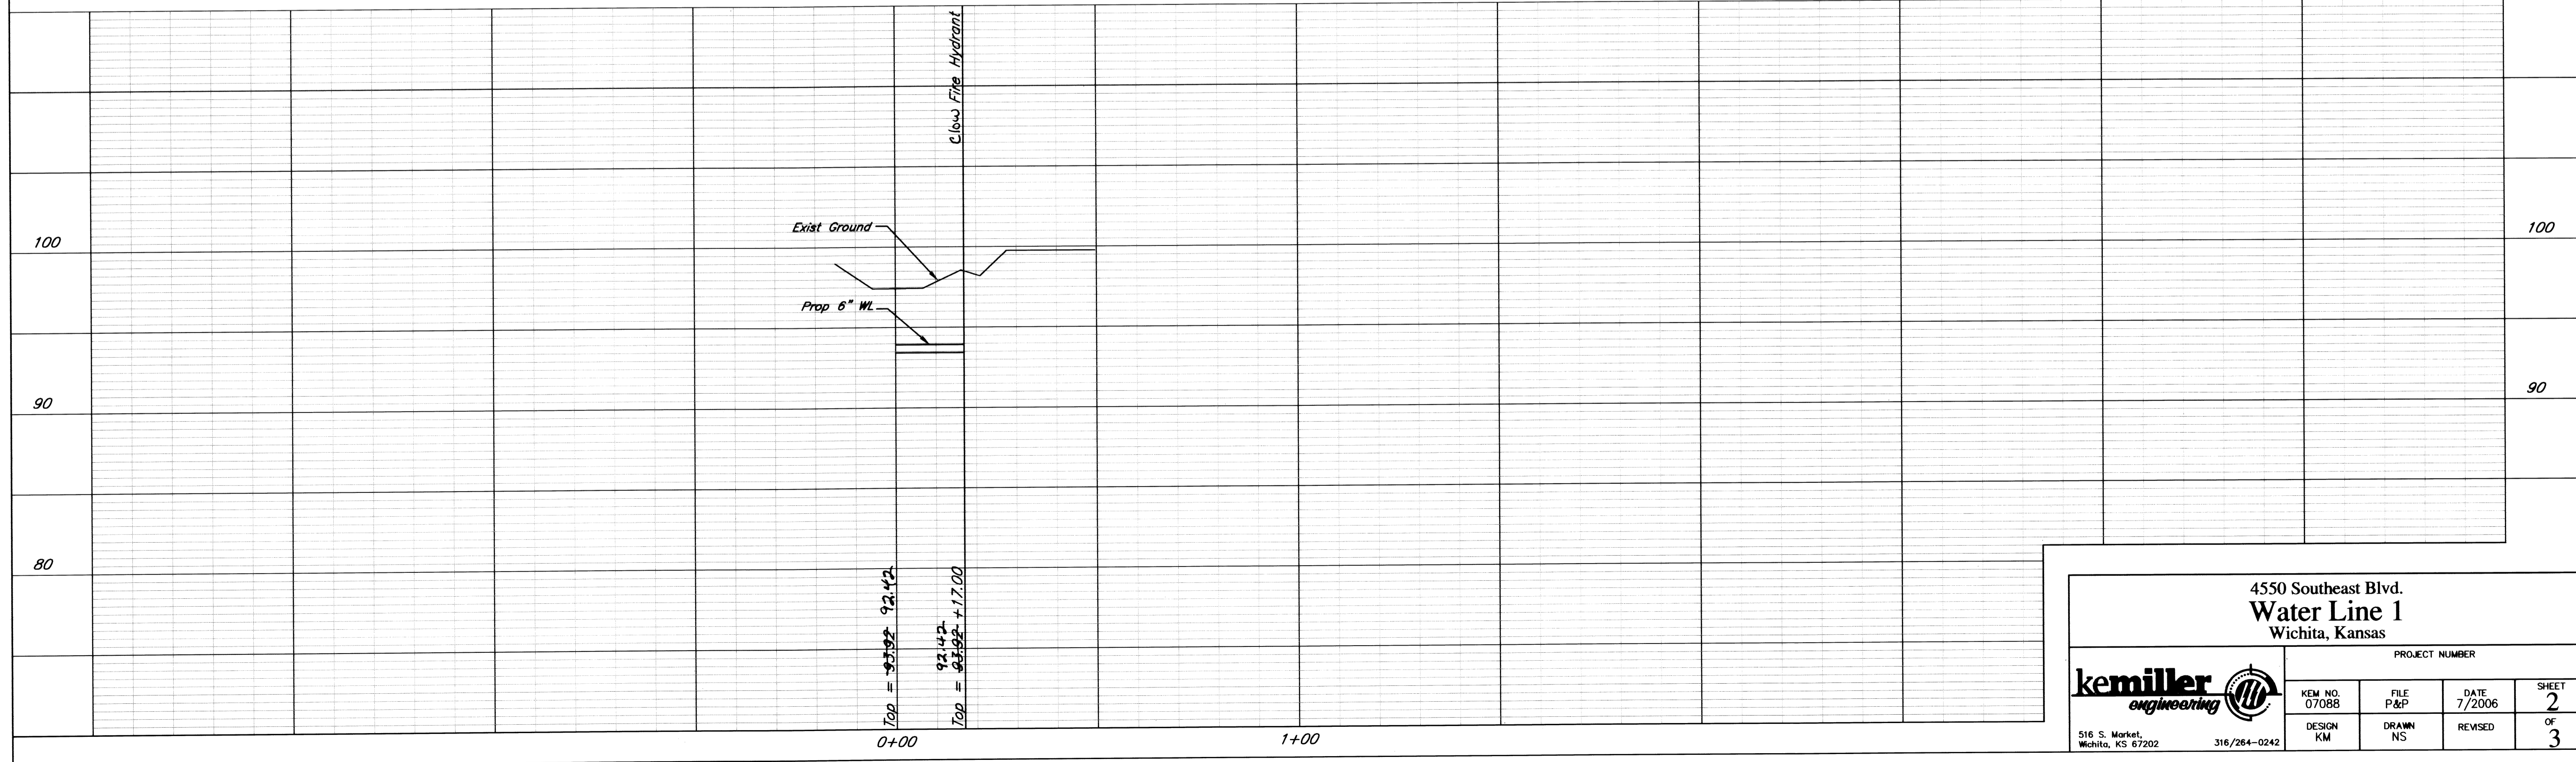


W.L. Sta. 0+00.00  
 B.L. Sta. 10+10.03 201.31 RT  
 \*1-8"x6" Tapping Sleeve  
 \*1-6" Valve  
 \*1-6" Valve Box  
 Valve Box Elev = 98.51  
 \*To be Installed by COW  
 \*To be Paid by Contractor

W.L. Sta. 00+17.00 Line 1  
 B.L. Sta. 10+26.77 198.36 RT  
 \*1- Fire Hydrant C10x4  
 Bury Line Elev. = 98.88

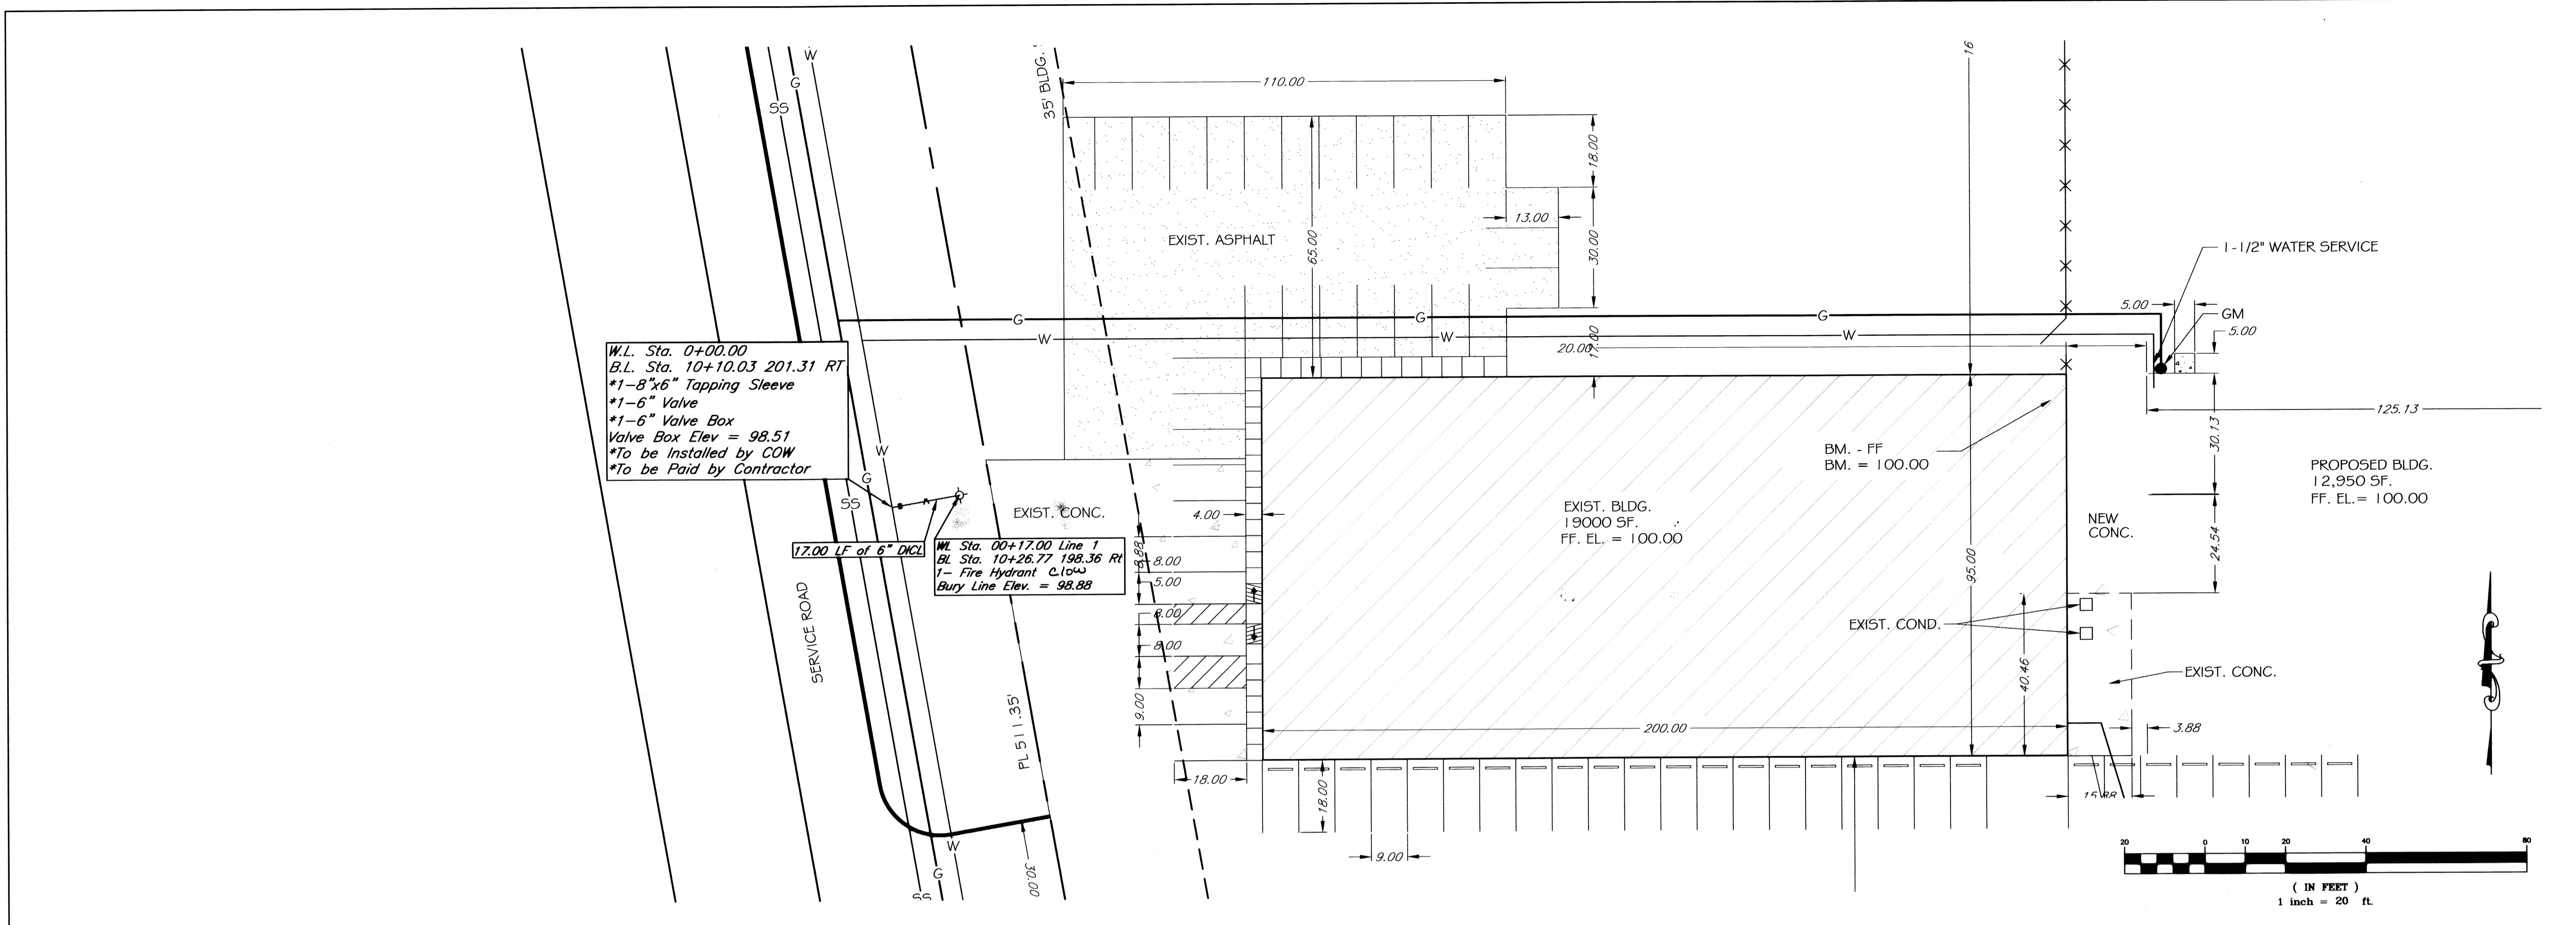

4550 Southeast Blvd.  
 Water Line 1  
 Wichita, Kansas

**kemiller**  
 engineering

PROJECT NUMBER			
KEM NO. 07088	FILE P&P	DATE 7/2006	SHEET 2
DESIGN KM	DRAWN NS	REVISED	OF 3

516 S. Market,  
 Wichita, KS 67202

316/264-0242