



REVISIONS			
REV	DESCRIPTION	DATE	APPROVED

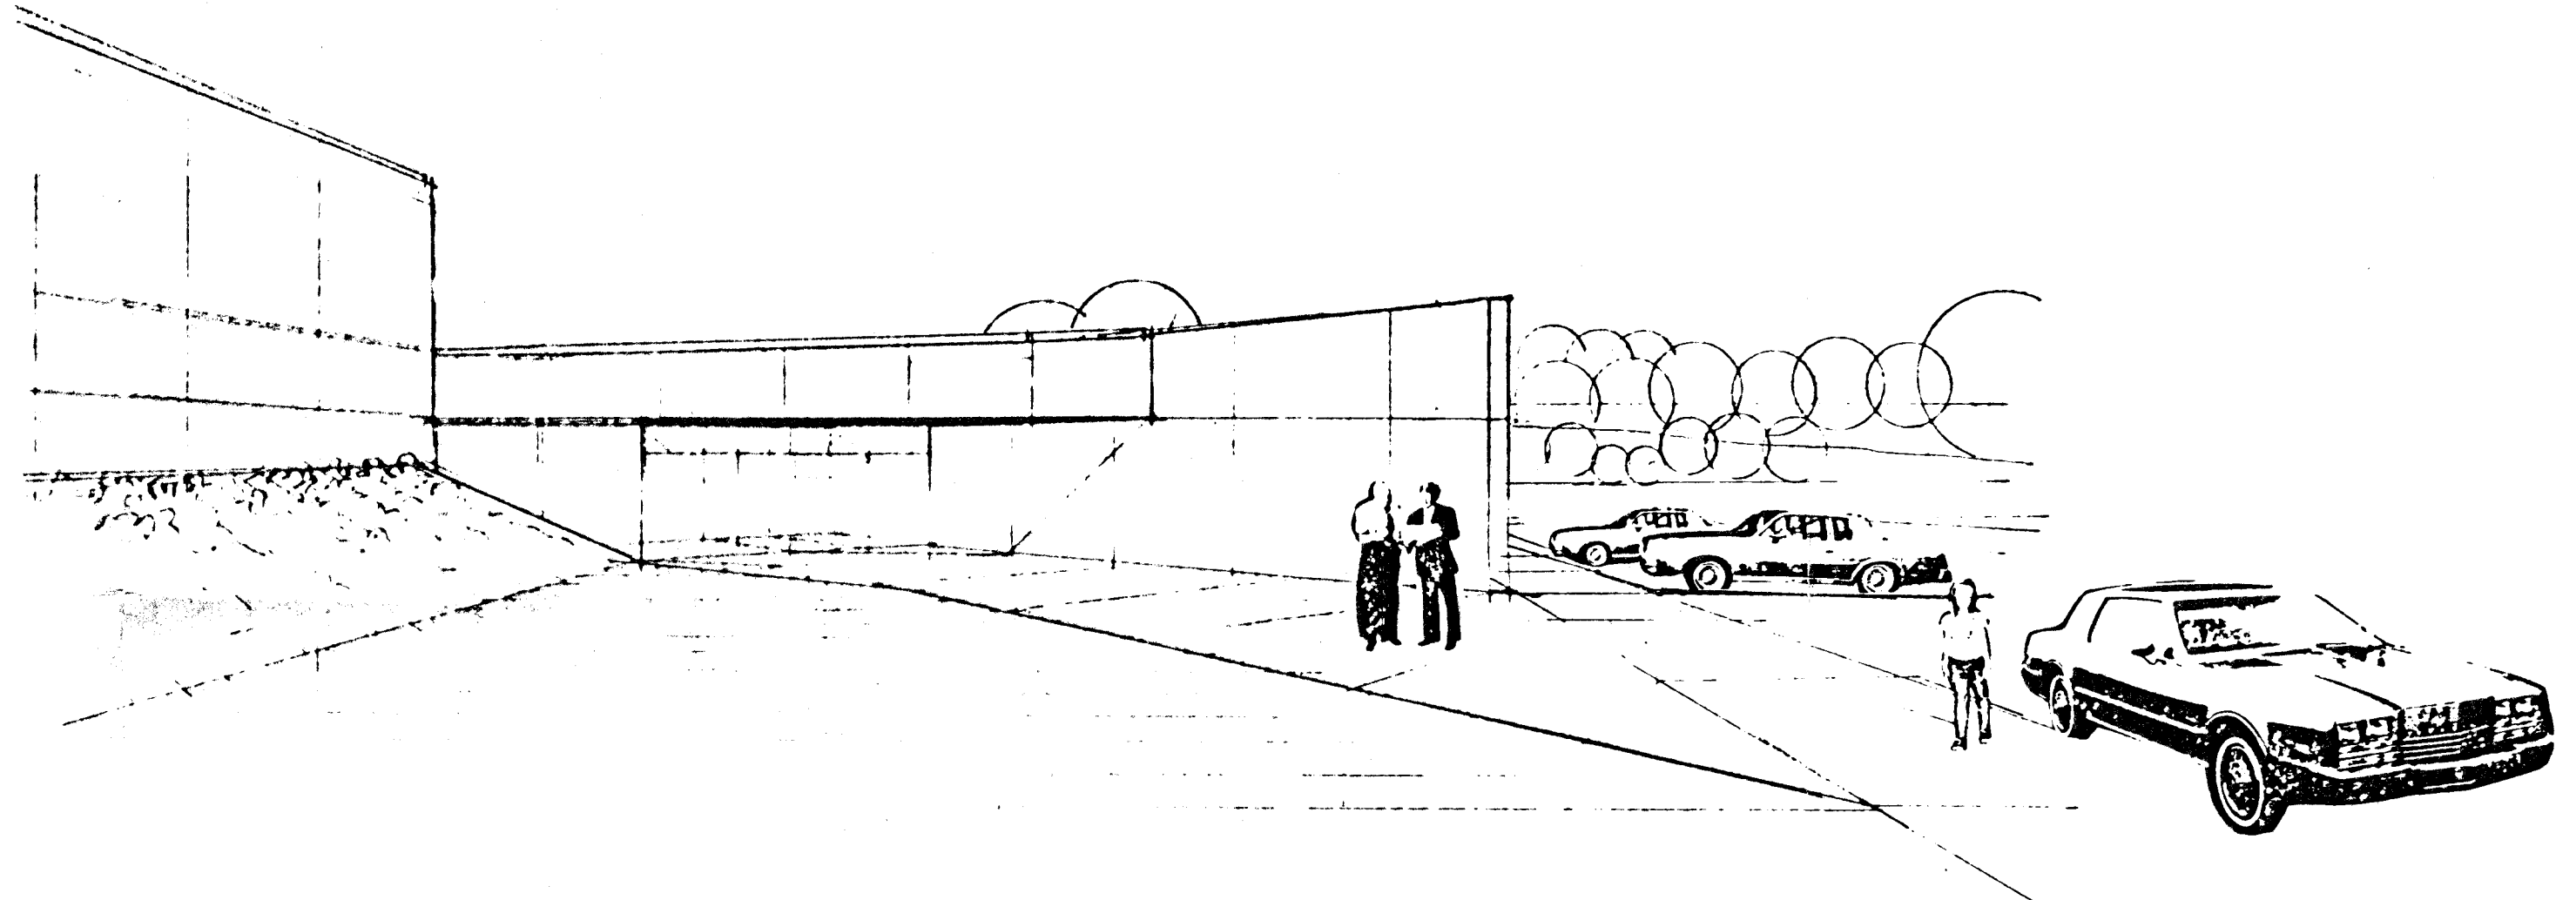

Main Entrance

# Site Plan

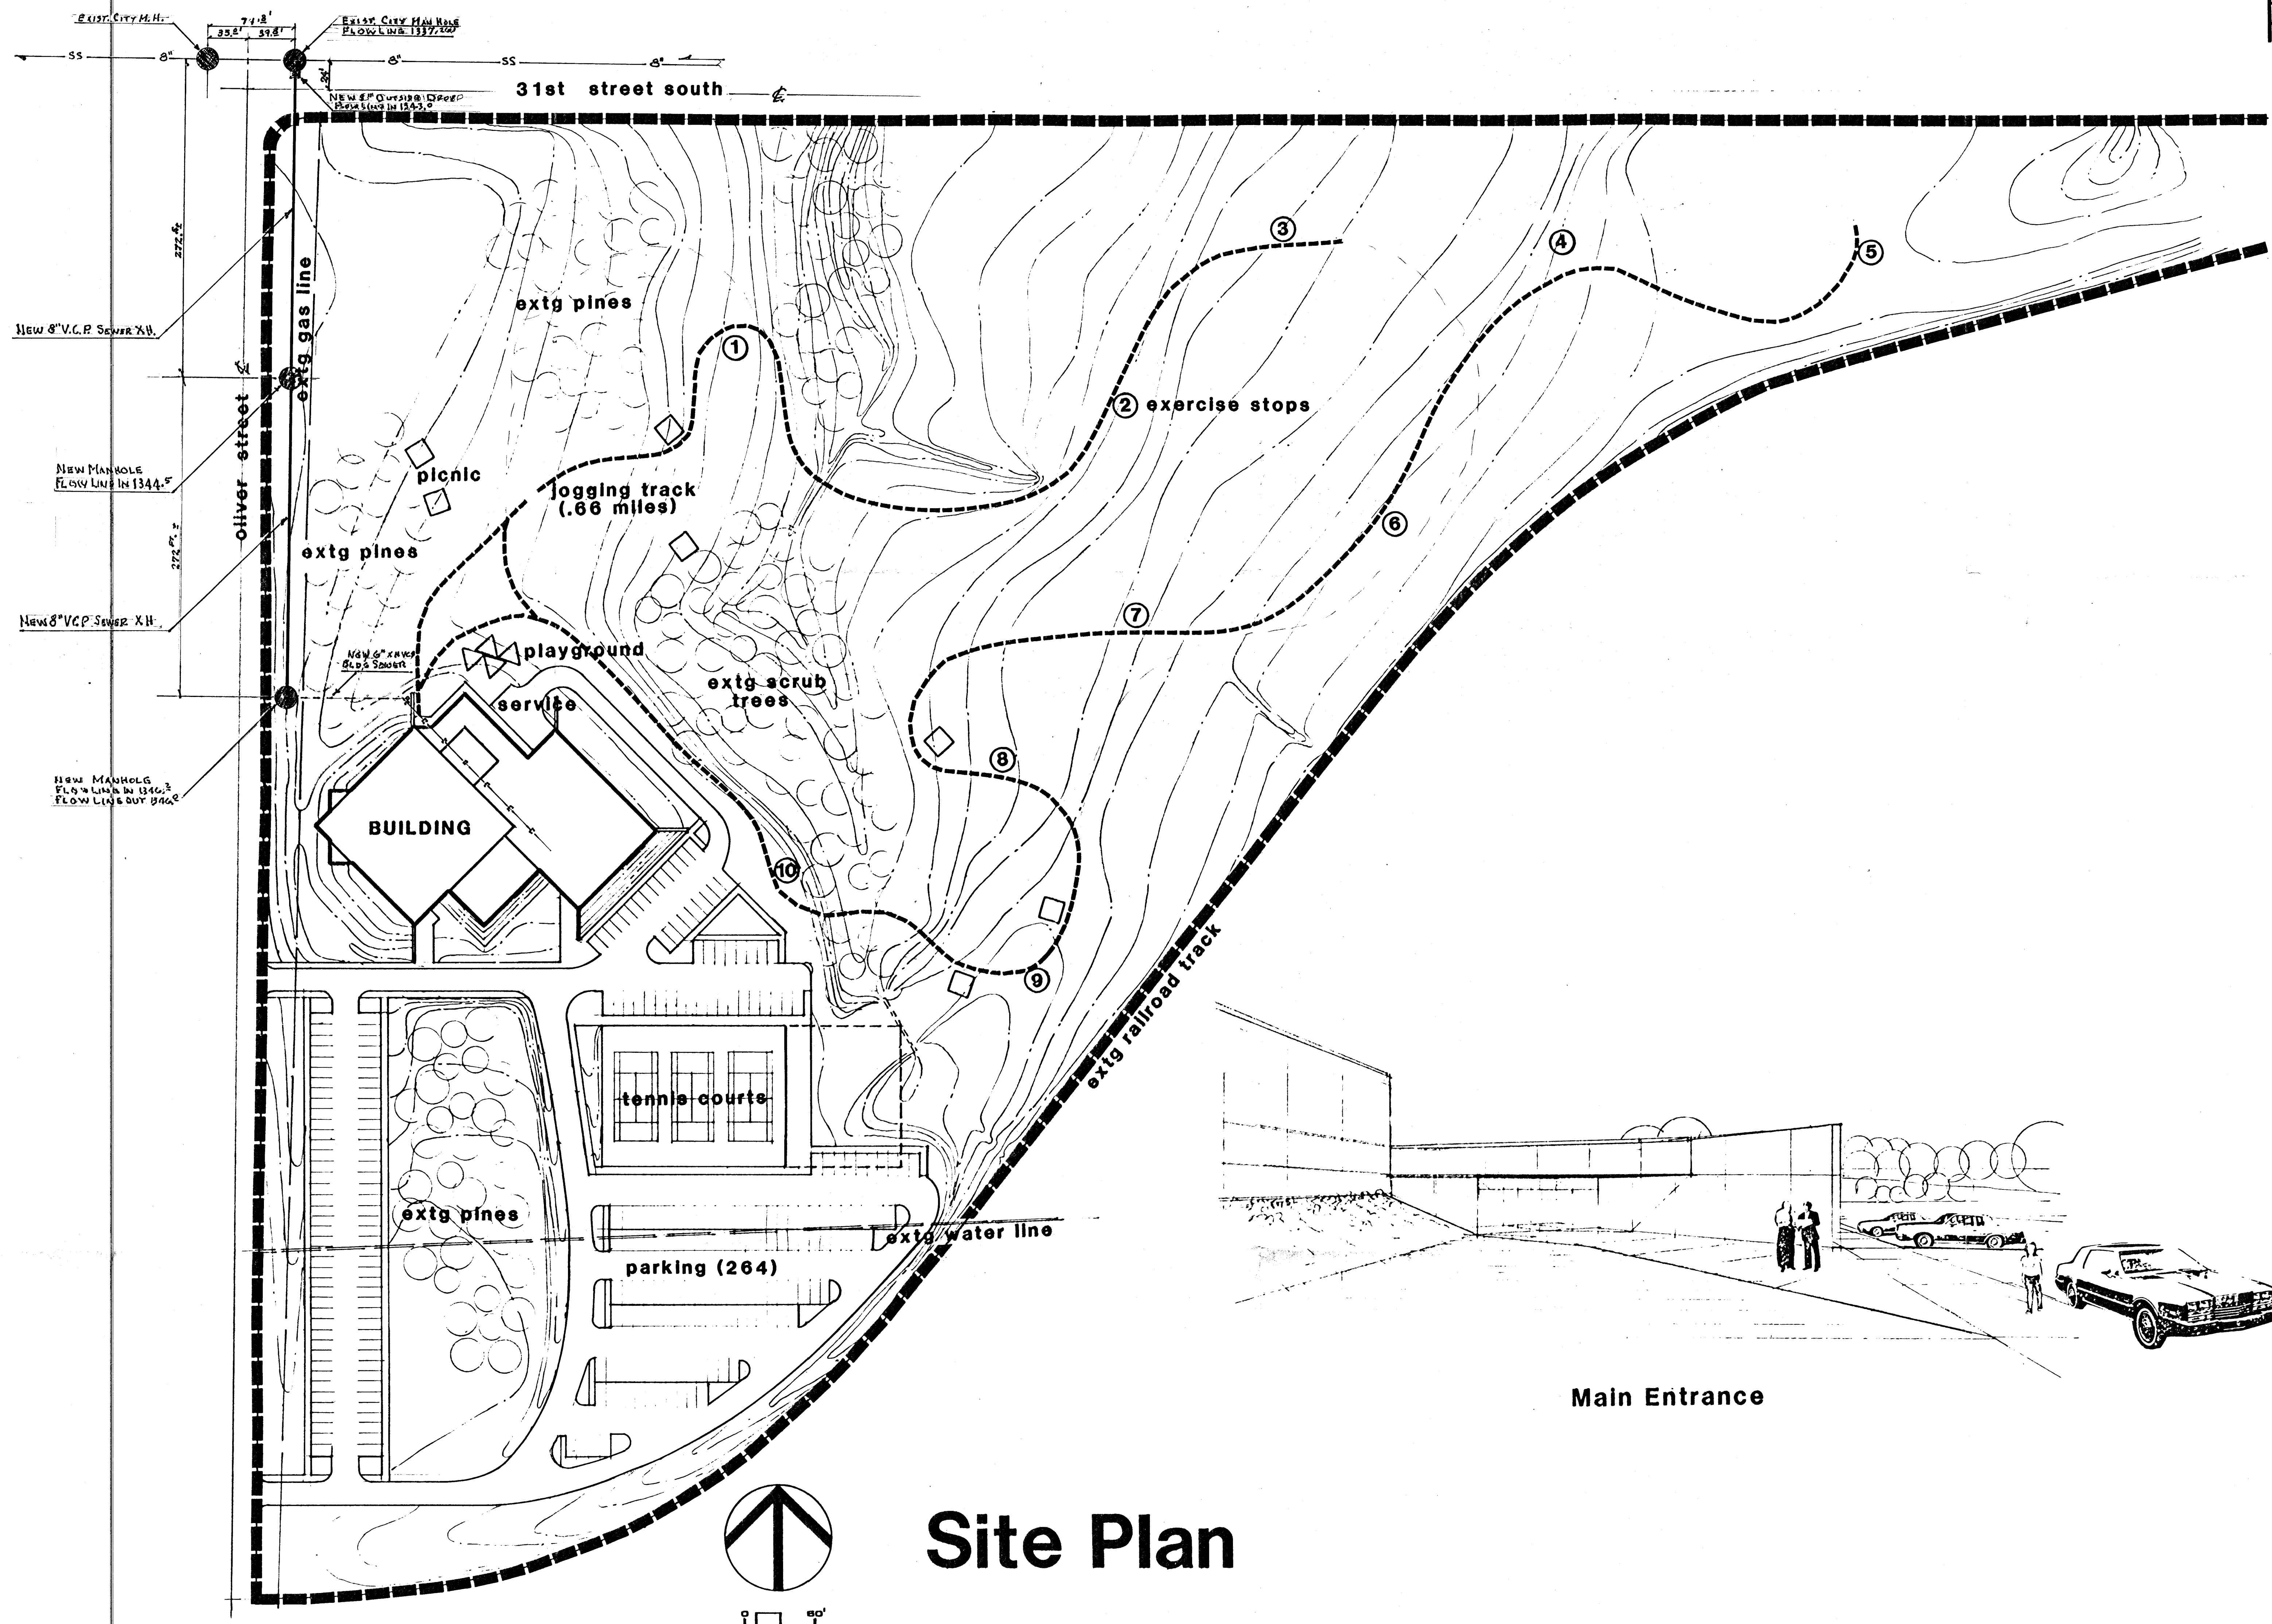

DRAWN BY	ENGRD. BY	BE&C ENGINEERS INC.	
CHECKED	CHECKED		
APPROVED	APPROVED		
		SIZE	FSCM NO.
		F 326	REV.
DATE		DWG. NO.	