


5/1/89

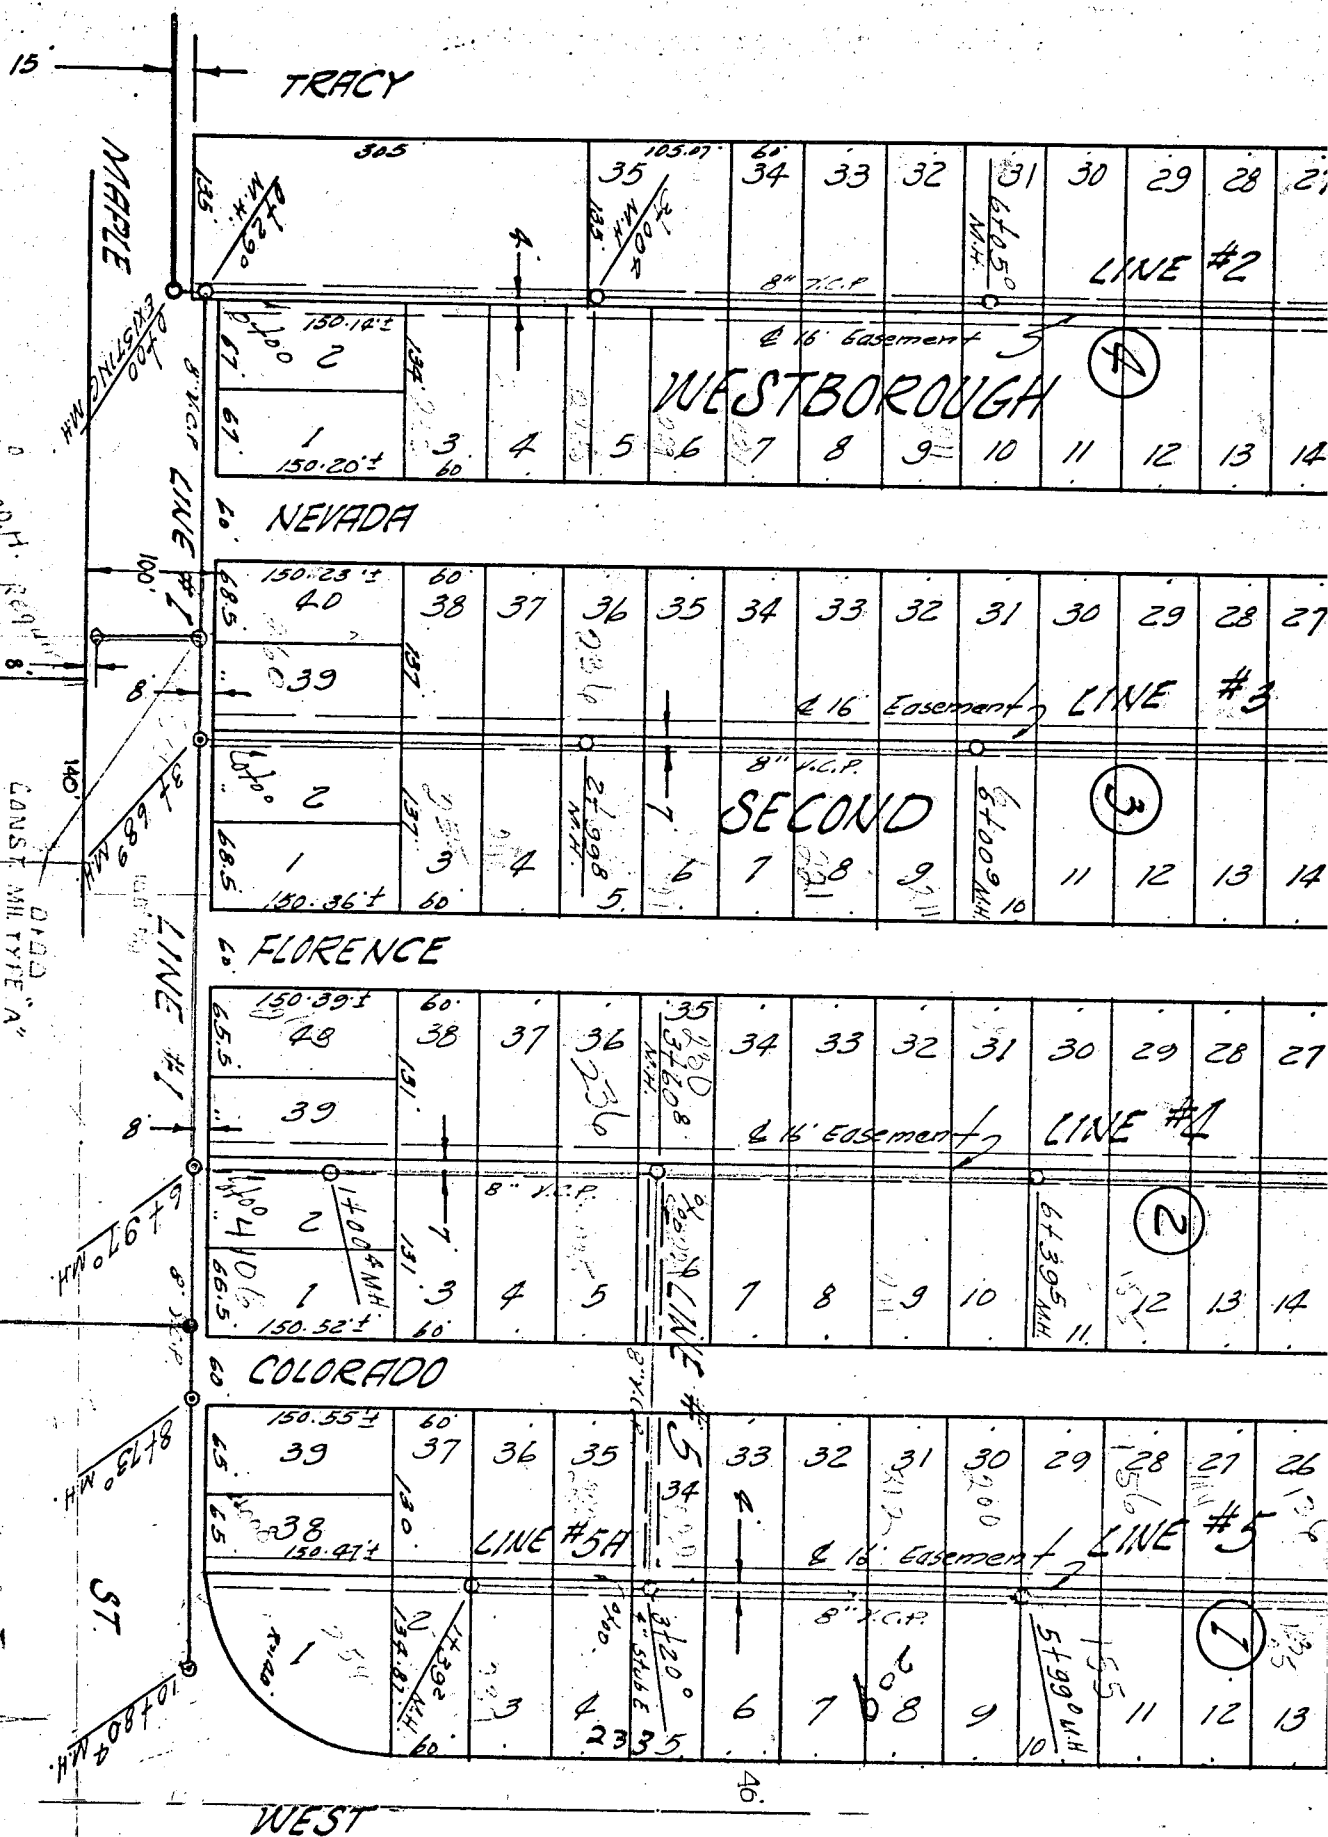

San. Sewer  
STAR LUMBER Co. 4th Bldg.  
7TH

CONST. MILL TYPE "A"  
AN EXIST. 8" LINE  
BEG. B' CLAY.

CONST. MILL TYPE "A"  
AN EXIST. 8" LINE  
BEG. B' CLAY.

San. Sewer  
STAR LUMBER Co. 4th Bldg.  
7TH

Private Contract.  
BK. NO. 53#12 JK Prod. No. BHRB 503057

LOTION 1 2 3 100