


N.E. 1/4 SEC. 36, TWP. 27 S., R. 1 W.

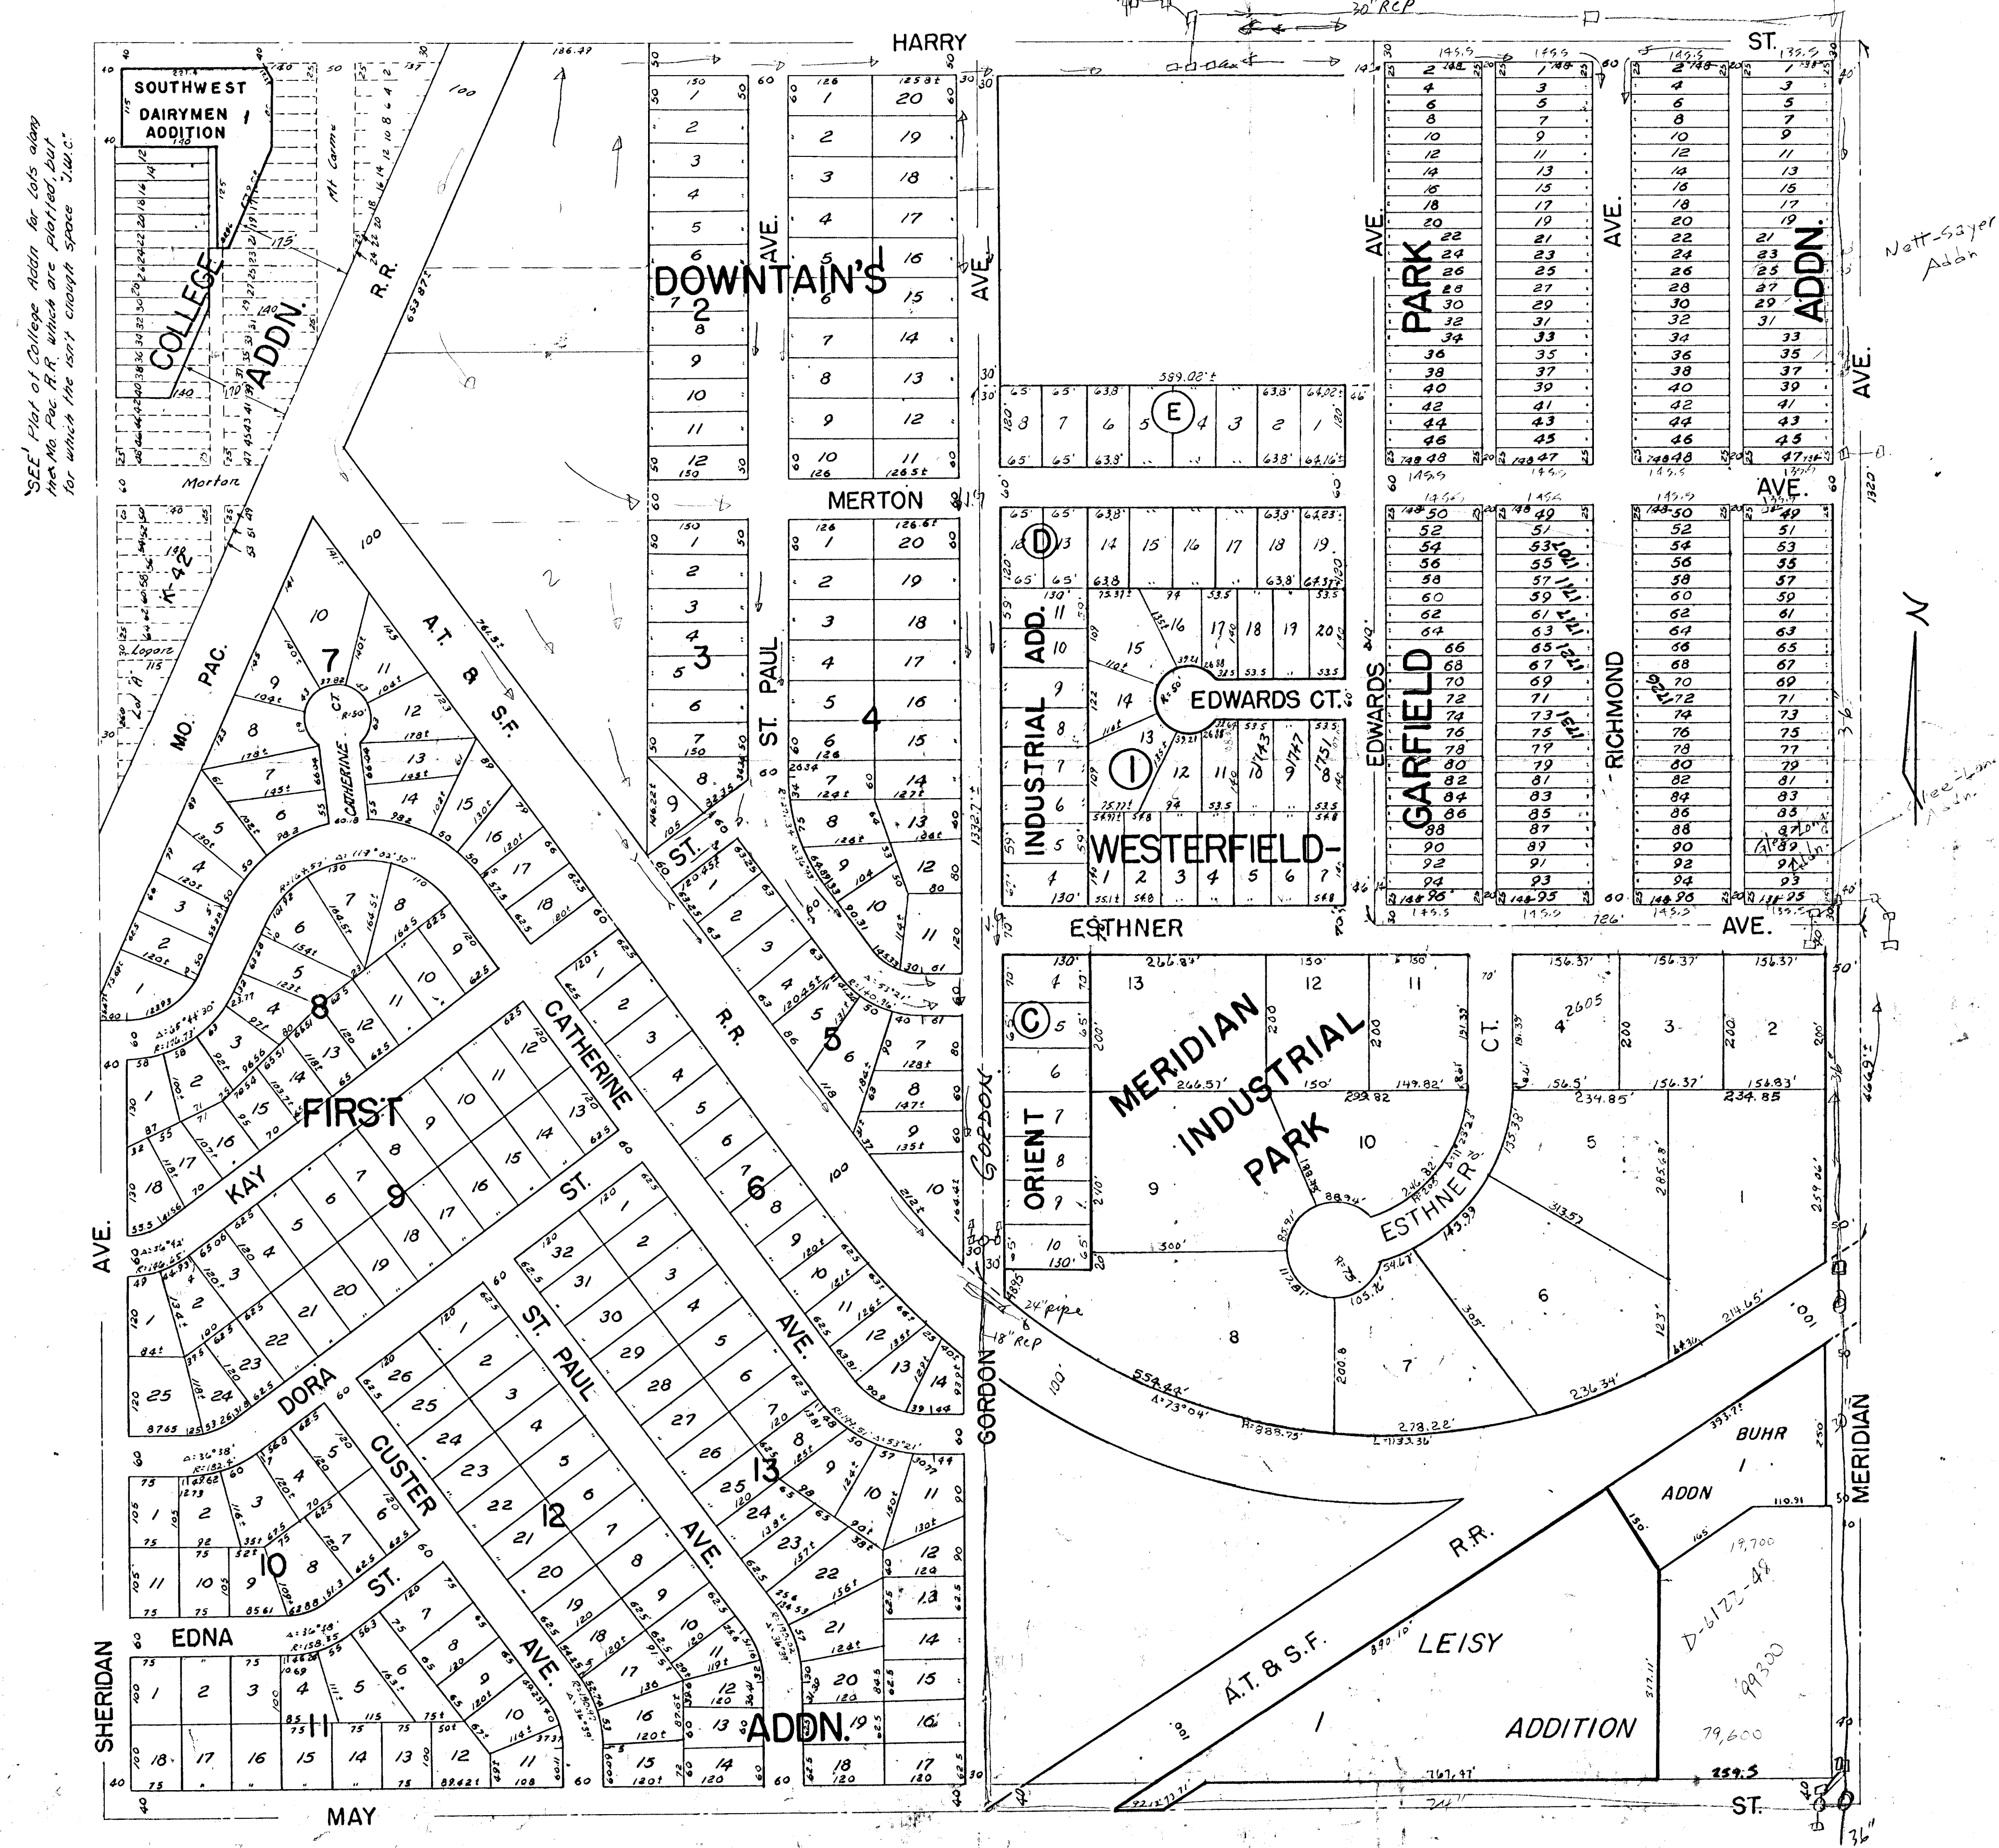

10 Pomeroy
Turn East on Pomeroy and
end at Johnson River.