

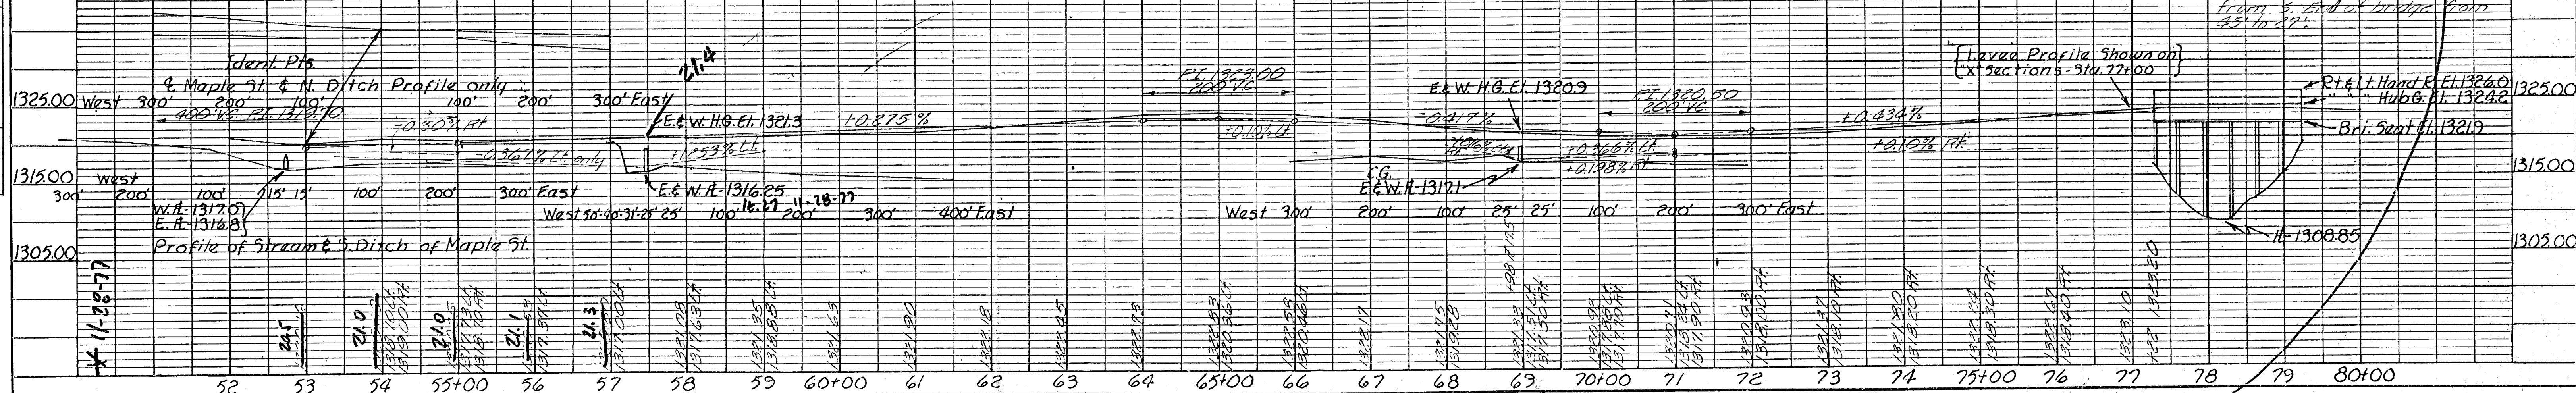
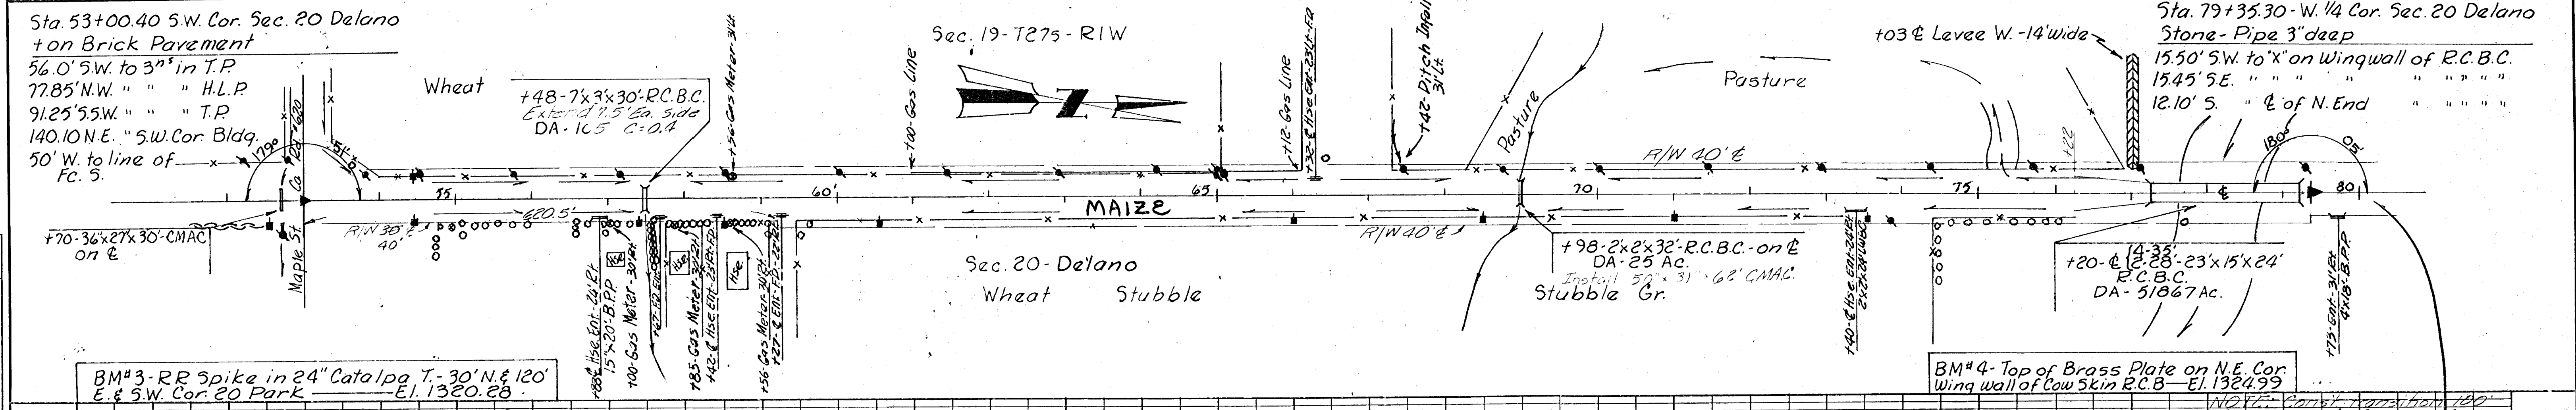


DATE 4-23-77
 BY G.F. Howard
 E.L. Wood
 SURVEYED
 PLOTTED
 ALIGNED
 CHECKED
 NOTE BOOK
 NO. OF WAY CHECKED

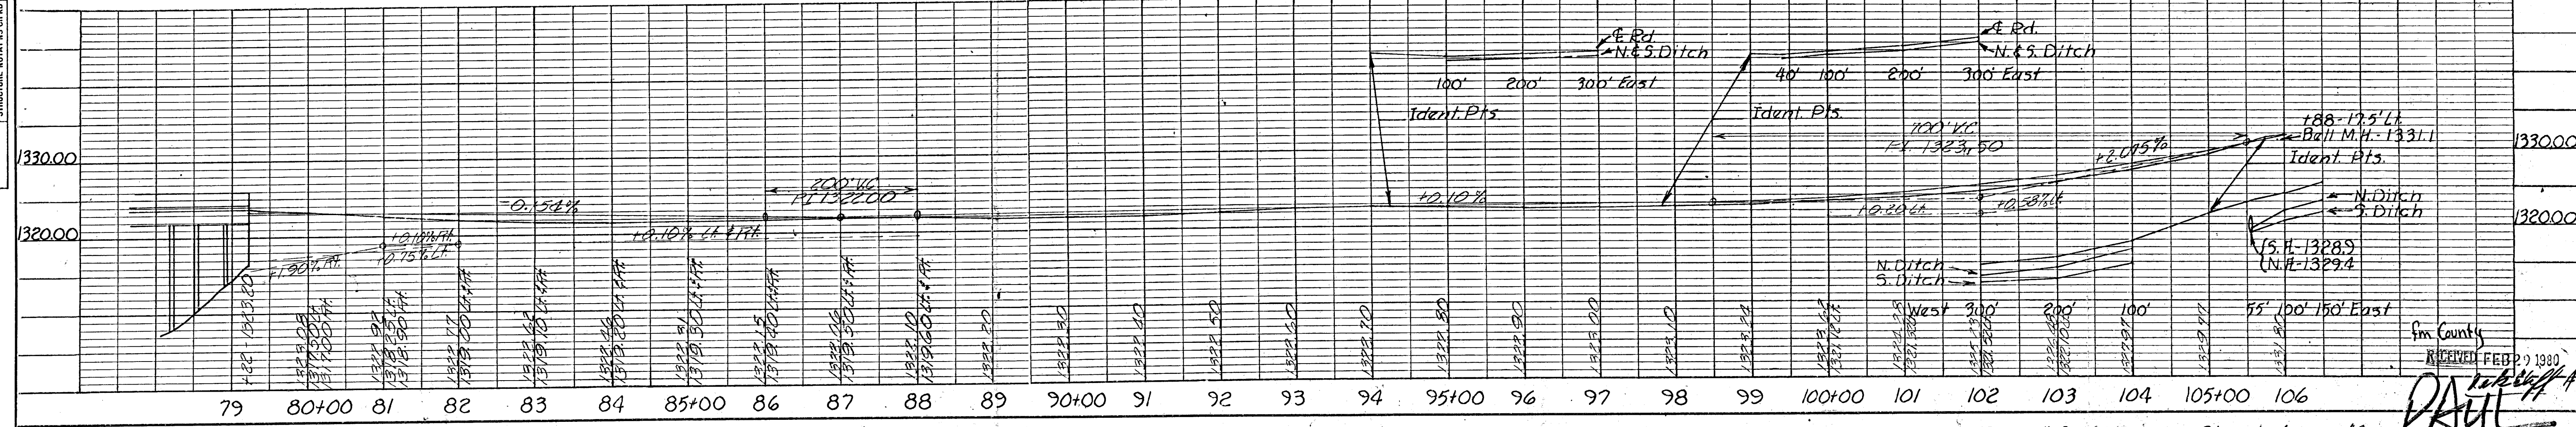

DATE
 BY
 SURVEYED
 GRADES CHECKED
 NOTE BOOK
 NO. STRUCTURE ROTARY'S CHD

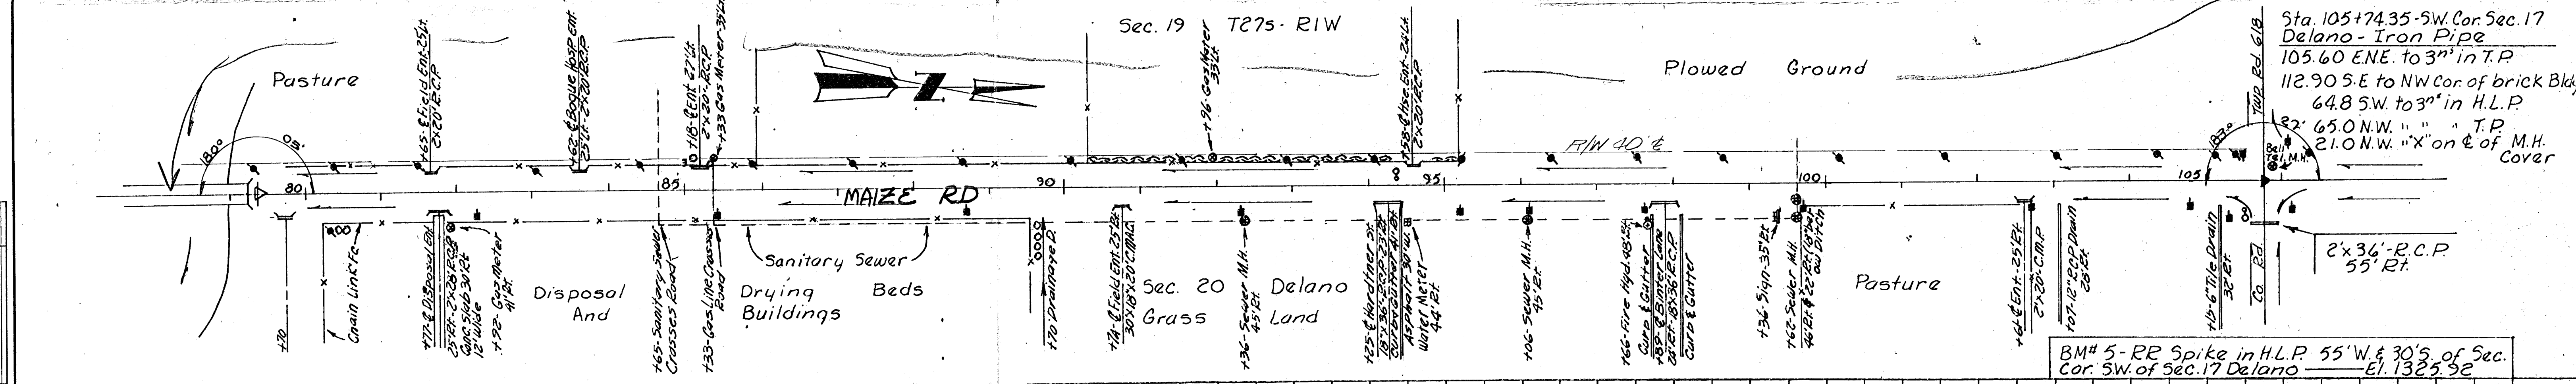

REC'D FEB 23 1980
 PAUL