


LEGAL DESCRIPTION:
LOT 27, BLOCK 1,
GALYARDT'S FIRST ADDITION

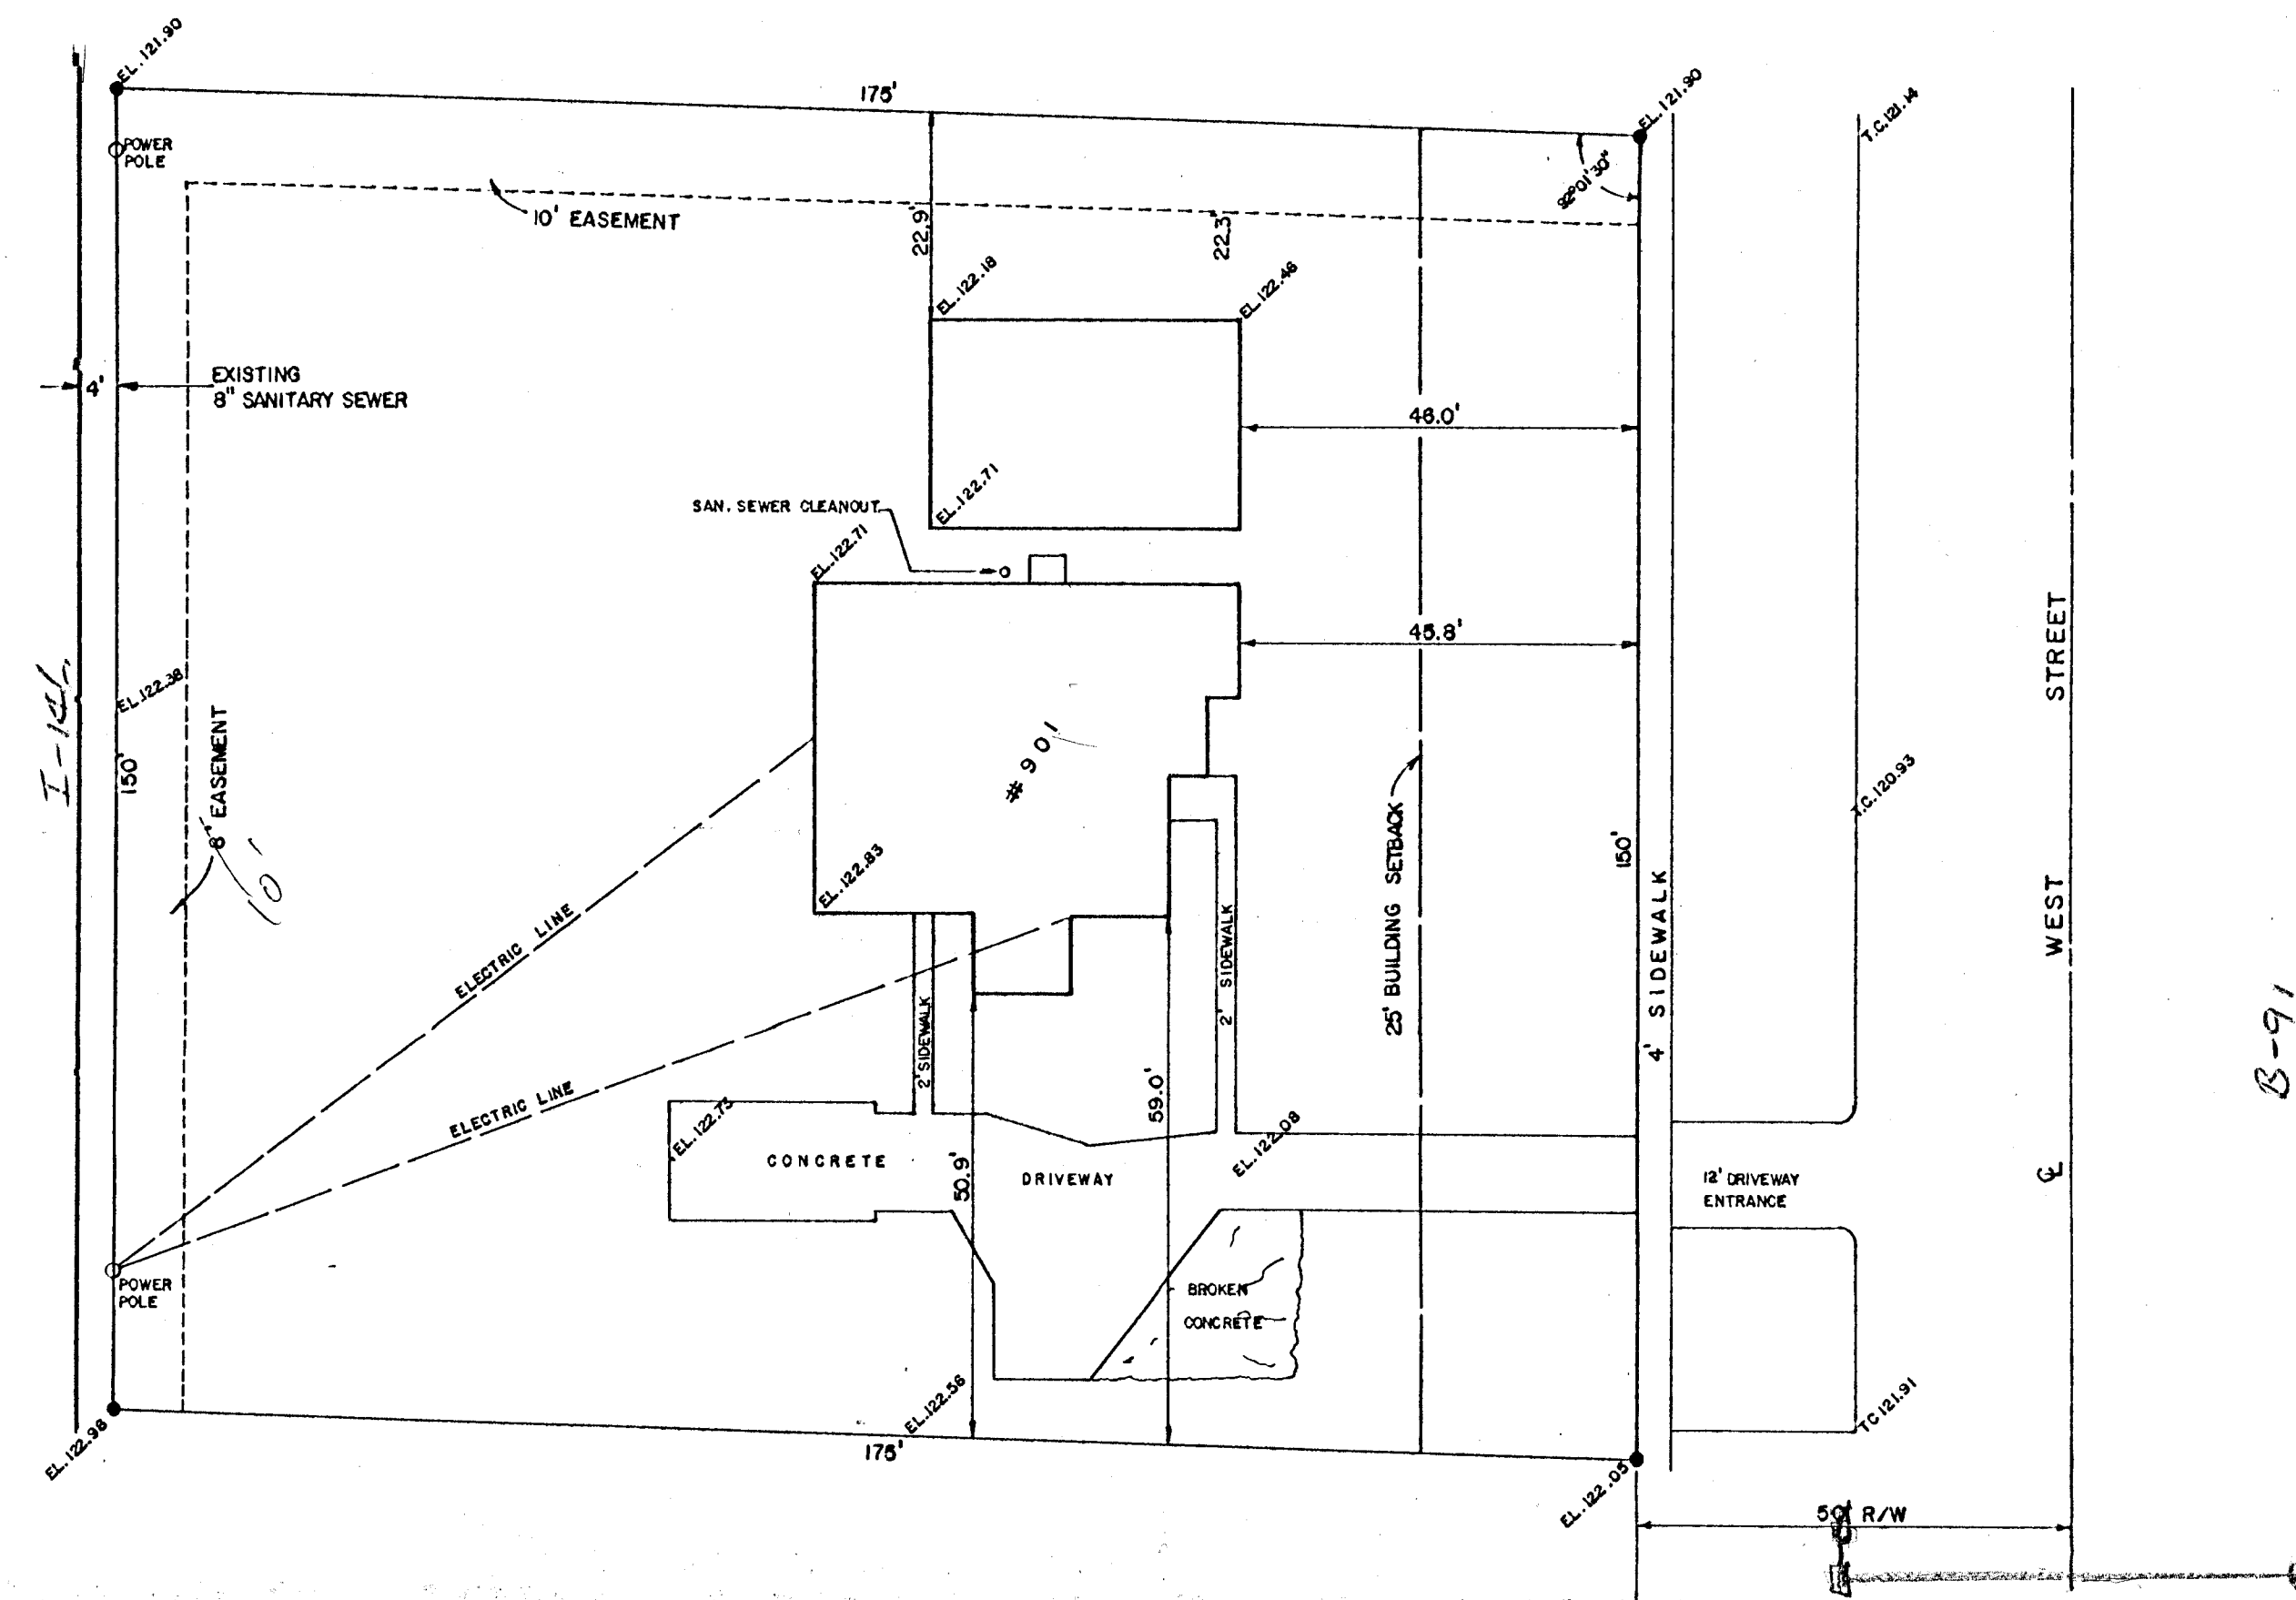

SKETCH PLAN AND SURVEY
OF EXISTING CONDITIONS
FISH POND WEST
WICHITA, SEDGWICK COUNTY, KANSAS

AIR CAPITOL LAND SURVEYORS

1987

BM. CITY OF WICHITA BENCH MARK DISC
24' S. & 52' W. OF & BOTH
EL. 121.89