



262-7271

721 263

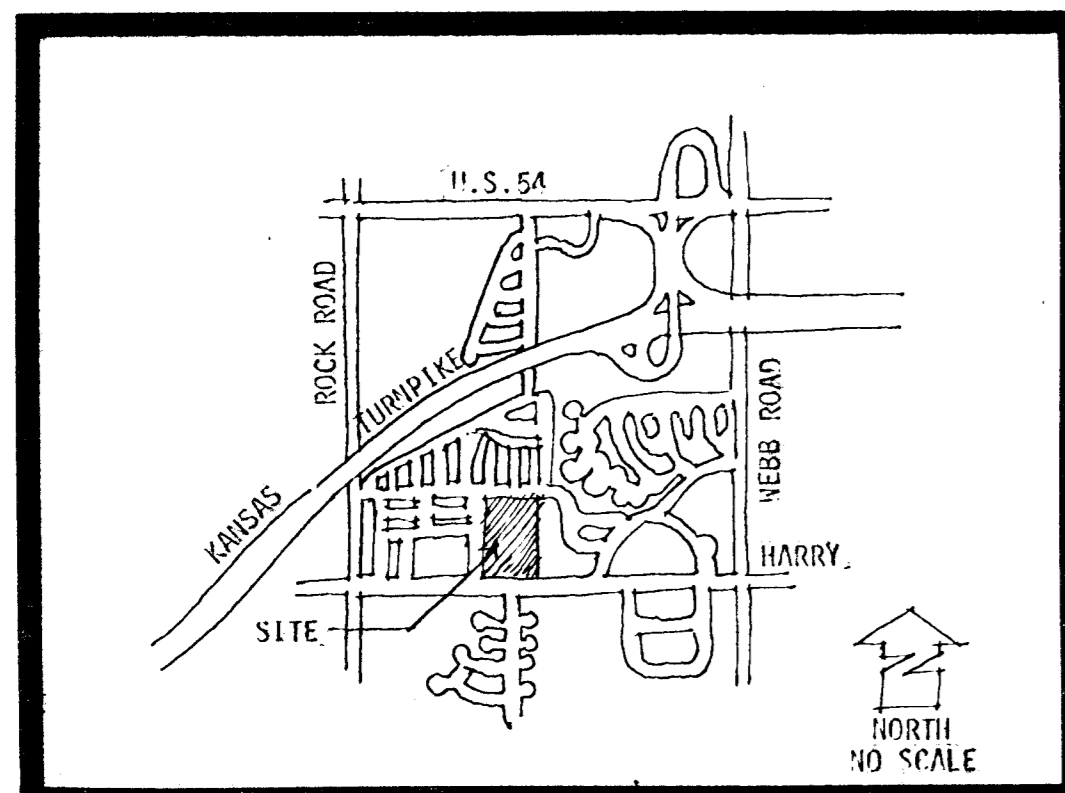

LOCATION MAP

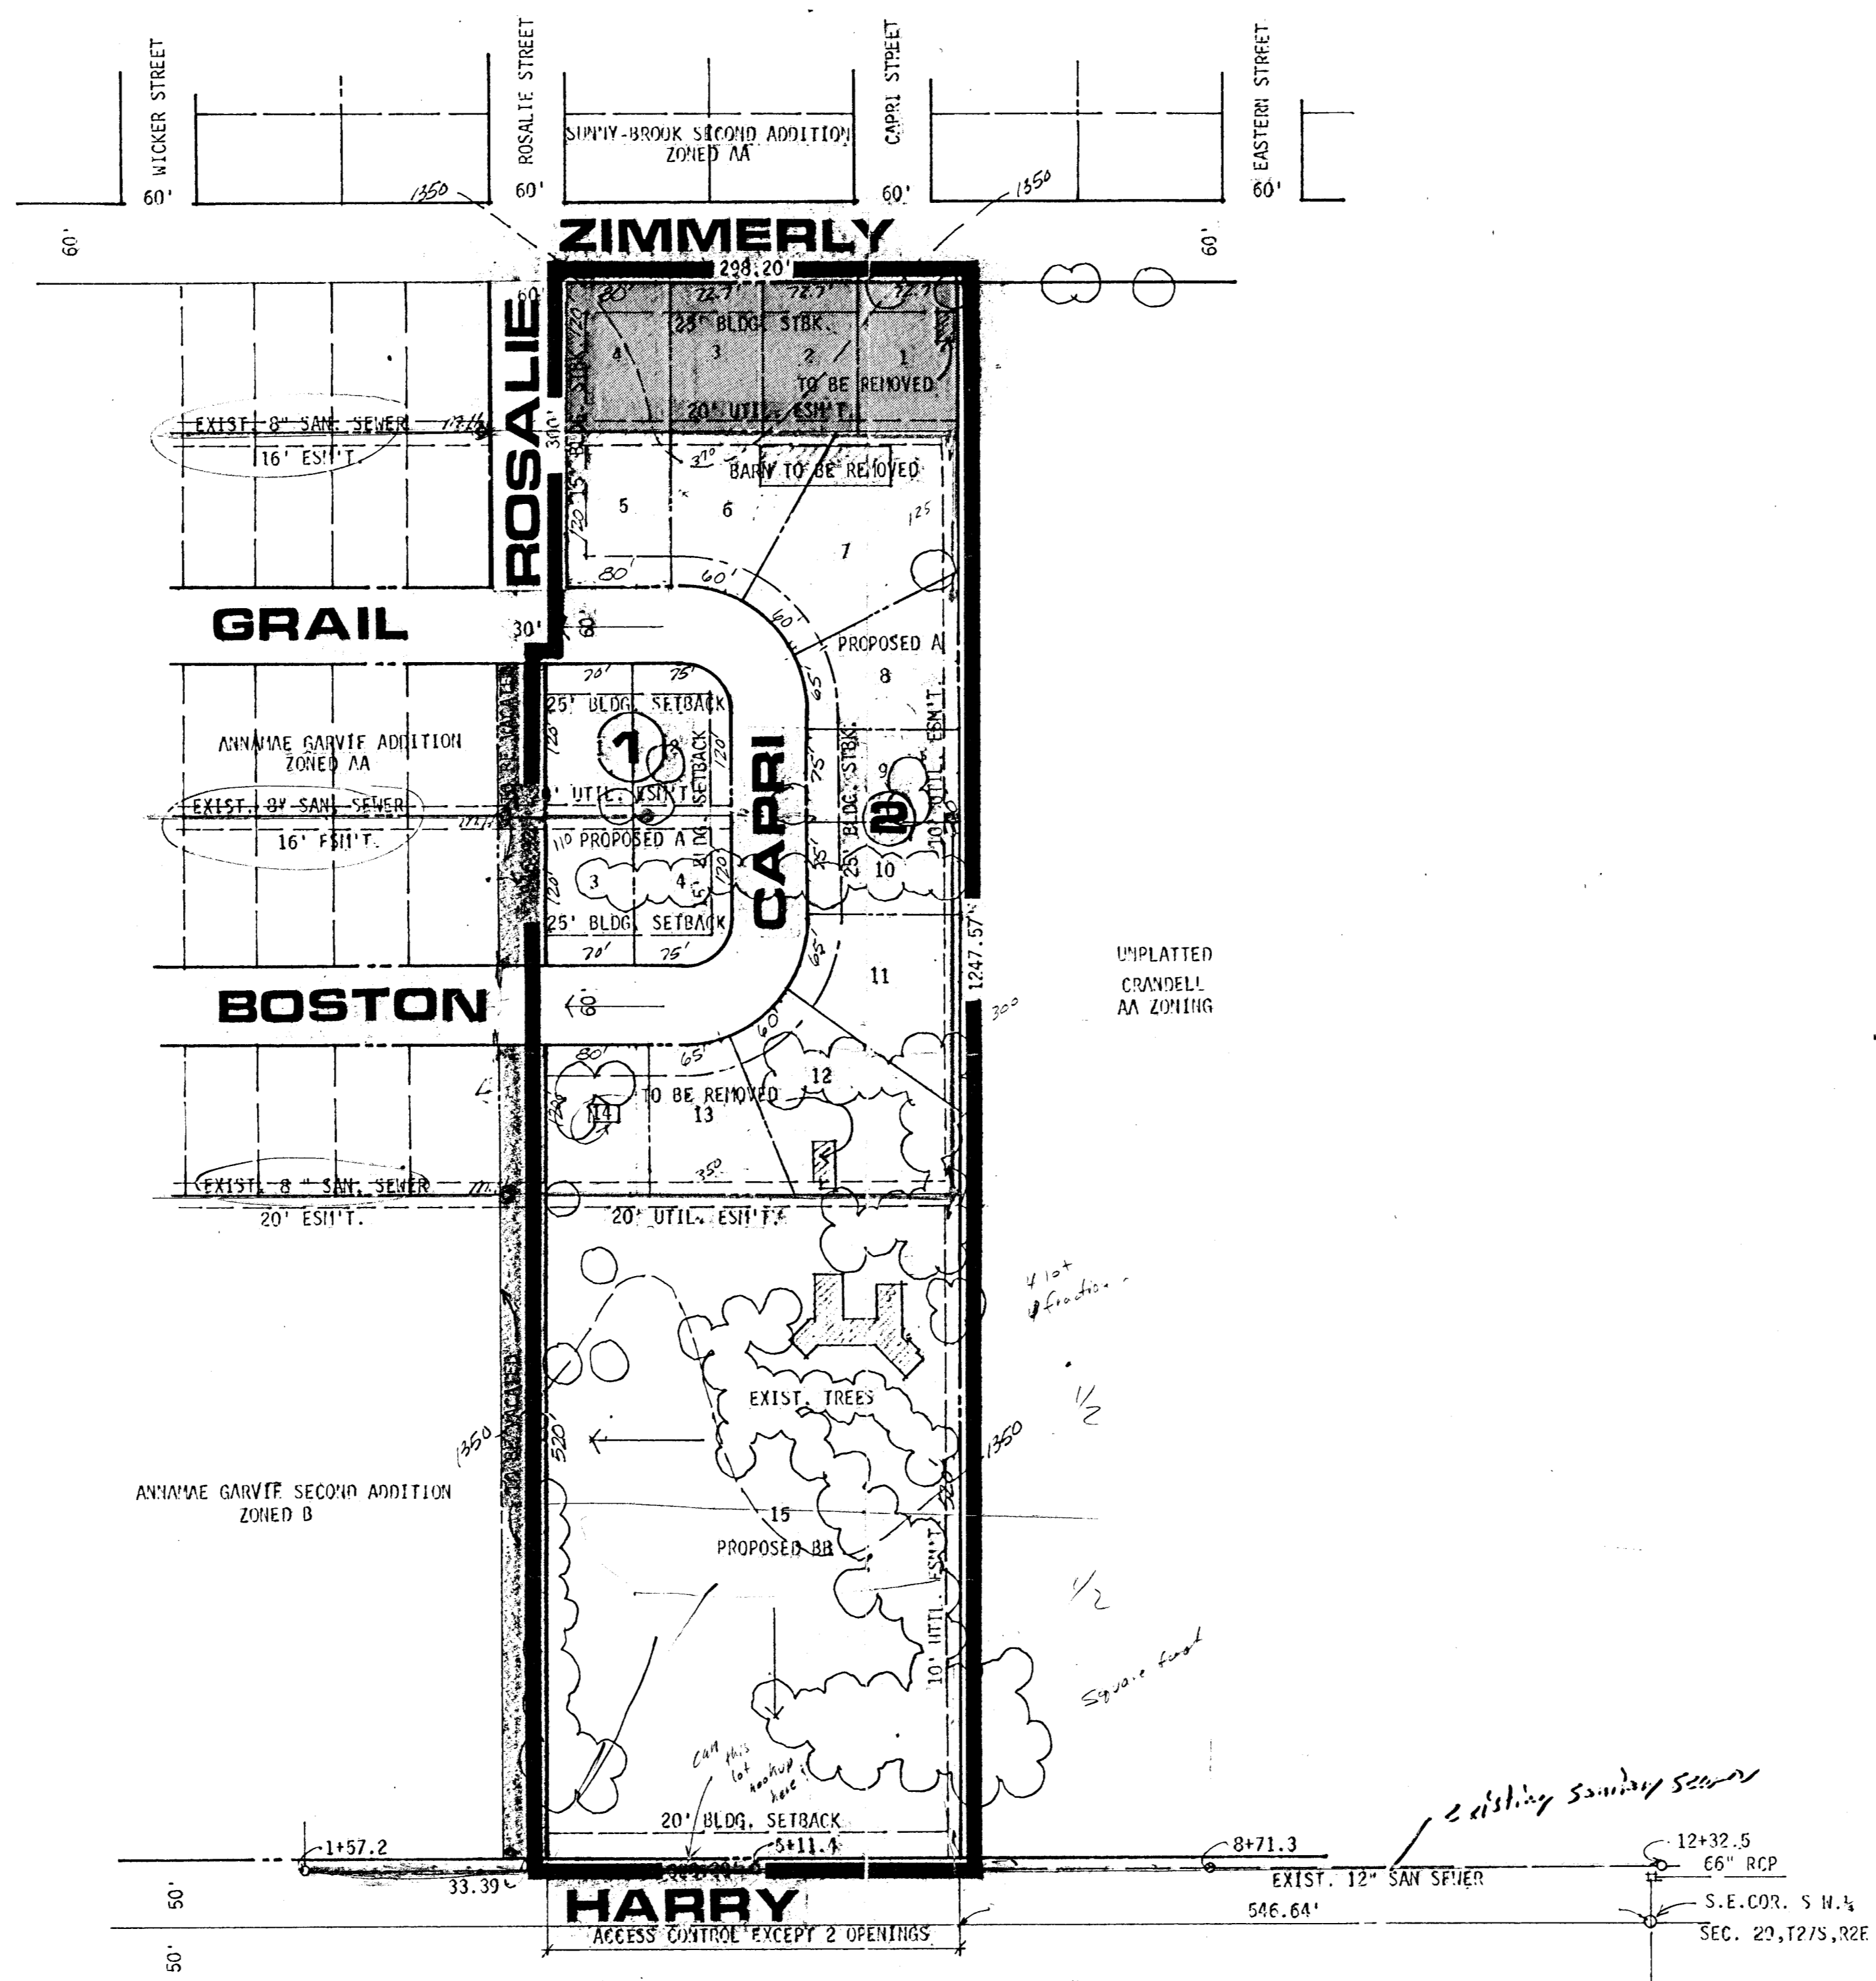


PRELIMINARY PLAT

GUY'S ADDITION

OWNER: CASADO INC. REALTORS, 236 S. TOPEKA, WICHITA, KANSAS

John McKey

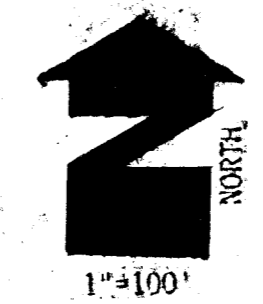

1"=100'



BILL G. YUNG DESIGN
 655 NORTH WACO, WICHITA, KANSAS, 67203
 316-264-0676

date DEC. 2, 1980
 rev. 20 OCT. 1981

sheet title
 PRELIMINARY PLAT

project
 GUY'S ADDITION

sheet
 of