



LATERAL 18  
 MID STATES CONSTR CO.  
 BK. NO. K-56 PR2

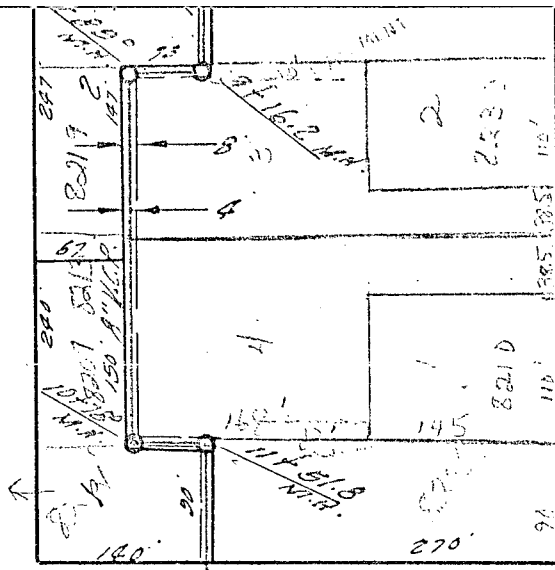

HEATHER RD

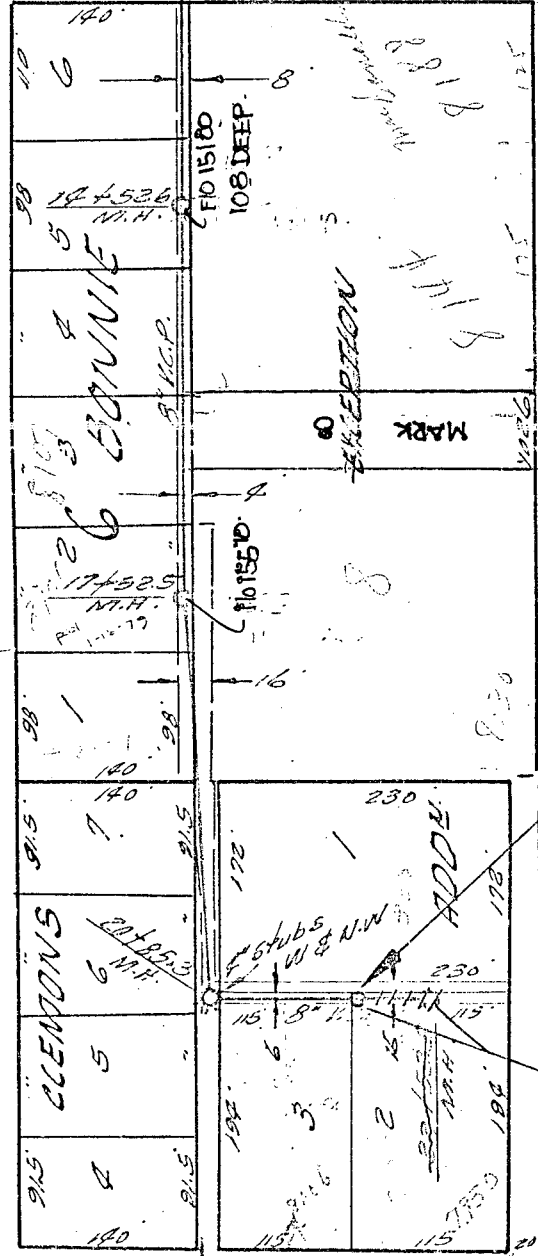

PEACH TREE

ROCK

KELLOGG (U.S. 54)

22400.8 NEW MH.  
 12-1-66  
 Per Sewer Insp.

J-16

This portion of sewer Abandoned.

ated  
 3-16-17

RD.  
 2016

10' 6" ...