




RIDGE

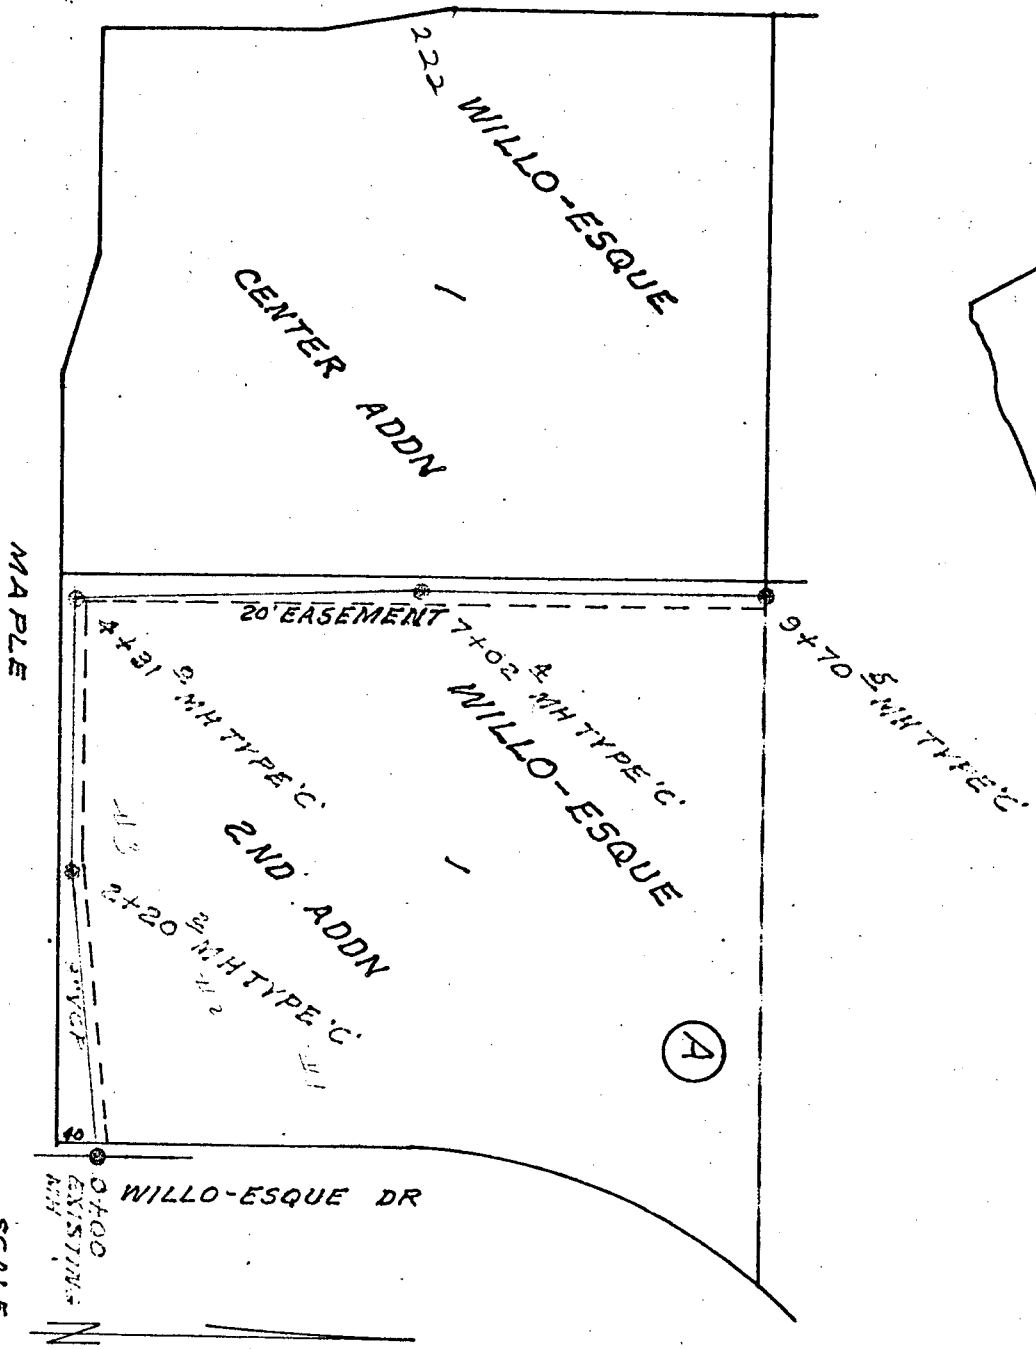

MAPLE

CENTER ADDN

WILLO-ESQUE

20' EASEMENT

WILLO-ESQUE

2ND ADDN

(A)

WILLO-ESQUE DR

SCALE 1"=150'

SCALE 1"=150'

N

LATERAL 1 MAIN & SOU  
BUILT BY: WBCARTER  
PROJ. NO DBKL573001  
BOOKED 2-25-76 FF