


N.E. 1/4 SEC. 19. TWP. 27 R. 1W

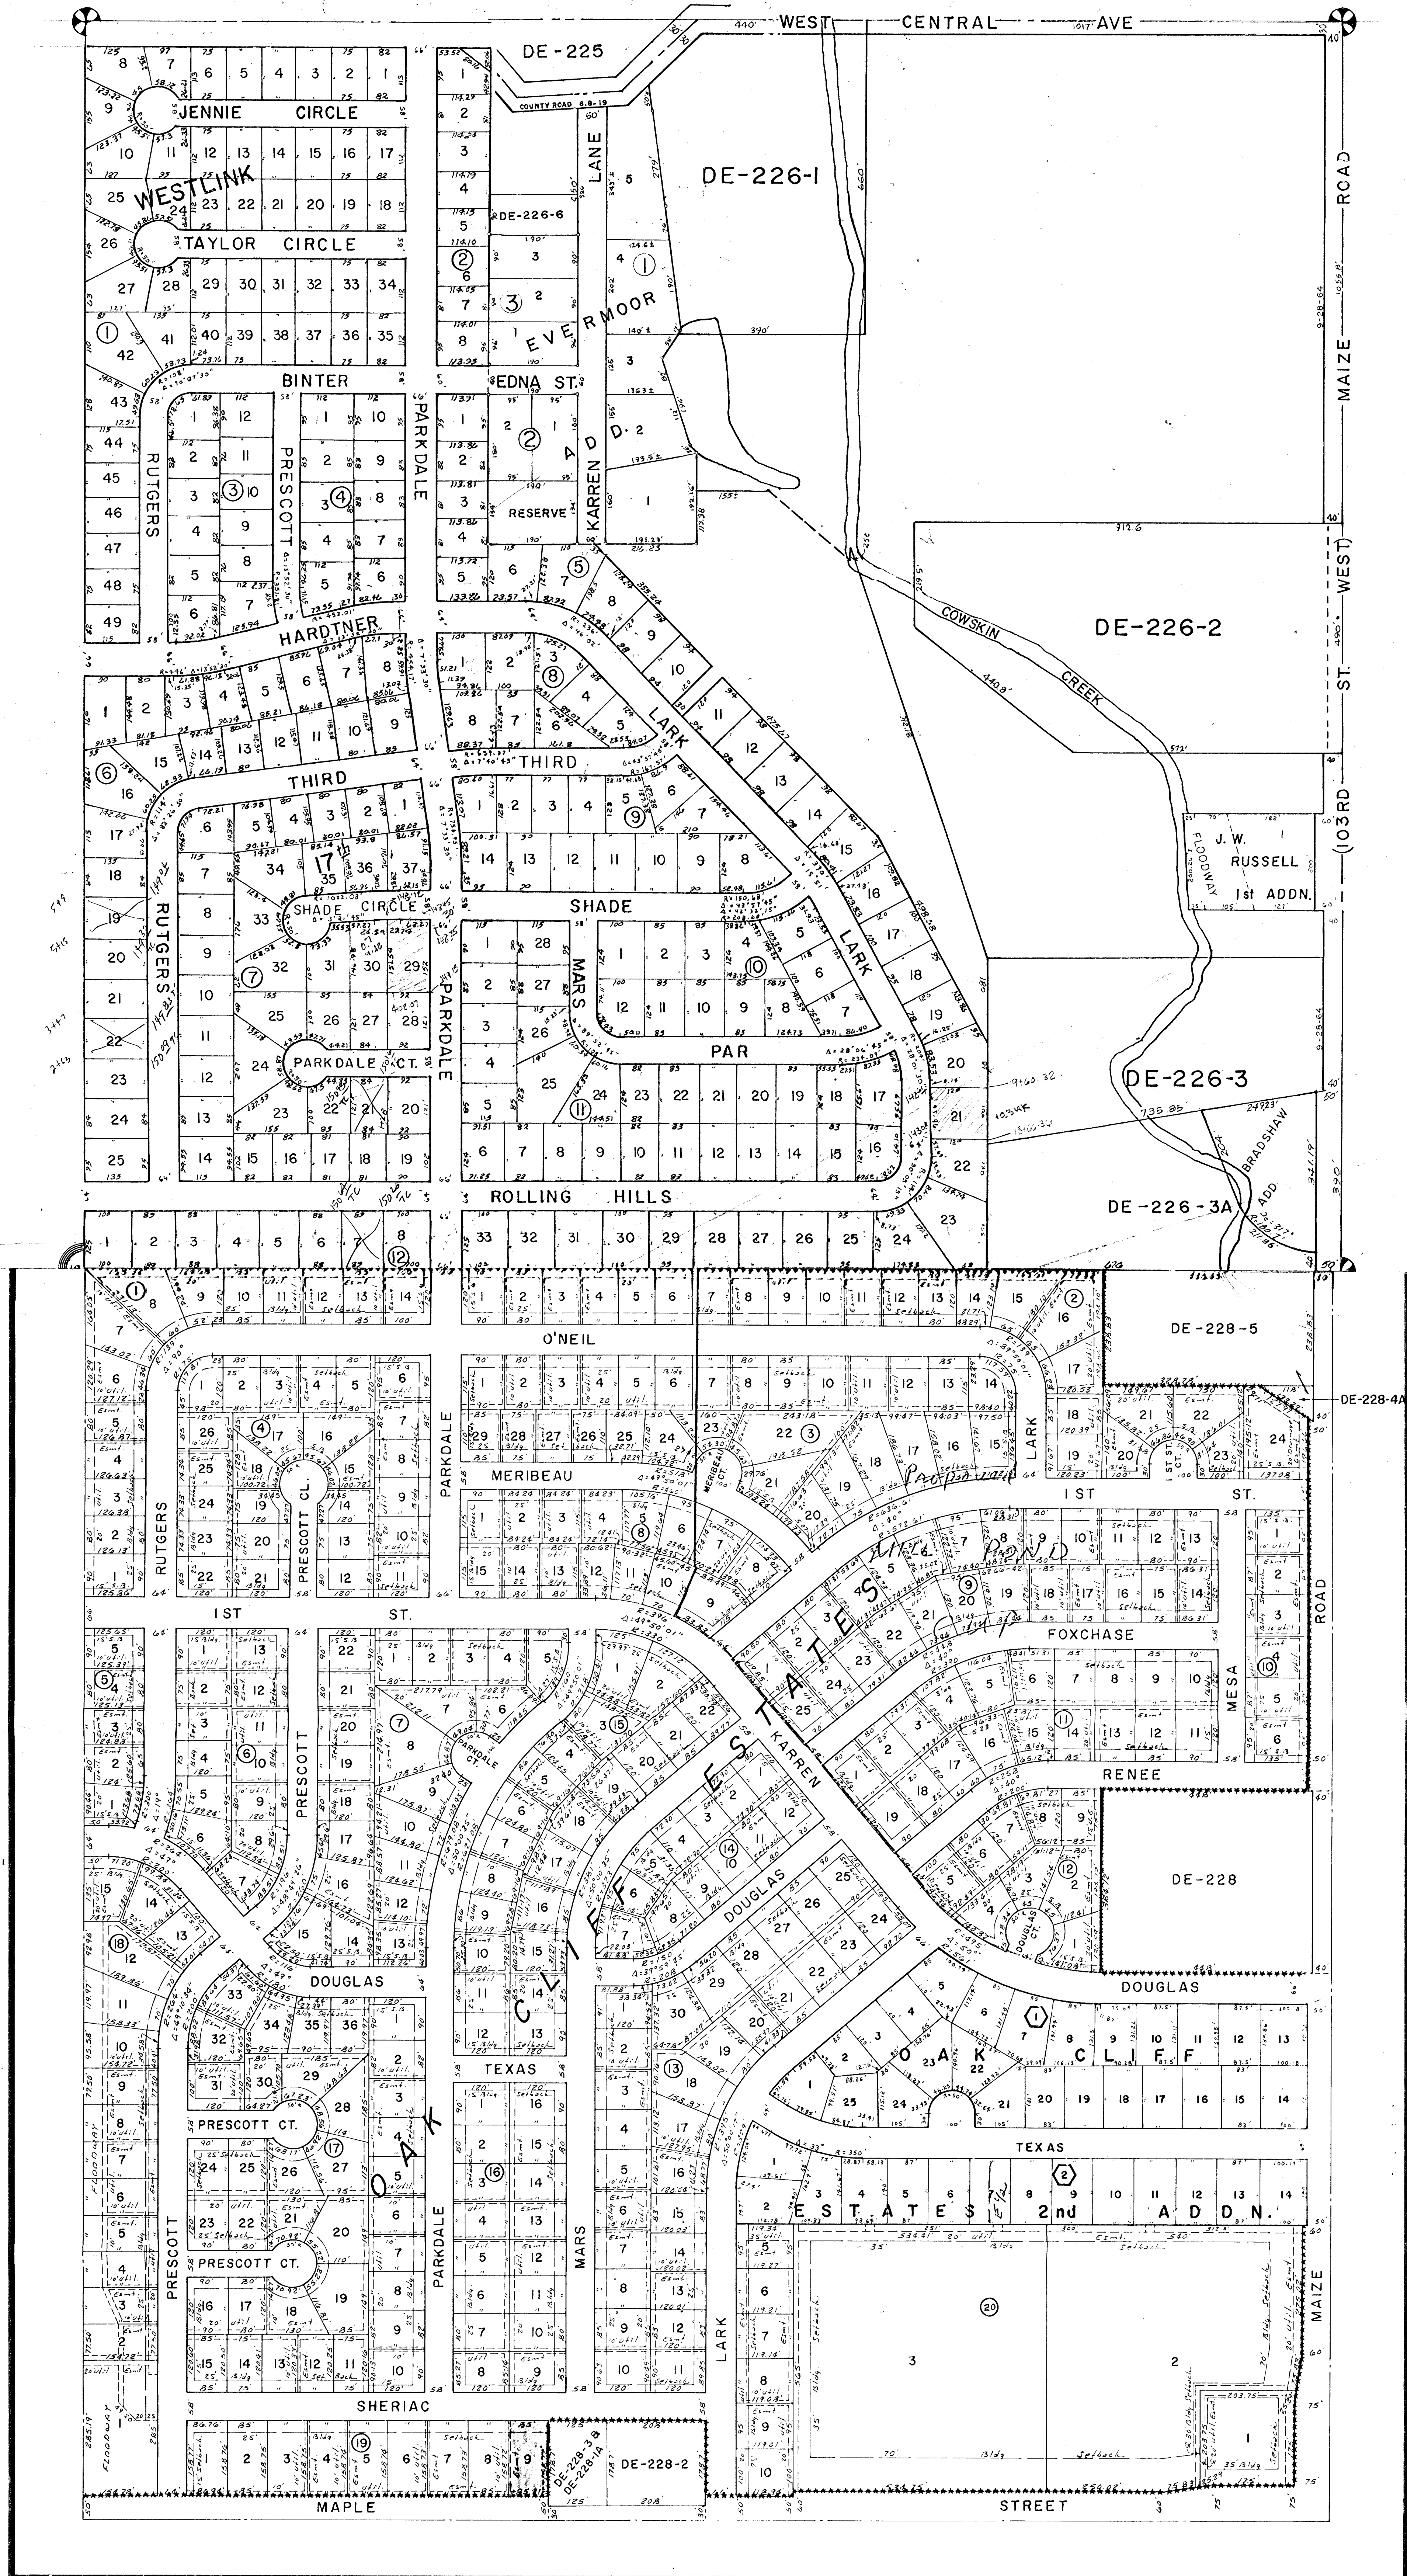

This should be 1' from East Block
 due to 1/4" error