

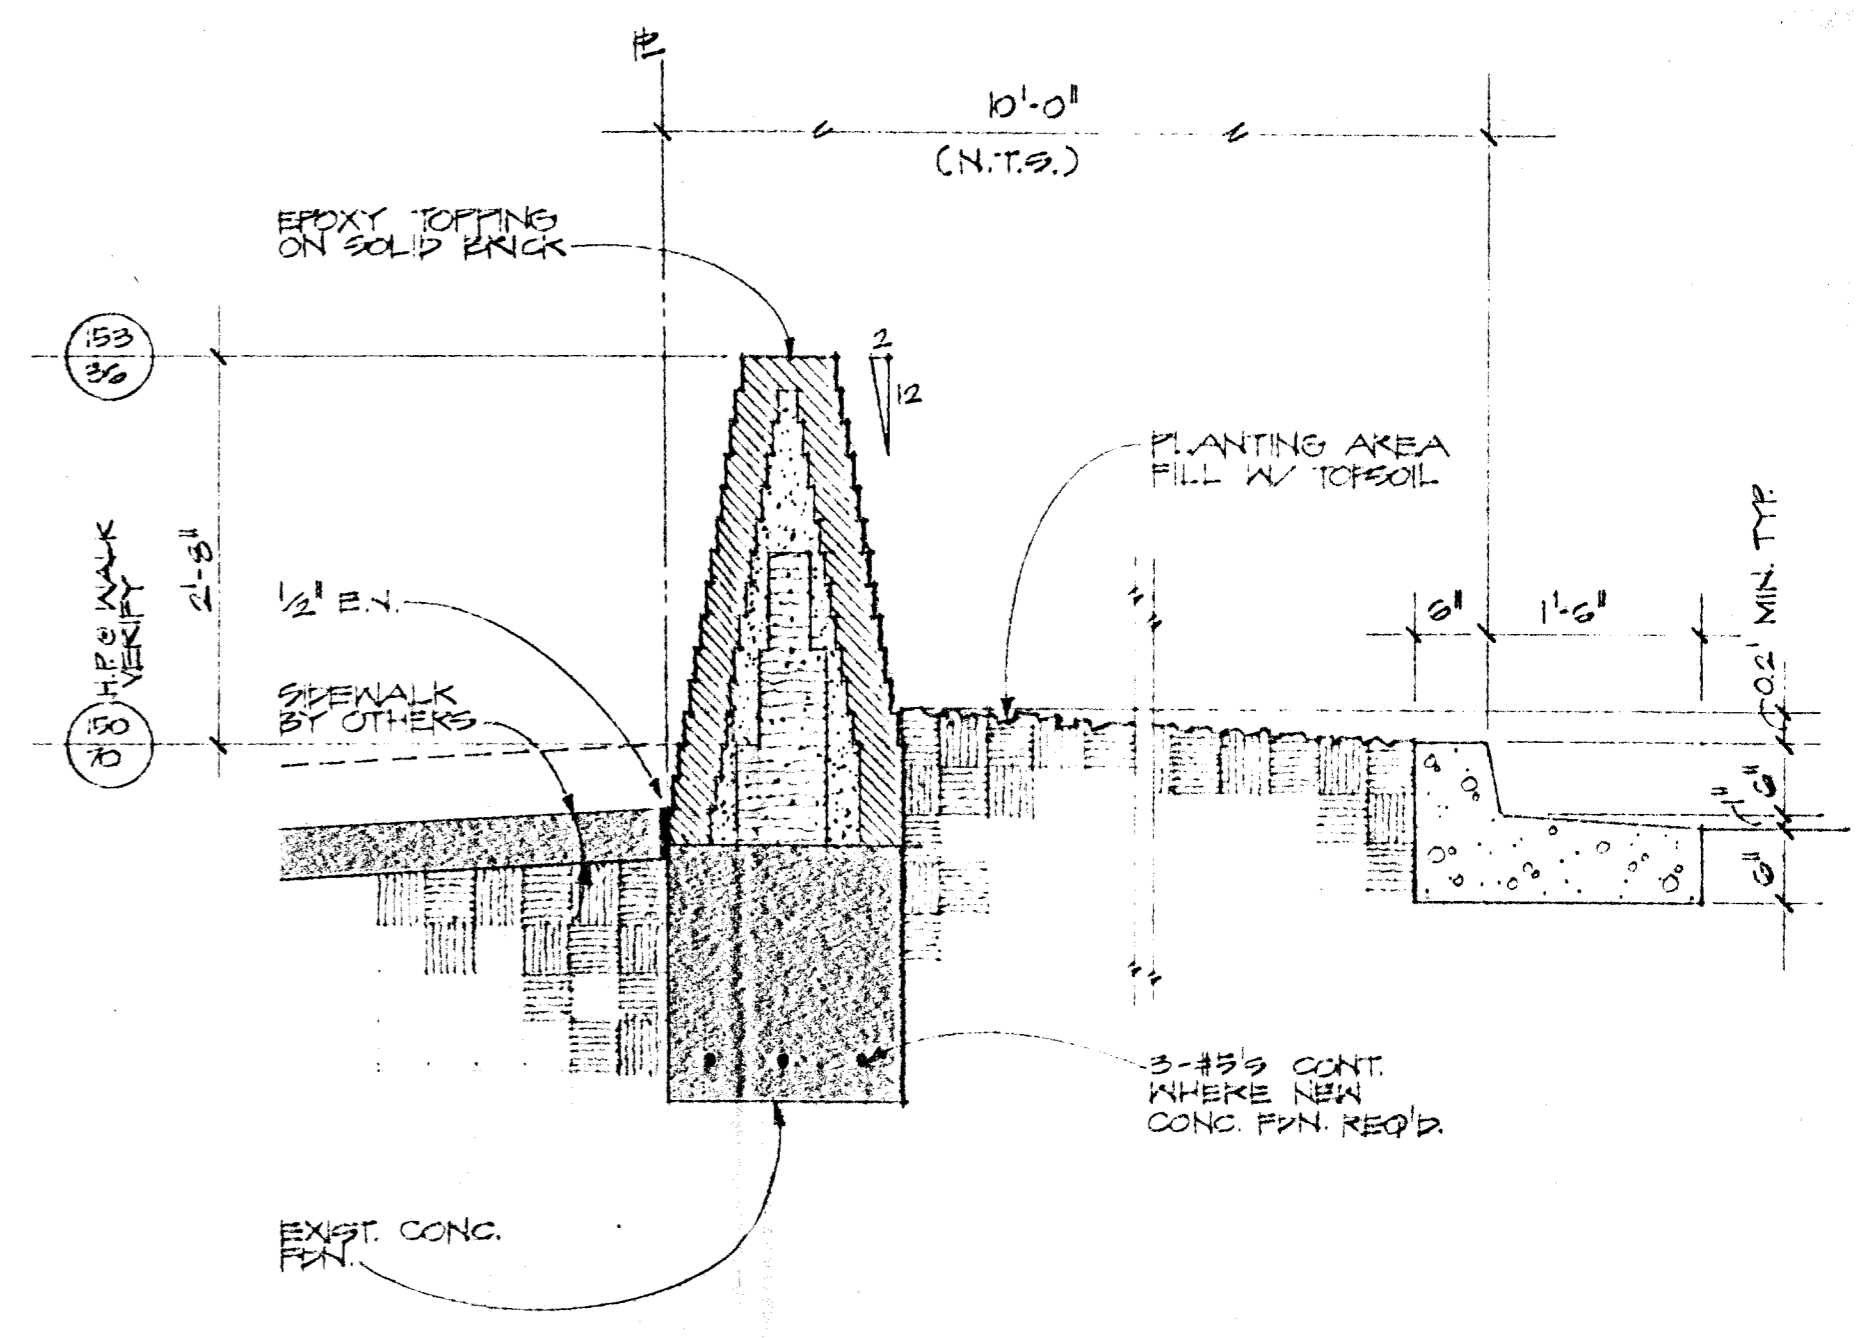
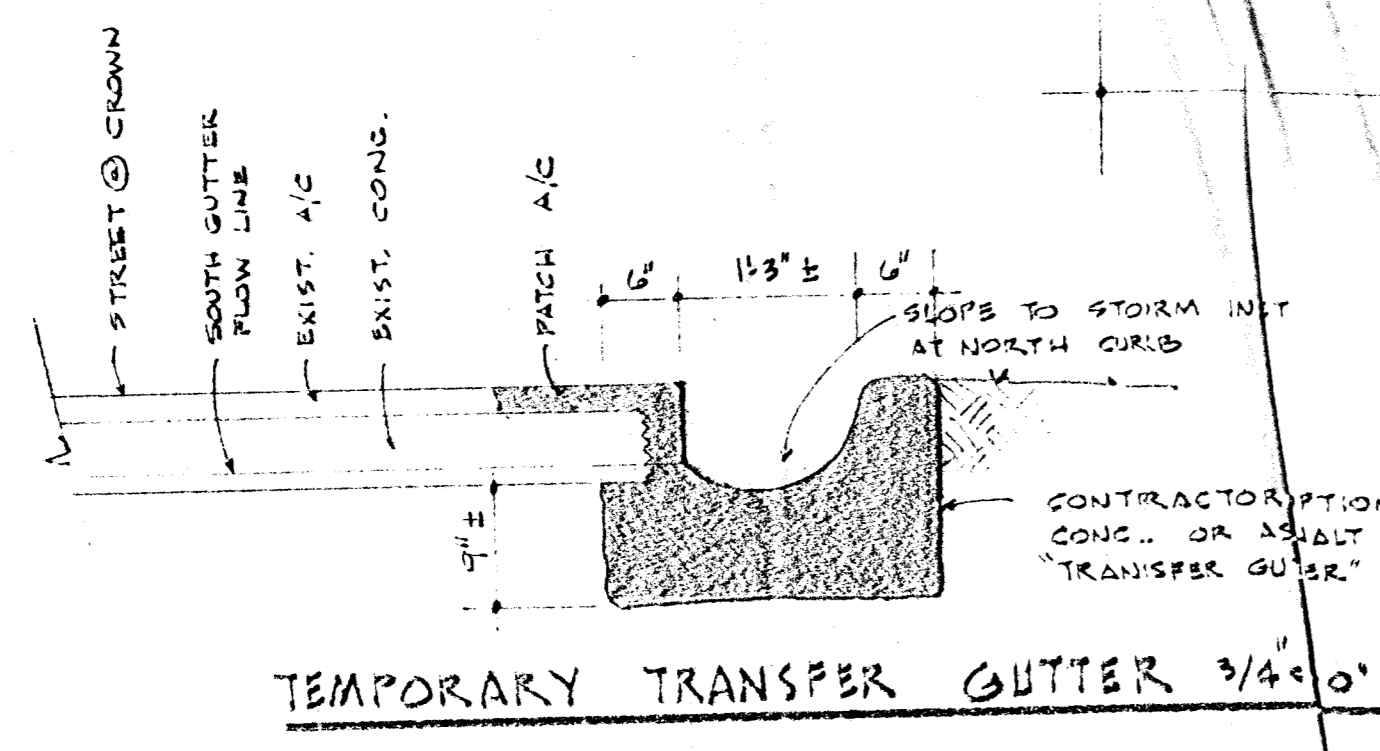


GENERAL NOTES

- ① PROVIDE ELECTRIC SERVICE TO LIGHT FIXTURES, PARKING CONTROL EQUIP. ETC. AS REQ'D AND NOTED ON THE SITE PLAN.
- ② NEW LIGHT FIXTURES (3 THIS) SHALL BE PRESOLITE #5712 W/ 1-WHO T-12 LAMP ORAL ACRYLIC DIFFUSER, HEAD AND FITTINGS ALL ALUMINUM LOW TEMP BALLAST, HOUSING #1/2" PEGS BRASS COVER. PROVIDE BRASS FINISHED ALUMINUM IN COLOR AS SELECTED MOUNTING HEIGHT 11'-0" - CONCRETE BASES AS REQ'D BY MFG. AND FURNISHED BY GC.
- ③ ALL DIMENSIONS, RADII, ETC. ARE TO FACE OF CURB.
- ④ ALL NEW WALKS SHALL BE 4" CONCRETE (CITY MIX) W/ 0-6 #3/#3 IN. I.F. OVER 3" COMPACTED SAND FILL MATCH FINISH WHERE NEW WALK IS ADJACENT TO EXISTING.
- ⑤ PROVIDE 1/2" EXPANSION JOINT MATERIAL BETWEEN BACKSIDE OF CONCRETE CURB AND WALKS, AND BETWEEN EXISTING WALKS AND NEW WALKS. PROVIDE WITHIN NEW WALKS AT MAXIMUM 20' ± O.C.
- ⑥ LOCATE CONTROL JOINTS AS INDICATED ON SITE PLAN AT 3' ± O.C.
- ⑦ ALL NEW WALKS, PAVING AND CURBS SHALL CONFORM TO EXISTING DIRECTION OF SLOPES FOR PROPER SURFACE DRAINAGE. VERIFY ALL ELEVATIONS THAT DEVIATE FROM THOSE SHOWN ON THE SITE PLAN.
- ⑧ ALL NEW CONC. CURBS SHALL MATCH EXISTING PROFILE (DEPTH, WIDTH ETC.) AND SHALL BE CITY MIX.
- ⑨ ALL NEW COMBINED CURB AND GUTTER SHALL BE CITY MIX - STANDARD OR REVERSE BUTTER AS REQ'D FOR FLOW OF SURFACE DRAINAGE.
- ⑩ VERIFY DEPTH AND LOCATION OF ALL UNDERGROUND UTILITIES BEFORE EXCAVATION WORK.
- ⑪ ALL ELEVATIONS ARE FINISH GRADE OF PAVING OR FLOW LINE BUTTER.

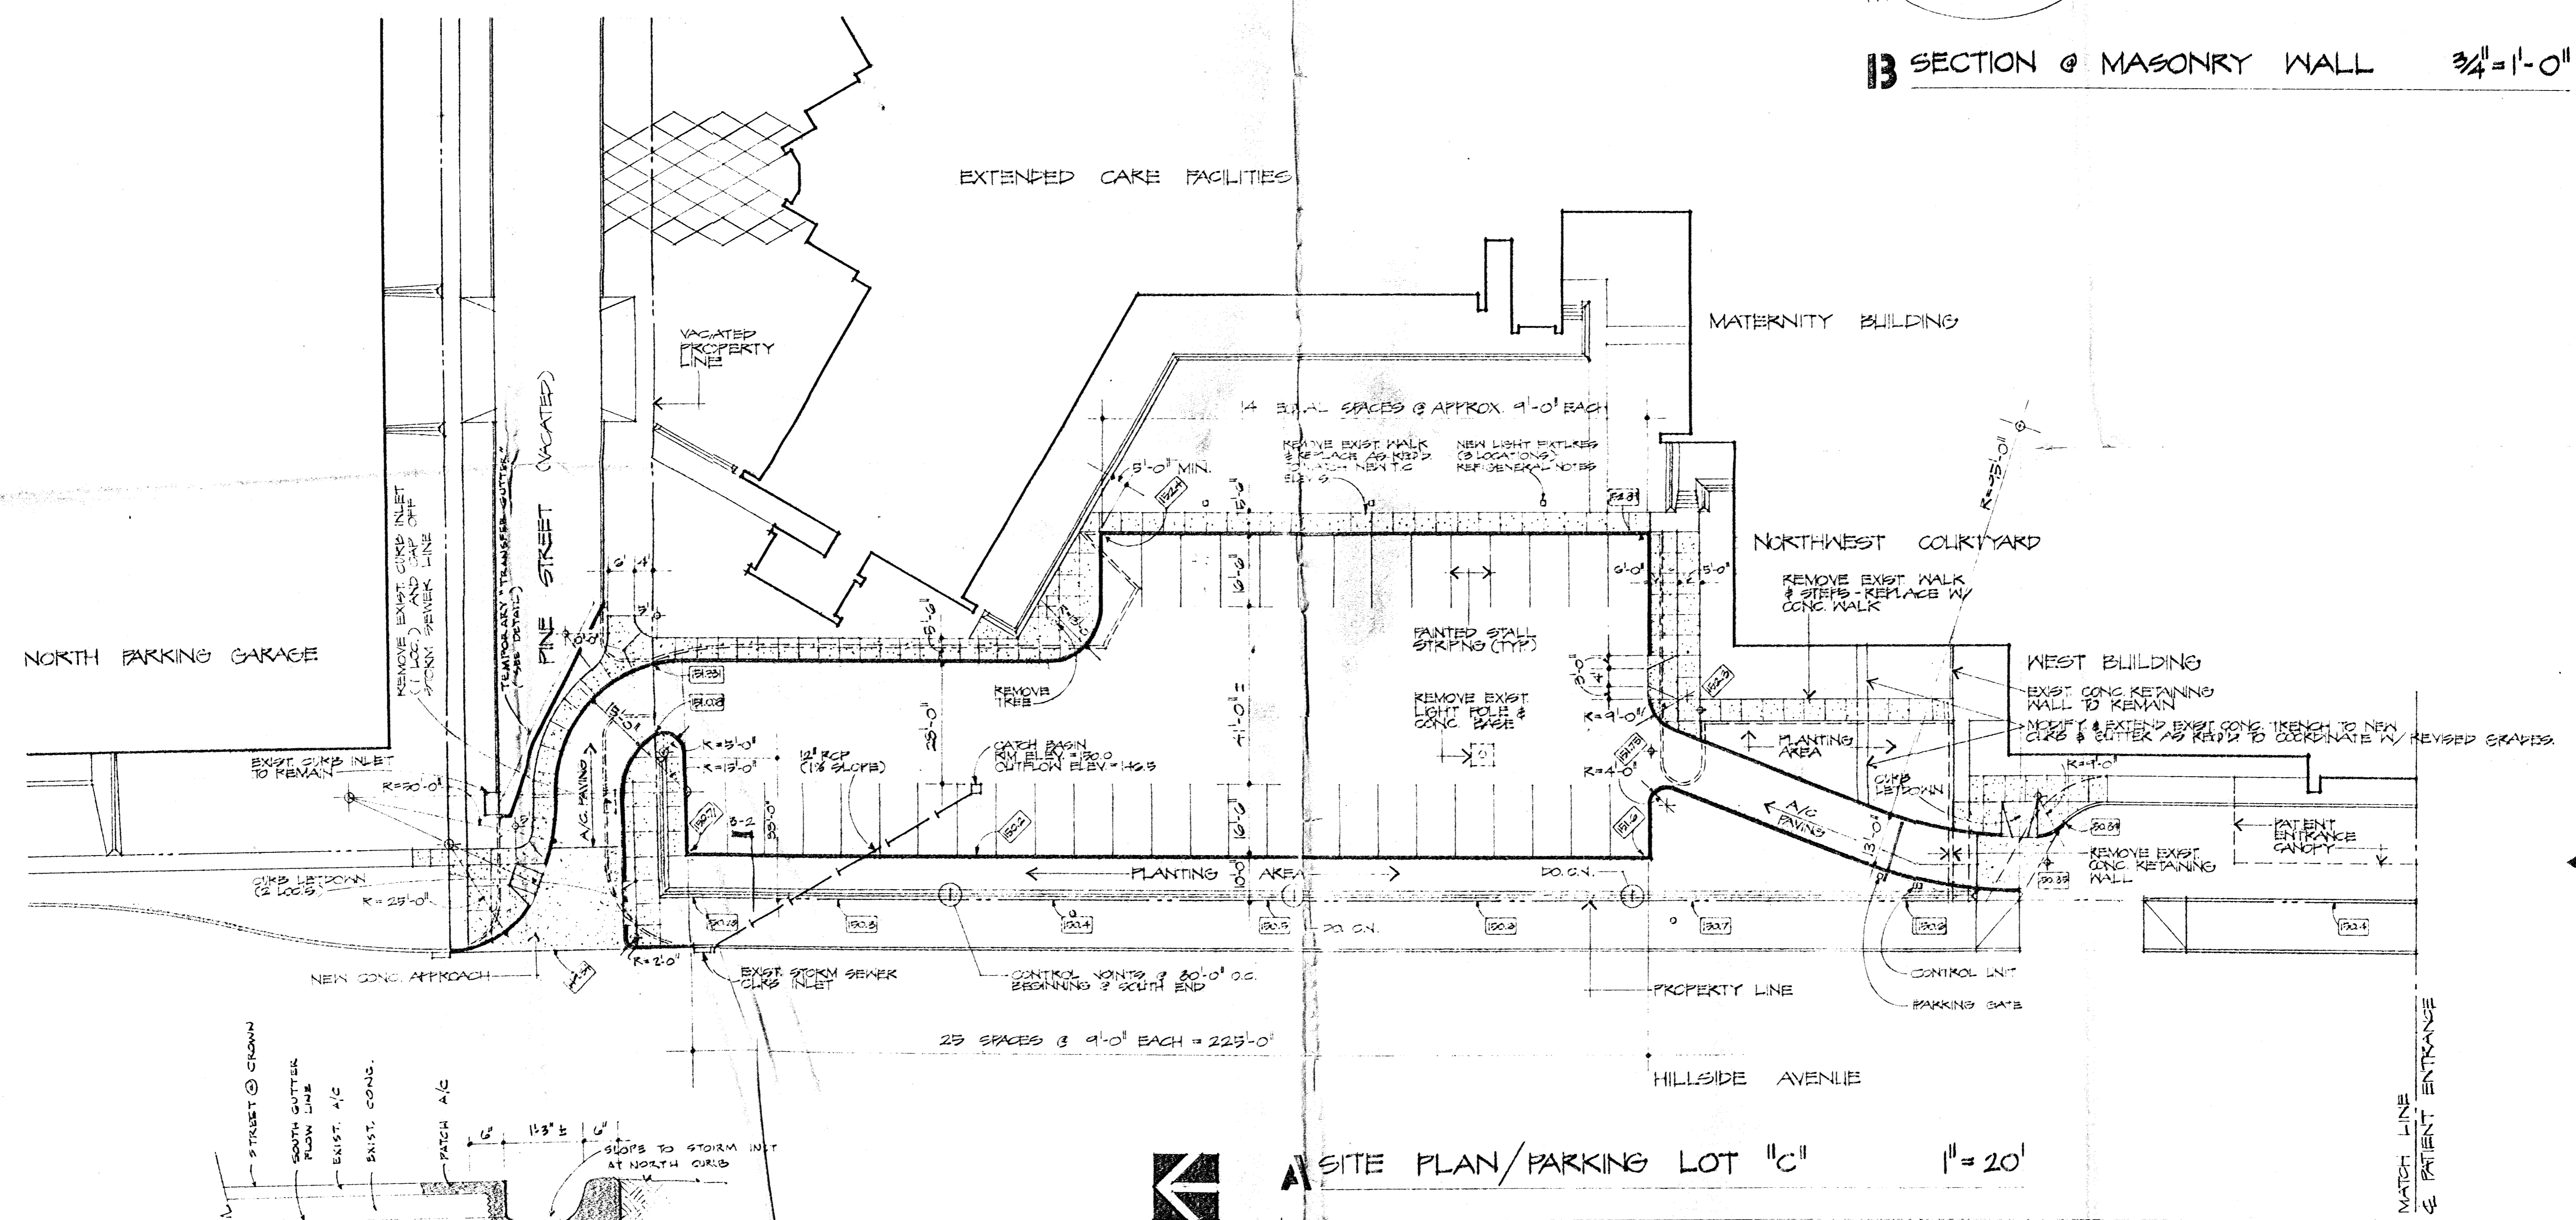

B SECTION @ MASONRY WALL 3/4" = 1'-0"

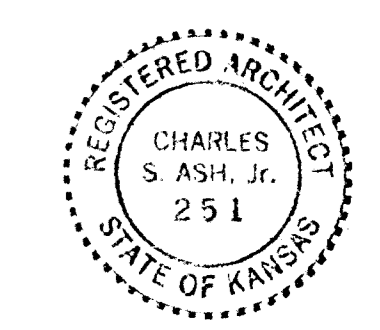


Handwritten note: Driveways Approved. 5/10/76 [Signature]

A SITE PLAN/PARKING LOT "C" 1" = 20'

LEGEND	
	EXISTING CURB & GUTTER TO REMAIN
	EXISTING CURB & GUTTER TO BE REMOVED
	NEW CURB & GUTTER
	EXISTING FINISH GRADE (VERIFY)
	NEW FINISH GRADE
	EXISTING SIDEWALK TO REMAIN
	NEW SIDEWALK

THOMAS, HARRIS, ASH & MASON ARCHITECTS & ENGINEERS
262 NORTH WACO WICHITA, KANSAS 67202 (316) 262-2444

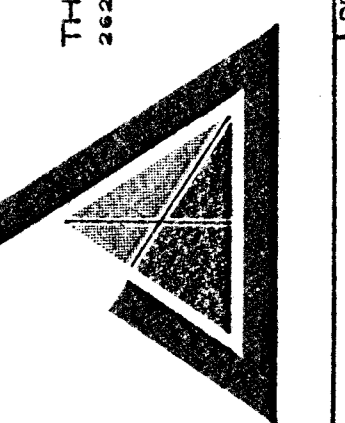

HILLSIDE LOTS PARKING REVISIONS CENTER KANSAS
NEBLEY MEDICAL WICHITA

PROJECT NO.	44-22-70
DATE	5-7-76
REVISIONS	
DRAWN	KT
CHECKED	
DESIGN CHECK	
SMC CHECK	
MADE CHECK	