


DOUGLAS

X-347

AVE.

Reconst. Portion W. Sub. 933.
W.B. Carter - Contr.
BK-F. - Proj. No. C12-72
Booked Sept. 8, 1952.

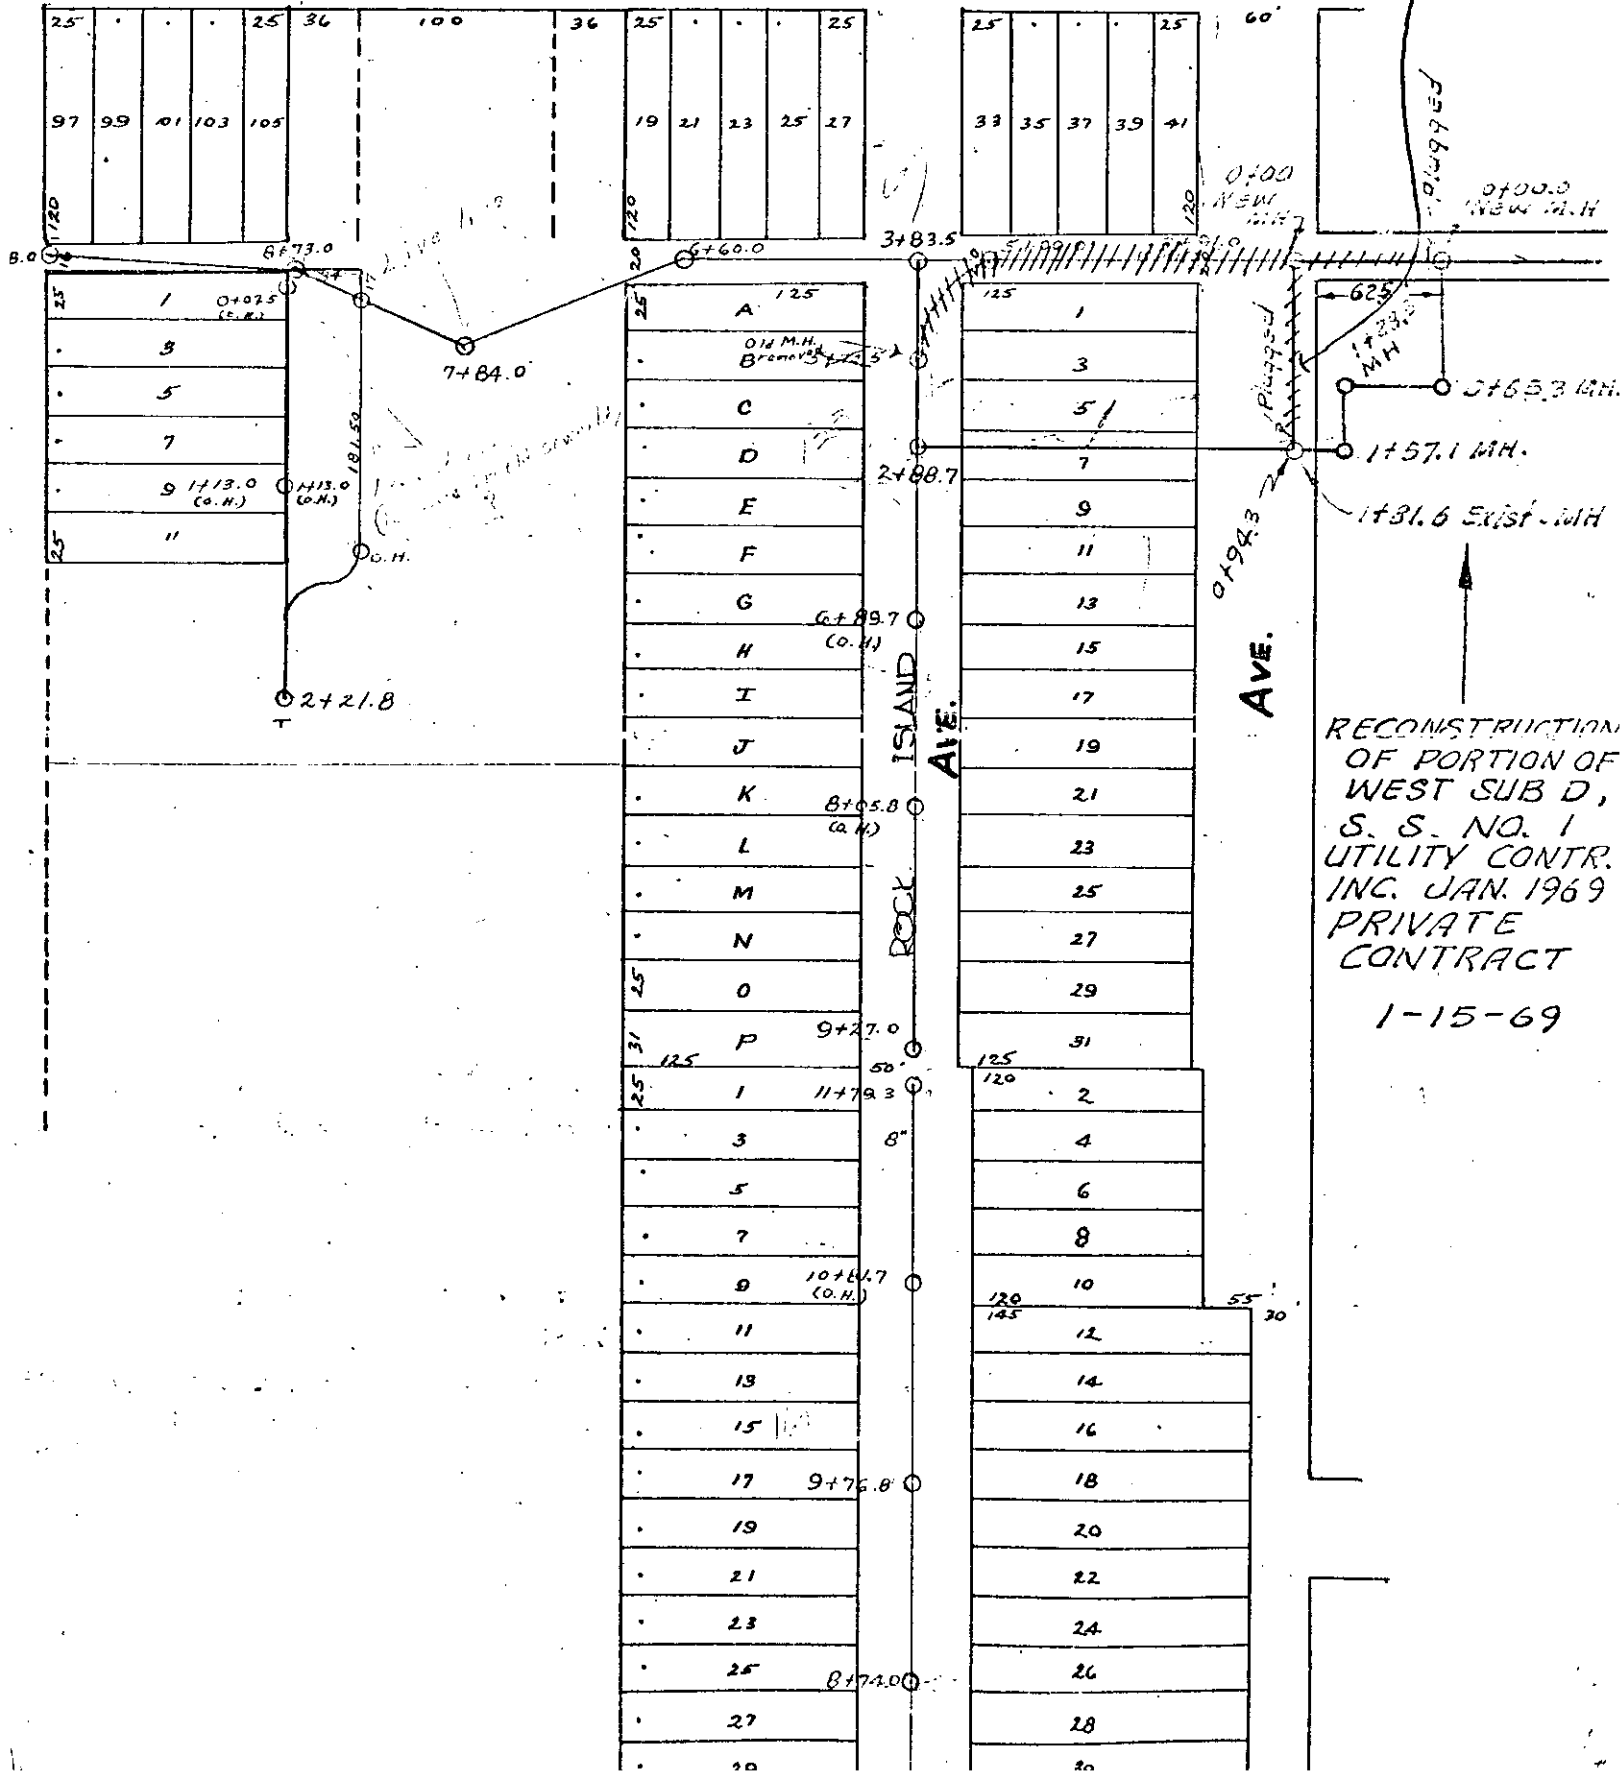


RECONSTRUCTION
OF PORTION OF
WEST SUB D,
S. S. NO. 1
UTILITY CONTR.
INC. JAN. 1969
PRIVATE
CONTRACT
1-15-69

DOUGLAS

VACATED STREET

ROCK ISLAND

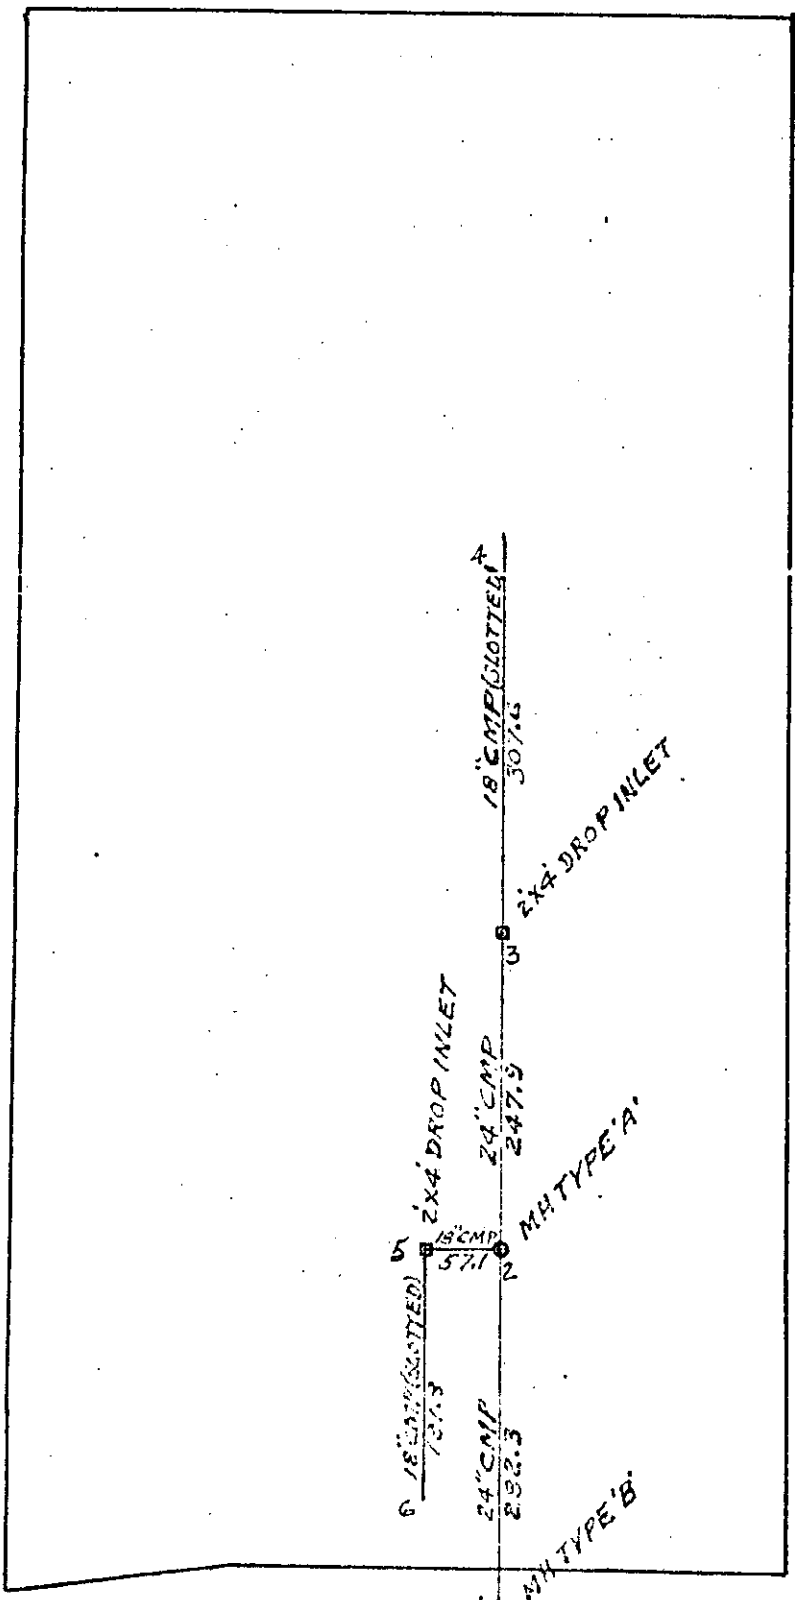

SCALE 1"=150'

