


PLAN
 SURVEYED BY: _____ DATE: _____
 PLOTTED BY: _____
 NOTE BOOK No. _____
 ALIGNMENT CHECKED BY: _____
 R. OF PLAN CHECKED BY: _____

PROFILE
 SURVEYED BY: _____ DATE: _____
 PLOTTED BY: _____
 NOTE BOOK No. _____
 STRUCTURE NOTATIONS CHECKED BY: _____

ARTKANSAS RIVER

Scale: 1" = 10'

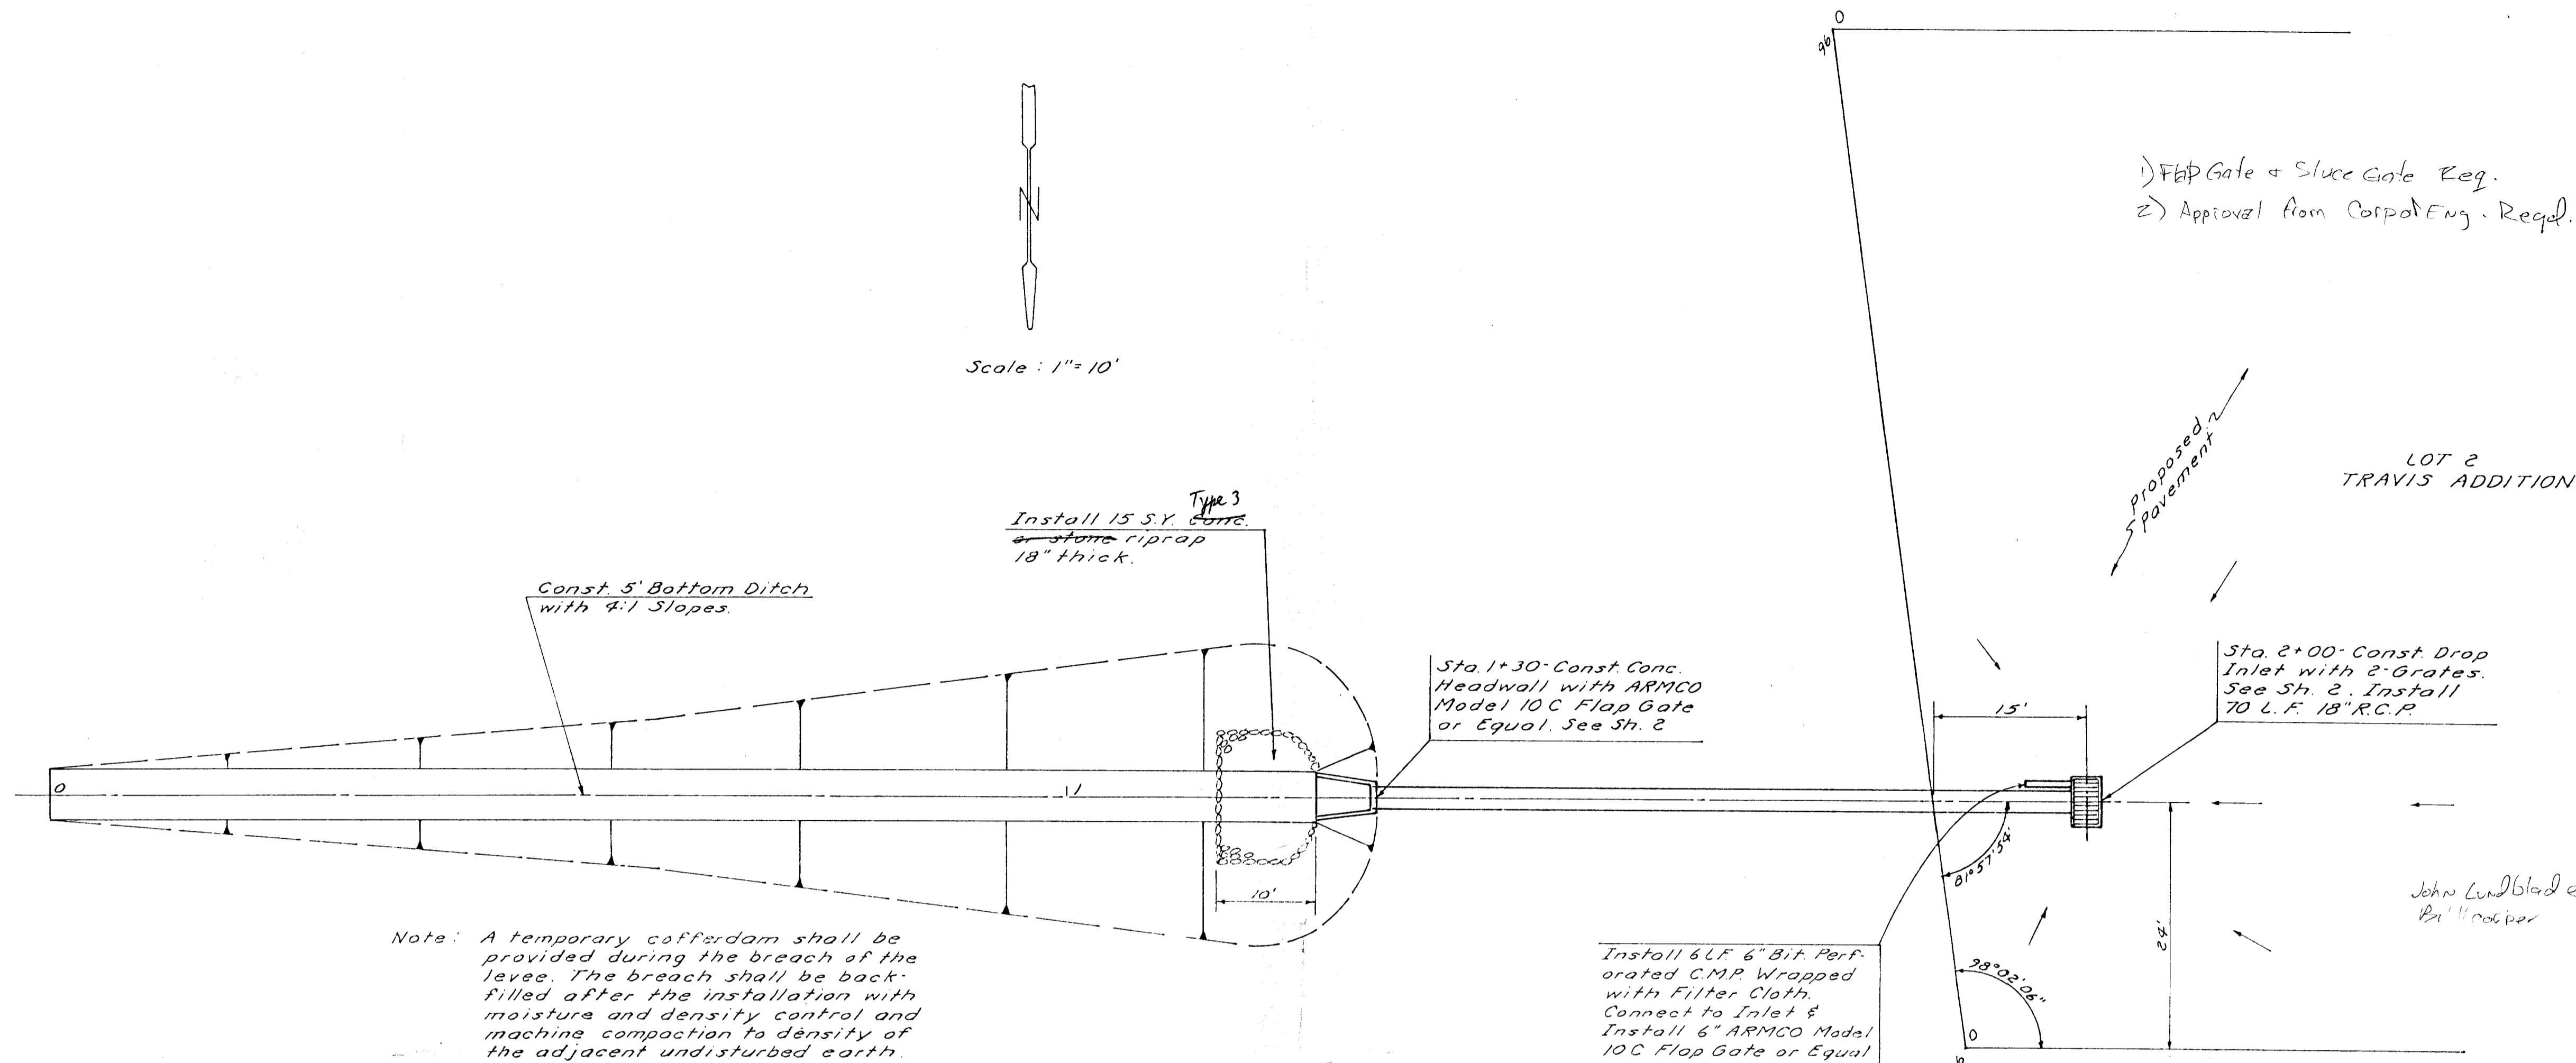

Note: A temporary cofferdam shall be provided during the breach of the levee. The breach shall be back-filled after the installation with moisture and density control and machine compaction to density of the adjacent undisturbed earth.


Install 6 LF 6" Bit Perforated C.M.P. Wrapped with Filter Cloth. Connect to Inlet & Install 6" ARMCO Model 10C Flap Gate or Equal See Sh. 2

- 1) Flap Gate + Sluice Gate Req.
- 2) Approval from Corpal Eng. Req'd.

LOT 2 TRAVIS ADDITION

John Lundblade
 2 1/2" notes per

B.M. "X" cut west side handrail @ N. end John Mack Br. - E1.103.14 (city datum)

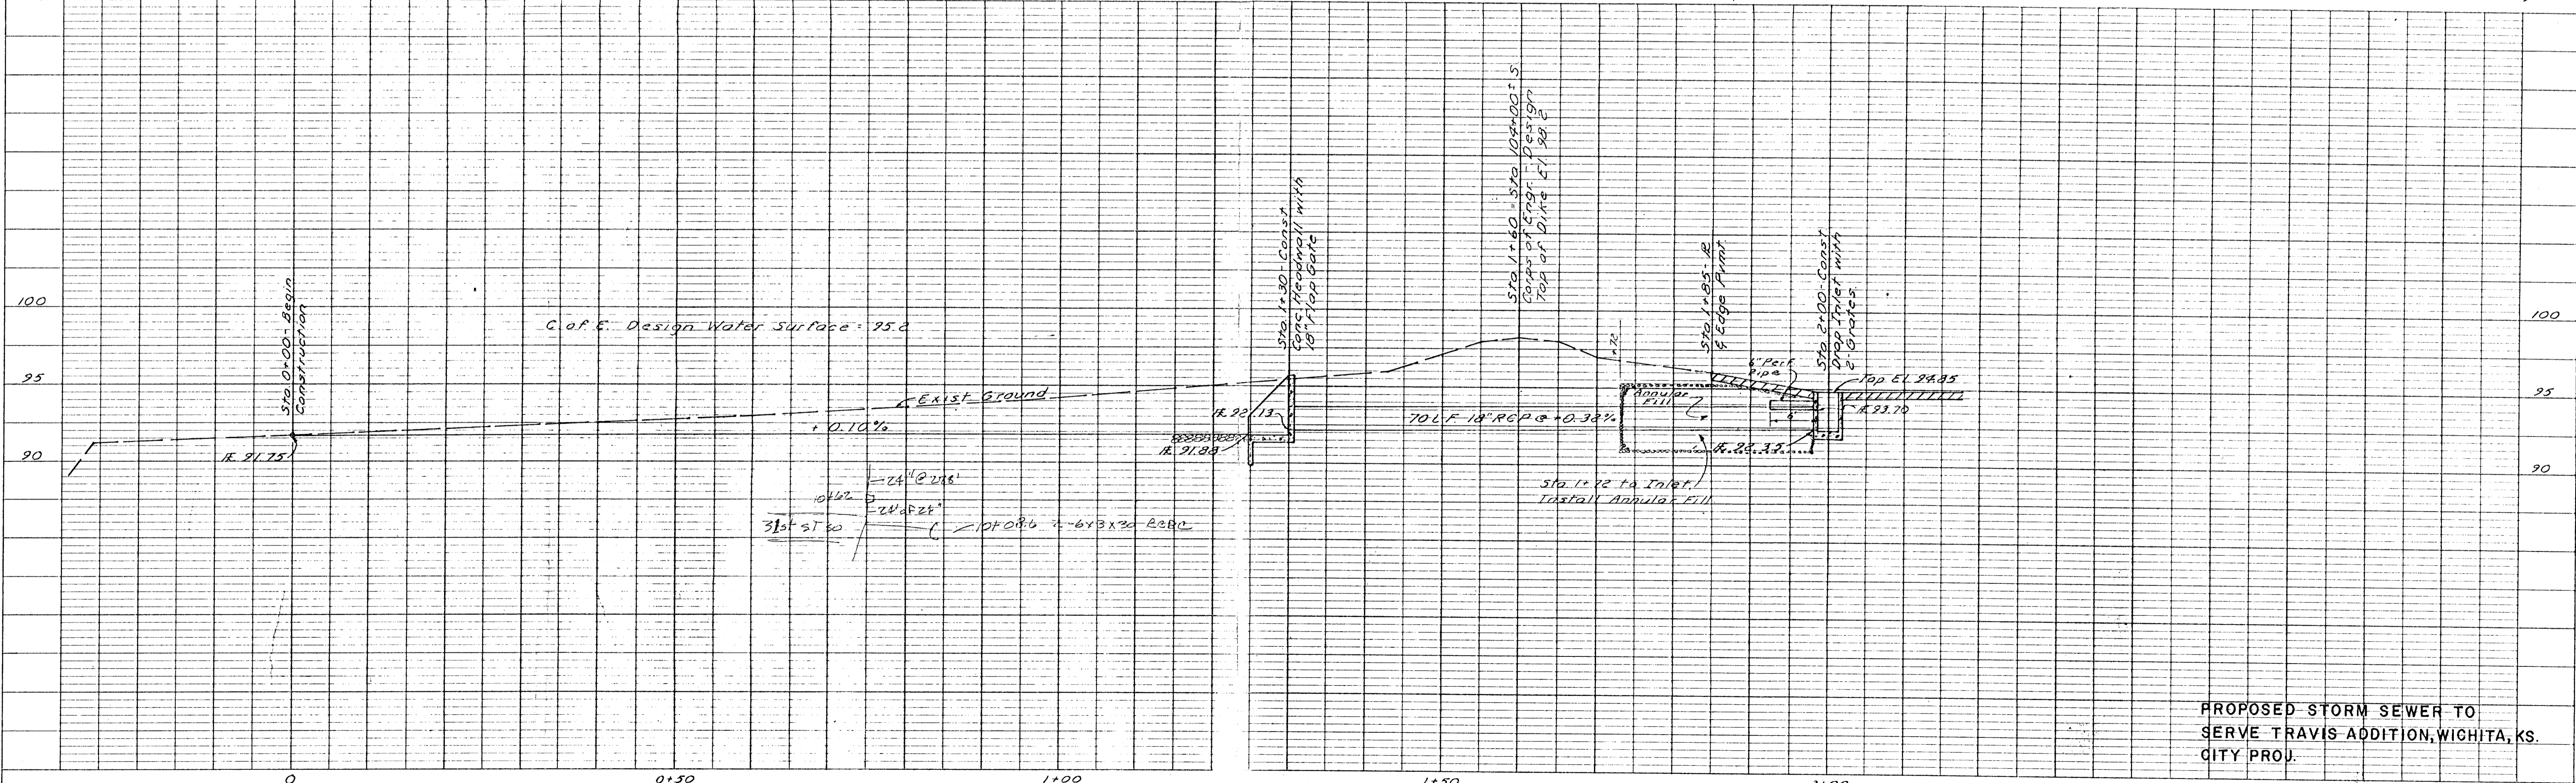

PROPOSED STORM SEWER TO SERVE TRAVIS ADDITION, WICHITA, KS. CITY PROJ.