


2nd
CROSS CREEK ADDITION

WEBB ROAD
COMPLETE ACCESS CONTROL

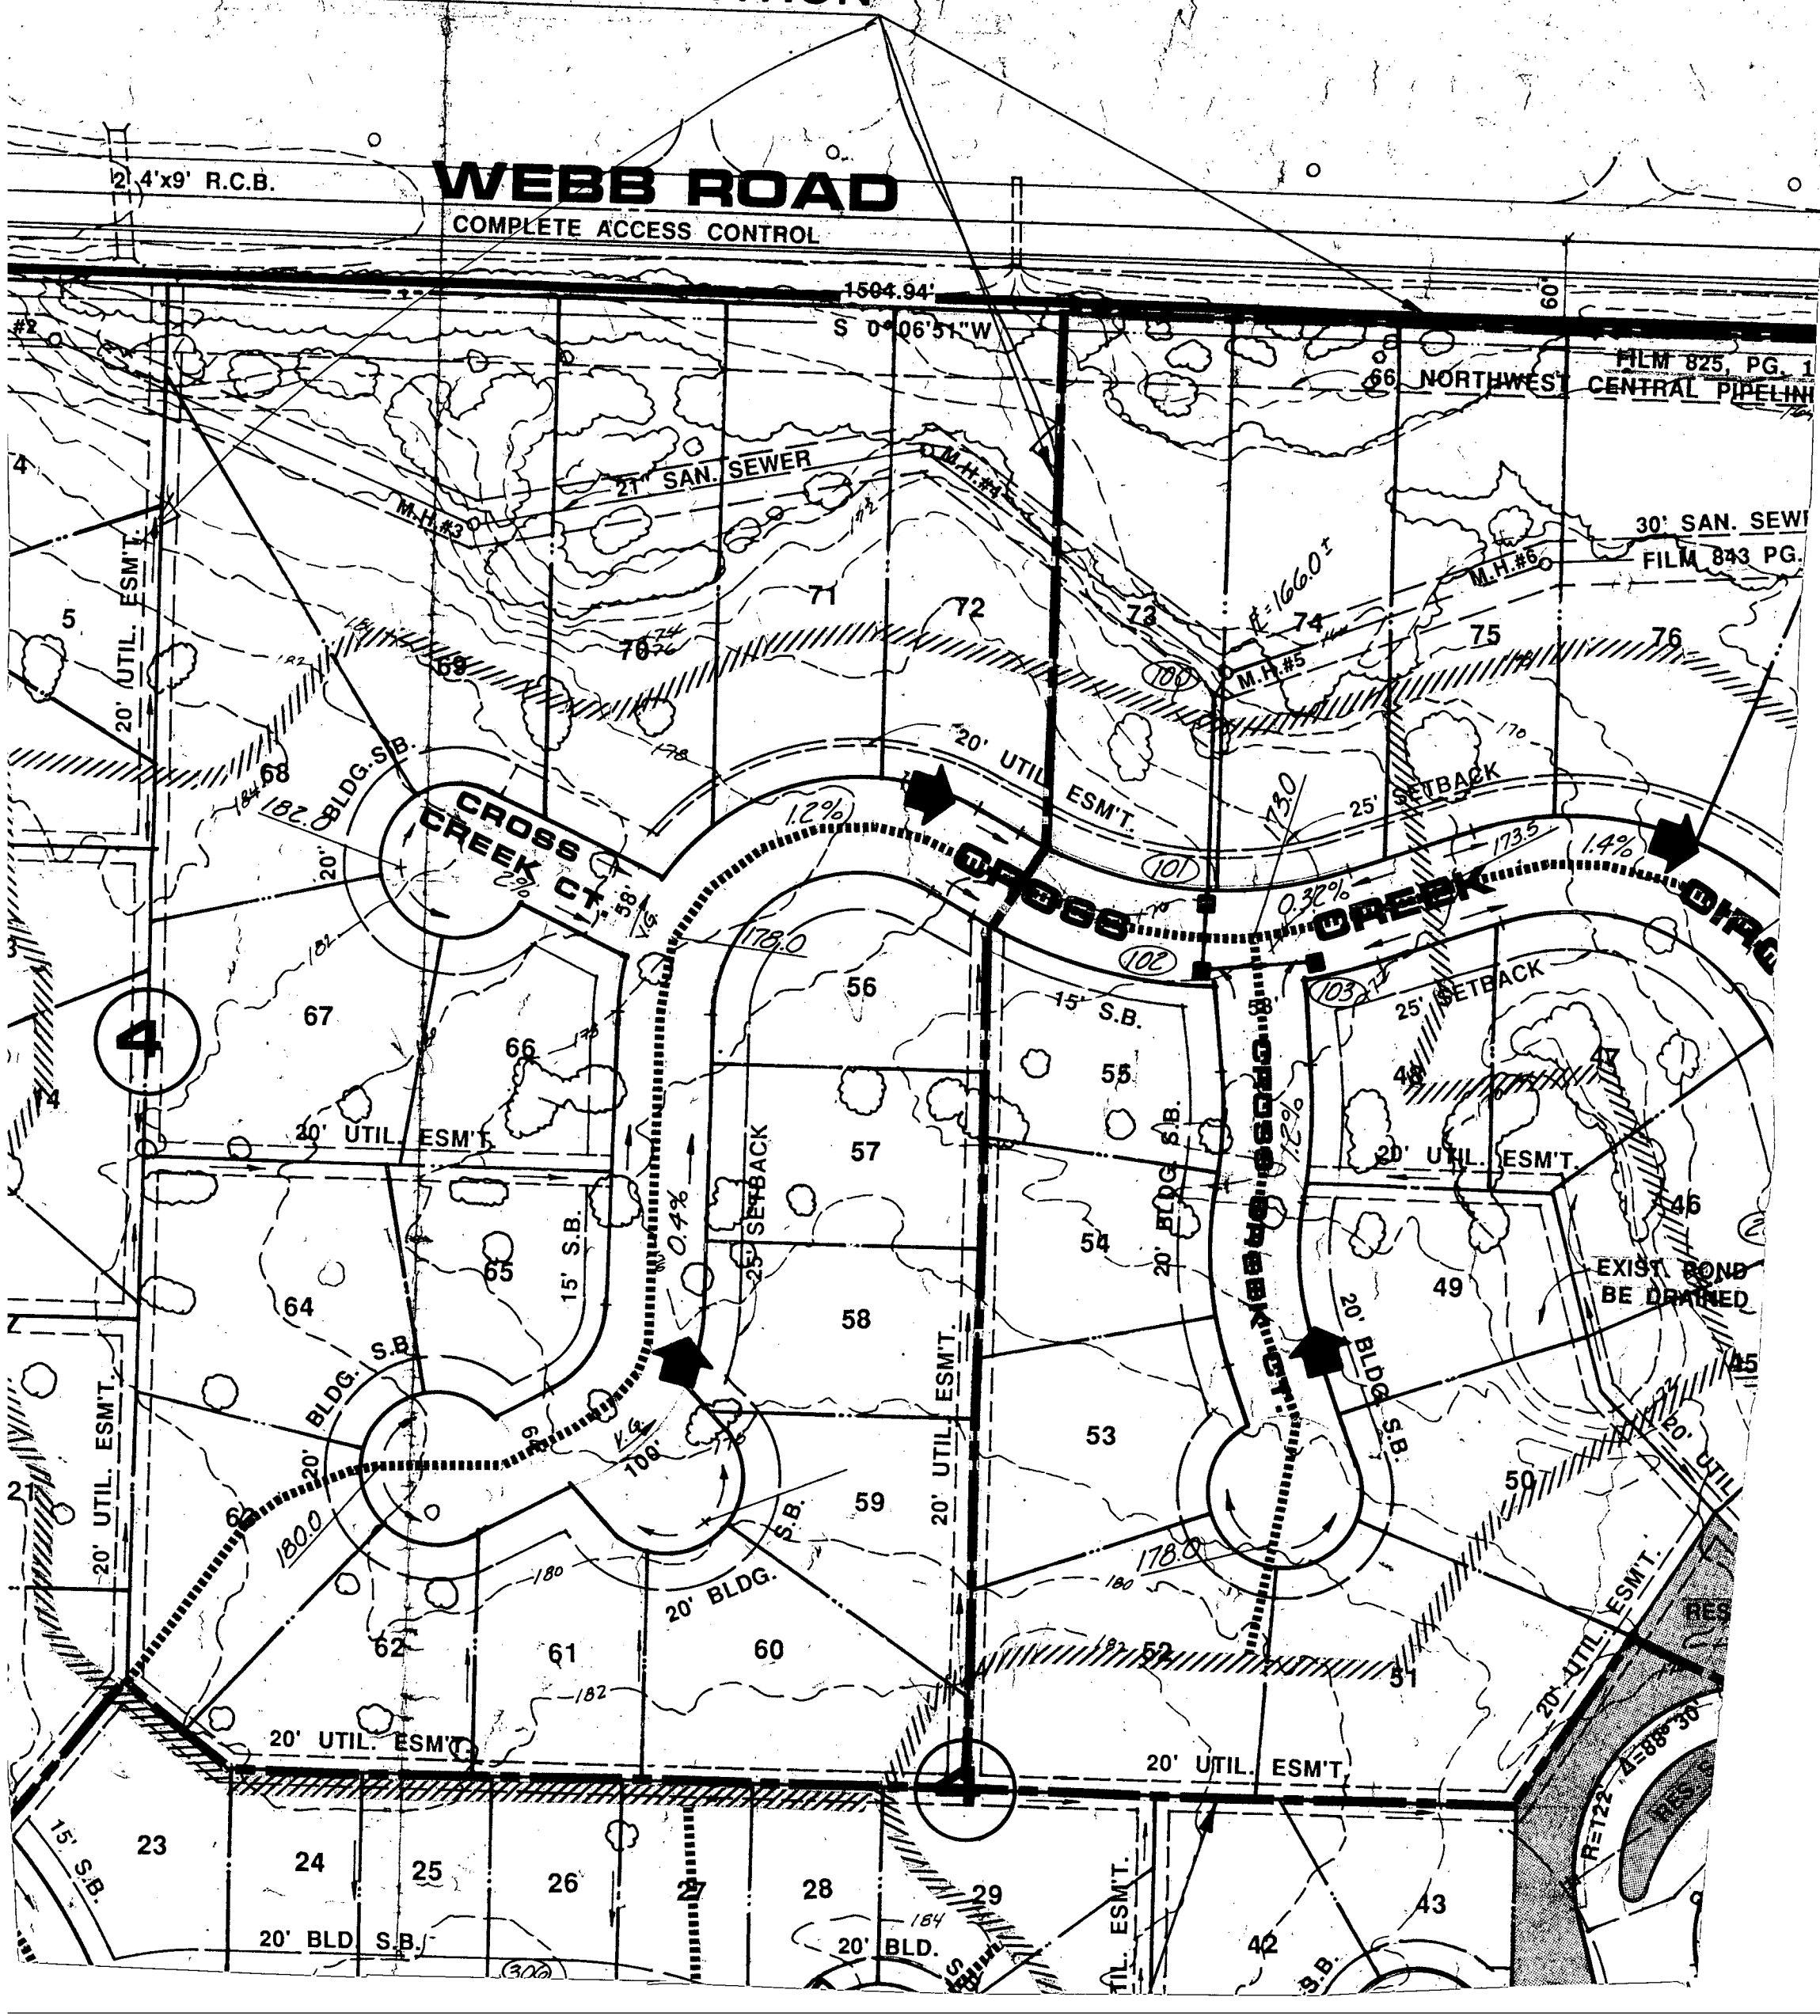

MEM 825 PG. 1
66 NORTHWEST CENTRAL PIPELINE

30" SAN. SEW
FILM 843 PG.

EXIST. POND
BE DRAINED

RES.

RES.

RES.