

Lot 1 Blk 1

Avg. Slp. 0.2%


OH10

Lot 1 Blk 2

600 LF of 60" x 38" RCP Pipe
 1542 LF x 1.32 = 400

APPX. DEPTH
 APPX. & ELEV.

Pipe
 Swale

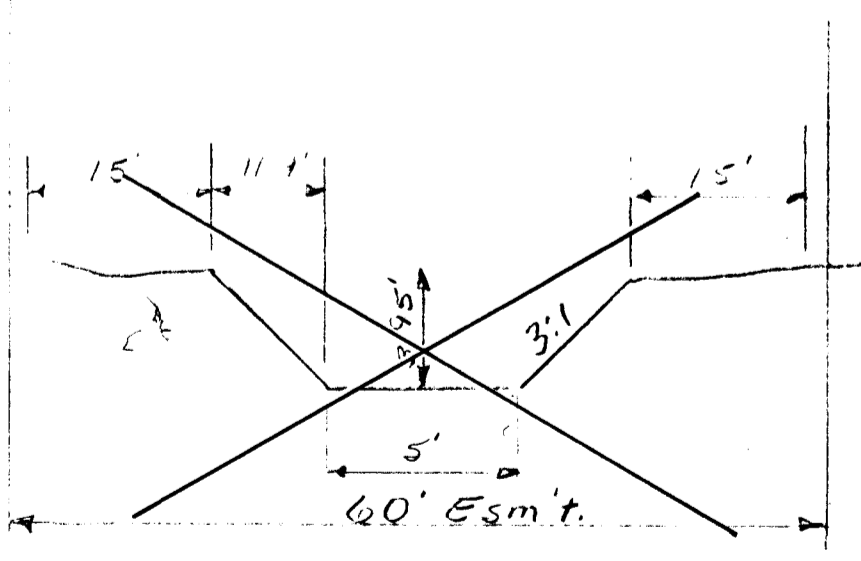

TYPICAL DITCH

E. Side - Lot 1 - Blk 2 - DP III
 2.7 CY/LF x 1310 LF x 2.00 CY = 46,470 cu

Shape
 Exist.
 Ditch

<p>POE & ASSOCIATES CONSULTING ENGINEERS</p>	Bridge part II Drainage Plan II	
	ENGINEER: TLT	CHECKED BY:
	DRAWN BY: JH	SCALE:
	DATE:	SHEET OF