


CORRIGAN ADDITION
(DRAINAGE)

[illegible]

OWNERS:
BRIAN E & MARY ANN CORBISAI
6314 LEGION
WICHITA, KS. 67204

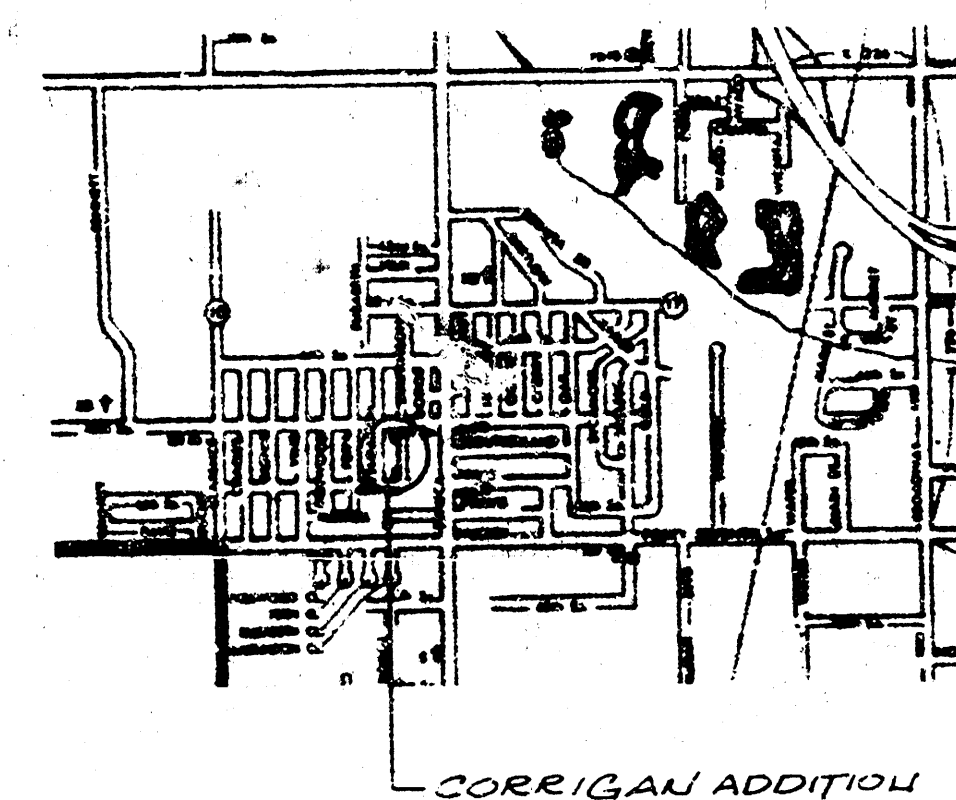

UTILITIES:
OVERHEAD ELECTRIC AND UNDERGROUND
TELEPHONE LOCATED IN 16 UTILITY
EASEMENT BLOCK 21 PURCELL'S 11TH ADDITION

SAN SEWER
MANHOLE #1 - RING 8735

OUT - EAST	73.73
IN - WEST	73.77
IN - NORTH	75.27
IN - SOUTH	75.36

WALHOLE #2 RING - 86.53
MALHOLE UNDER FENCE UNABLE TO OPEN

WALHOLE #3 RING - 86.62
LOC. SHOWN OUT NORTH 02.18
65' S. SOUTH OF IN - EAST 82.30
WALHOLE #3

TOPOGRAPHIC SURVEY - 5/27/83
BENCH MARK - CITY DISC. 47TH ST 30 E SENECA
ELEV = 8734'

PREPARED BY:
AIR CAPITOL LAND SURVEYORS
2104 W. 21ST ST
WICHITA, KS 67203

FILMED FROM THE BEST
AVAILABLE COPY