


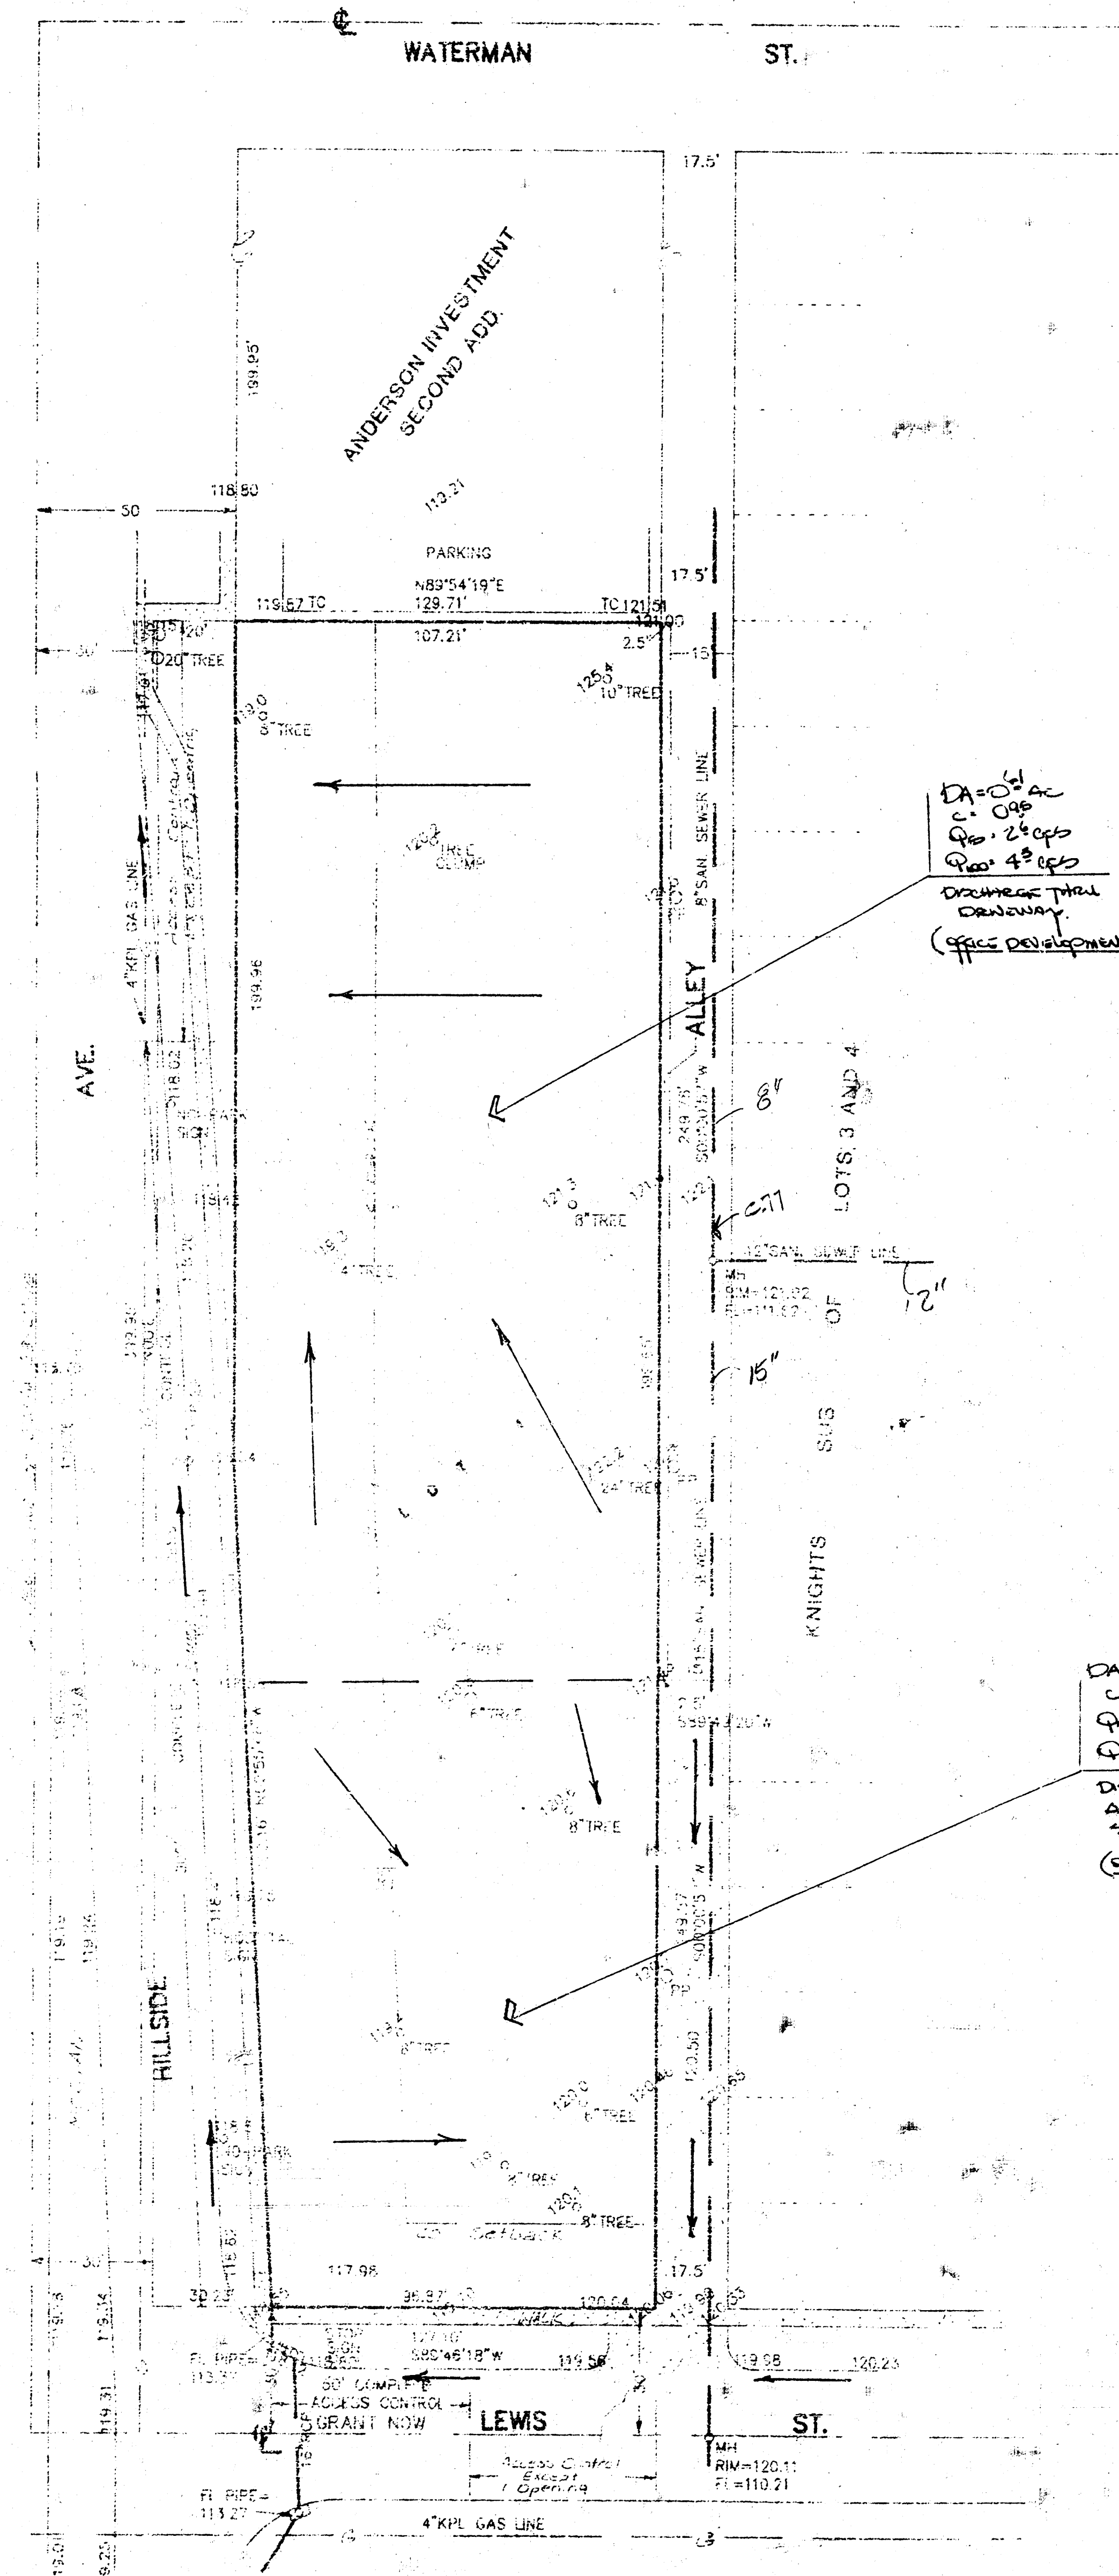

SKETCH PLAT **DEPARTMENT OF** **TRANSPORTATION** **3RD ADDITION**

REPLAT OF LOTS 17, 19, 21, AND 23, KNIGHTS SUB-DIVISION, OF LOTS 3 AND 4, IN BLOCK 1, GRAND VIEW ADDITION TO WICHITA, KANSAS, TOGETHER WITH LOTS 1, 3, 5, 7, 9, AND 11, RAWLINS AND BROWN'S SUB-DIVISION OF LOTS 5 AND 8, IN BLOCK 1, GRAND VIEW ADDITION TO WICHITA, KANSAS, TOGETHER WITH LOT 1, HERMAN ADDITION, WICHITA, KANSAS.

DEPARTMENT OF TRANSPORTATION
AND CITY OF WICHITA

DA = 0.32 ac
C = 0.95
QS = 13 cfs
QSW = 25 cfs
DISCHARGE TO
ALLEY AND TO LOTS
OF KIP SPRING SOURCE
(OFFICE DEVELOPMENT)

Prove existing storm
sewer can take
all this water & tell
what existing runoff
to to SS is.
And prove won't flood
street
Failed Alley? Brent