


MARCUS AND LOGAN ADDITION
(Drainage)

B. M. 1 ELEV. 129.87 - "D" CHISELED ON NW COR. BRIDGE AT
MAPLE & BIG DITCH.


TOPO MADE DEC. 1984.

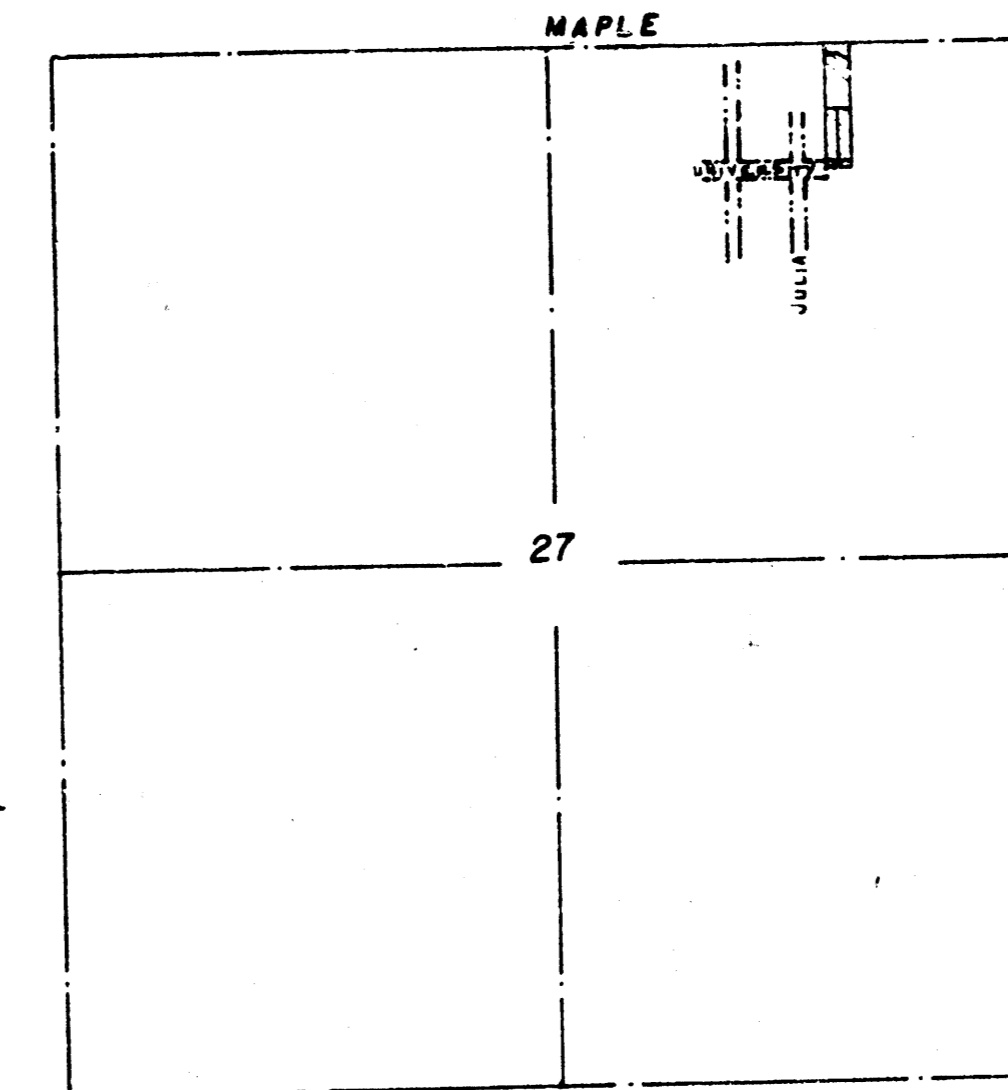

VICINITY MAP
1"=1000'



1"=100'

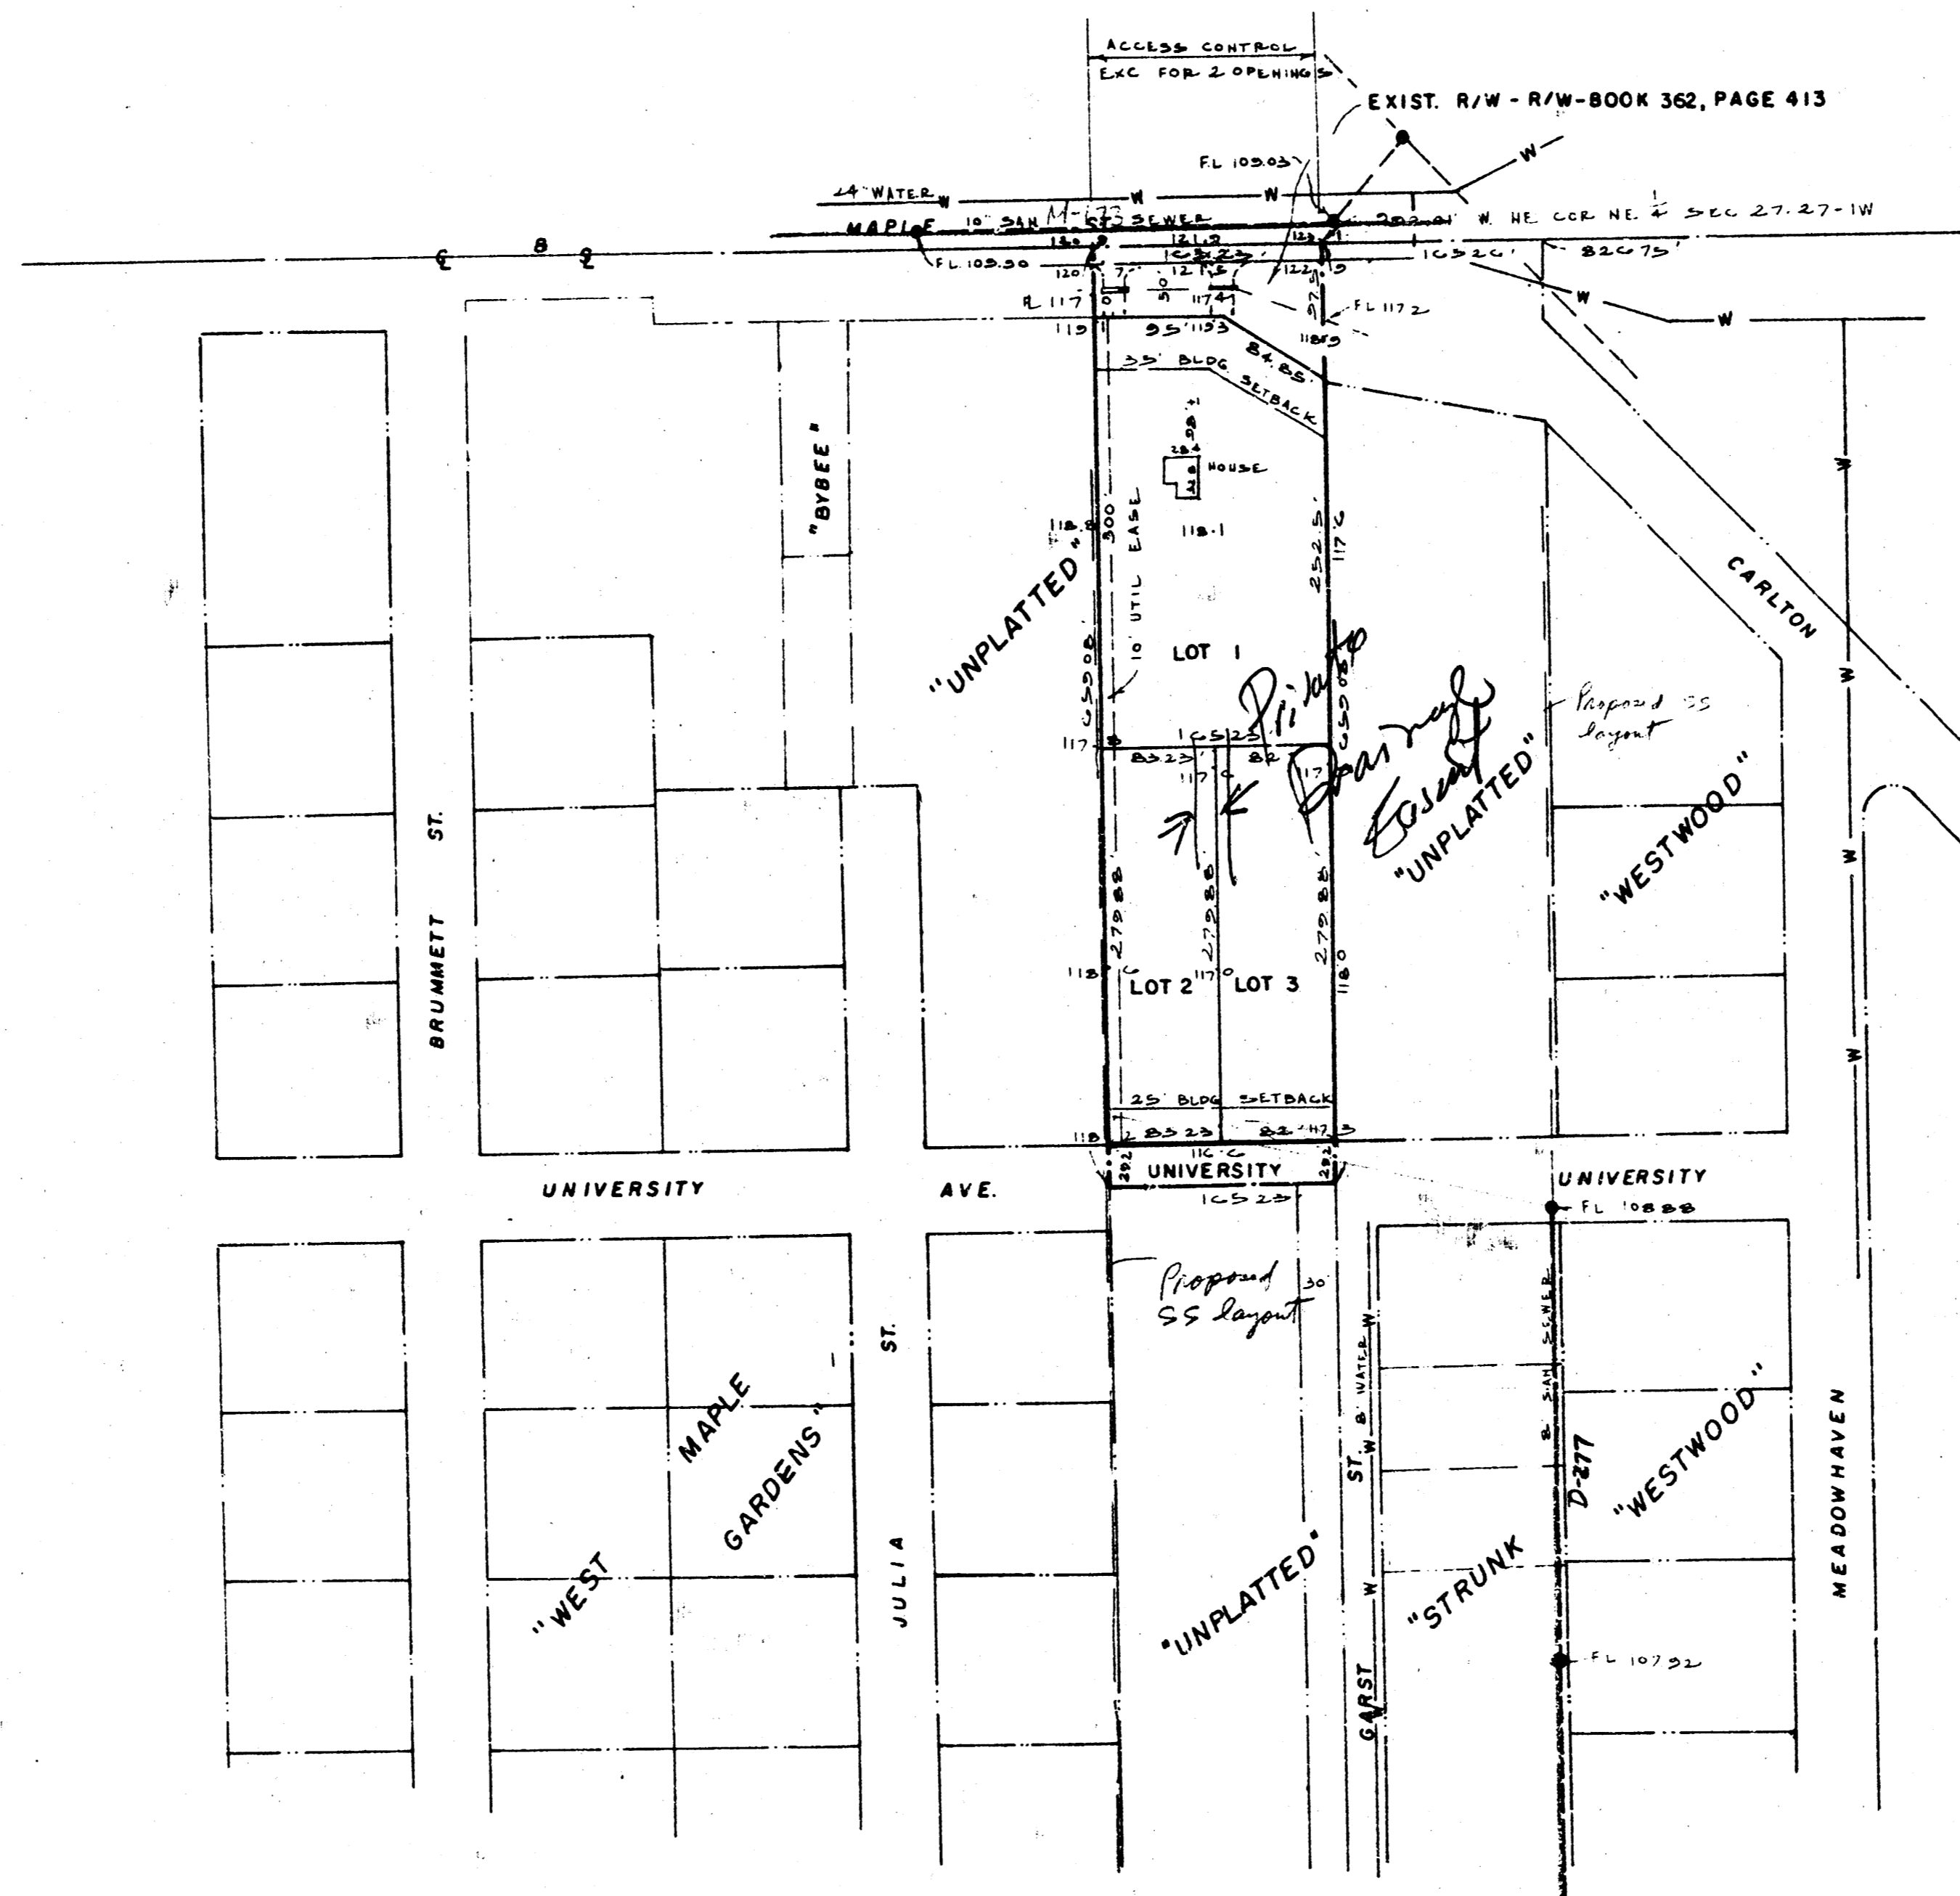

SKETCH PLAT
MARCUS & LOGAN ADDITION

FOR:
MARK MOORE
4024 W. 11TH

LOWELL D. HIGH, L.S.
DEC. 5, 1984