


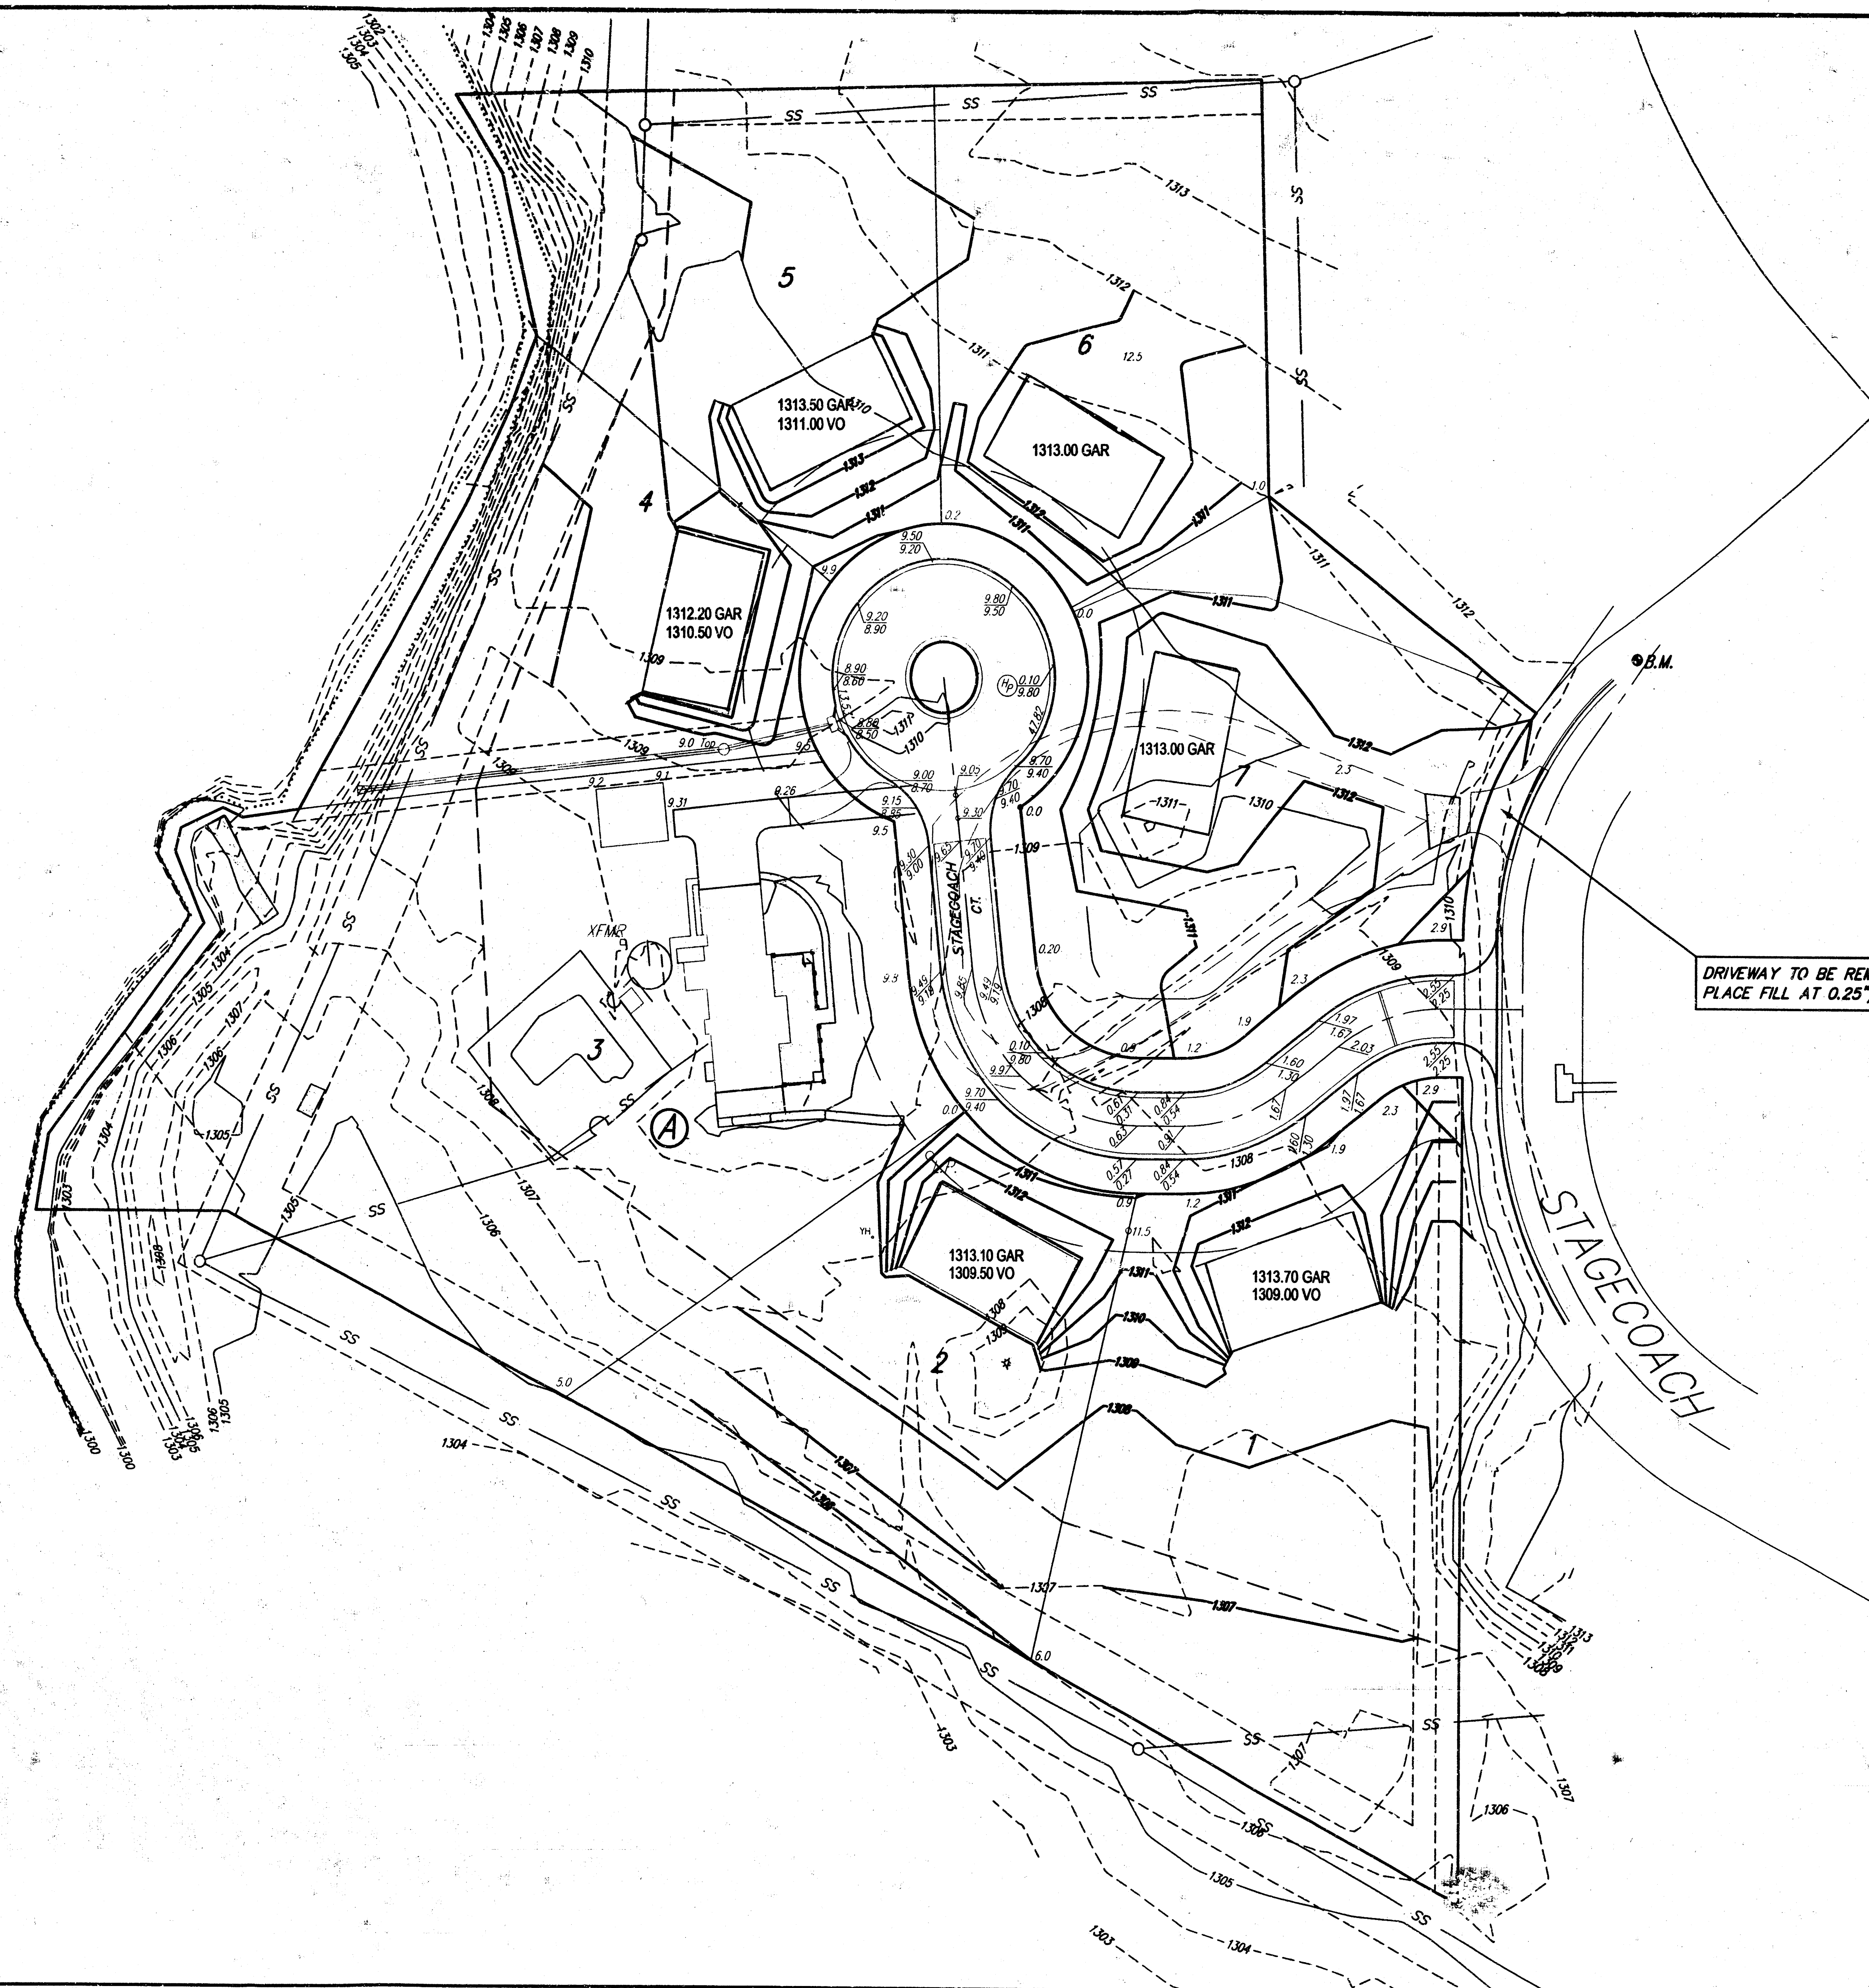

SRB

SCALE
1" = 40'

BENCH MARK: "I" CUT ON TOP OF CURB
AT P.C. NEAR S.E. CORNER OF LOT 1, BLOCK 1,
SCOTTSDALE AT SHADYBROOK FARM ADDITION.
ELEV=1312.60 (M.S.L.)

DRIVEWAY TO BE REMOVED.
PLACE FILL AT 0.25'/FT. TO R/W

APPROVED
DRAINAGE PLAN

BENCHMARK NOTE

NOTE: IT HAS BEEN DETERMINED THAT THE COUNTY
BENCHMARK USED FOR THIS PROJECT WAS LOW BY
1.00 FEET. AS A RESULT, PLEASE ADD 1.0 FEET TO
ALL GRADES INDICATED ON THIS SHEET.

SITE GRADING ESTATES AT SHADYBROOK SEDGWICK COUNTY, KANSAS					
SRB	224 NORTH MAIN WICHITA, KANSAS 67203 http://www.felst.com/~srb		316-264-8008 FAX 264-4621 E-mail: srb@felst.com		SHEET 1 OF 1
	SAVOY, RUGGLES & BOHM, P. A. ENGINEERING & SURVEYING				
PROJECT NUMBER					
DESIGN CMB	DRAWN CMB/KWL	UTILITY	REVIEW	DATE May 5, 1998	REVISED

KAT CHADWICKED BROSCHOL