

As Built Elevations:
 Handwritten elevations are "As Built" elevations as surveyed for the sanitary sewer construction. Builders should check "As Built" elevations listed and always provide for a minimum of 2% slope away from the rear of a home to the lowest rear lot corner. Additionally, 1% slope should be provided along the rear easement from lot line to lot line. Any fills or cuts in the rear easements by Builders shall be done in a way that will not interfere with the overall drainage scheme.

SCALE 1"=100'

LEGEND

- | |
|----------------|
| W |
| F32.4
G39.9 |

 - INDICATES NO. VIEW OUT BASEMENT
 (F-Indicates Top of Foundation Wall Elevation;
 (G-Indicates Garage Floor Elevation)
- | |
|----------------|
| V |
| F31.7
G32.2 |

 - INDICATES PROPOSED VIEW OUT BASEMENT
 (V-Indicates Ground Elevation @ Rear Wall)
 (F-Indicates Top of Foundation Wall Elevation;
 (G-Indicates Garage Floor Elevation)
- | |
|----------------|
| W |
| F32.2
G37.7 |

 - INDICATES PROPOSED WALK OUT BASEMENT
 (W-Indicates Basement Floor Elevation)
 (F-Indicates Top of Foundation Wall Elevation;
 (G-Indicates Garage Floor Elevation)

BENCHMARKS

1. "L1" Cut in South Hub Guard of R.C.B.C. 25' South & 94' West of N.W. Cor. Sec. 35. Elev. 1311.90
2. Rail Road Spike in Power Pole. Approximately 25' South & 30' East of W. 1/4 Cor. Sec. 35. Elev. 1349.65

NOTES

1. Add 1300 to Finish Elevations to get M.S.L. Datum.
2. Front Lot Corner Elevations are shown in street. Front Lot Corner Elevations are 0.5 feet above Top of Curb Elevation. (Top of Curb Elevations are not shown).
3. Garage Floor Elevations are set 3" above highest Front Lot Corner Elevation (1,000).
4. This plan was prepared for drainage purposes only. The existing ground line may have been changed in some areas within this addition. Grade changes in these areas may not have been made with engineered fills. Builders may need to obtain foundation advice from a Geotechnical Engineer prior to construction.




LOT GRADING PLAN
EQUESTRIAN ESTATES

Developer: John Greenstreet
 J.D.G., LLC
 12221 E. Central
 Wichita, KS 67206

Engineer: Poe and Associates of Kansas, Inc.
 5940 E. Central
 Wichita, KS 67206

An Addition to Wichita - Sedgwick County, Kansas
 (Associated Zone Case PUD 2000-0001)


DATE: JULY 13, 2001
 Revised: JULY 31, 2002
 Revised: April 14, 2003
 Revised: January 5, 2004

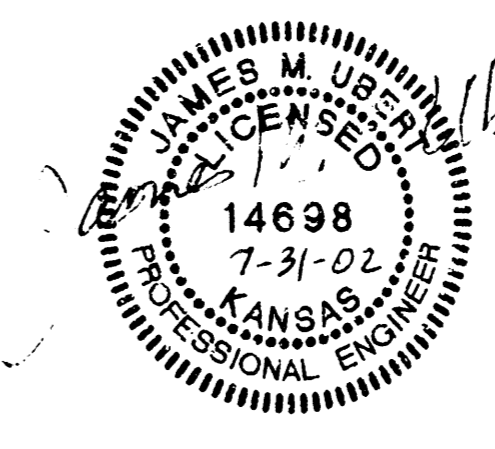

POE & ASSOCIATES OF KANSAS, INC.
 5940 E. Central, Suite 200 • Wichita, KS 67208-4242
 Phone 316/685-4114 • FAX 316/685-4444

EQUESTRIAN ESTATES
 Revised 5 JAN 2004

G:\APPS\DATA\1094\LOT GRADING.dwg Fri Aug 30 06:44:32 2002 Jim Oberl, P.E. - Poe & Associates of Kansas, Inc.

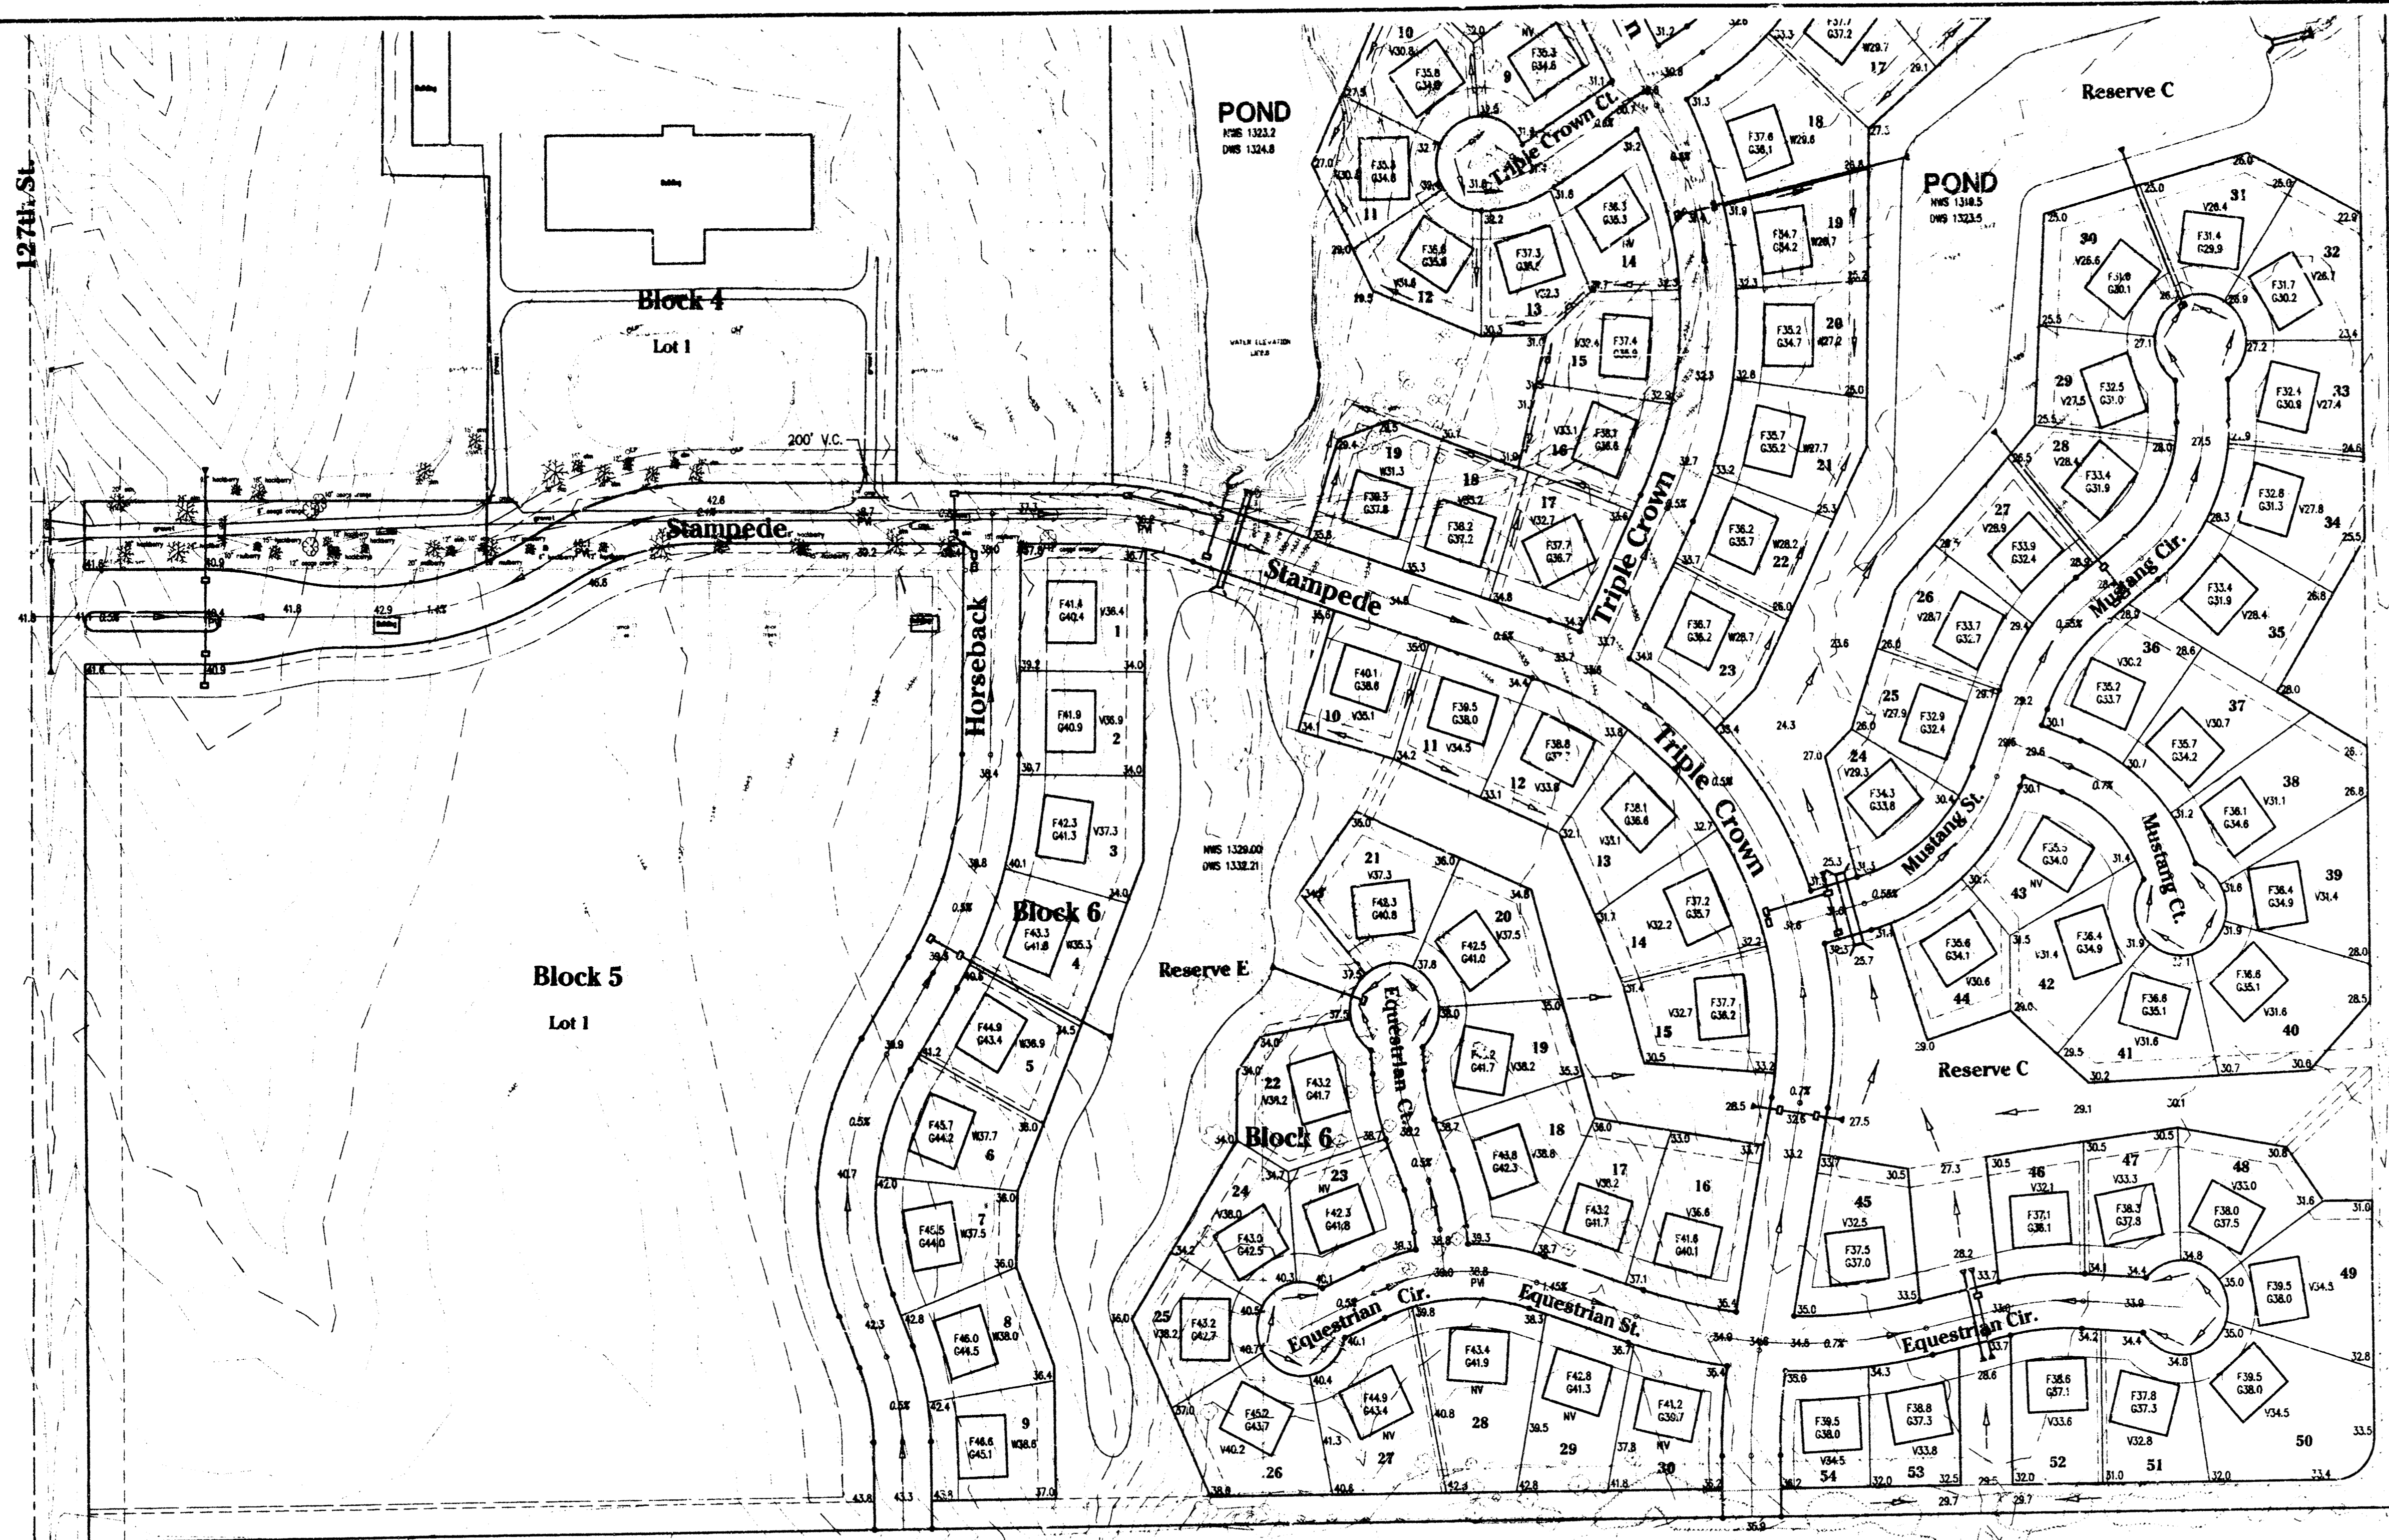

SCALE 1"=100'

LEGEND

- INDICATES NO VIEW OUT BASEMENT
 (F-Indicates Top of Foundation Wall Elevation)
 (G-Indicates Garage Floor Elevation)
- INDICATES PROPOSED VIEW OUT BASEMENT
 (V-Indicates Ground Elevation & Rear Wall)
 (F-Indicates Top of Foundation Wall Elevation)
 (G-Indicates Garage Floor Elevation)
- INDICATES PROPOSED WALK OUT BASEMENT
 (W-Indicates Basement Floor Elevation)
 (F-Indicates Top of Foundation Wall Elevation)
 (G-Indicates Garage Floor Elevation)

BENCHMARKS

1. "X" Cut on South Hub Quad of R.C.B.C. 26' South & 94' West of NW Cor. Sec. 35 Elev. 1311.90
2. 423 Road Spike in Power Pole 450.0' North of 25' South & 30' East of W. 1/4 Cor. Sec. 35 Elev. 1349.65

NOTES

1. Add 1200 to Finish Elevations to get M.S.L. Datum
2. Front Lot Corner Elevations are shown in street. Front Lot Corner Elevations are 0.5 feet above Top of Curb Elevation. (Top of Curb Elevations are not shown)
3. Garage Floor Elevations are set 3' above highest Front Lot Corner Elevation (Typical)
4. This plan was prepared for drainage purposes only. The existing ground line may have been changed in some areas within this addition. Grade changes in these areas may not have been made with engineered fill. Builders may need to obtain foundation advice from a Geotechnical Engineer prior to construction.


LOT GRADING PLAN
EQUESTRIAN ESTATES

Developer: John Greenstreet
 J.D.G., LLC
 12221 E. Central
 Wichita, KS 67206

Engineer: Poe and Associates of Kansas, Inc.
 5940 E. Central
 Wichita, KS 67208

An Addition to Wichita - Sedgwick County, Kansas
 (Associated Zone Case PUD 2000-0001)

DATE: JULY 13, 2001
 Revised: JULY 31, 2002

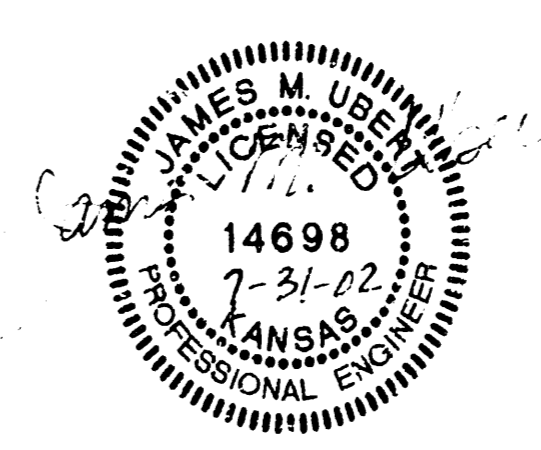

POE & ASSOCIATES OF KANSAS, INC.
 5940 E. Central Suite 200 ■ Wichita, KS 67206-4242
 Phone 316/685-4114 ■ FAX 316/685-4444

6: \MAPS\UDA\1084\lot_grading1.dwg Fri Aug 30 08:31:40 2002 Jie Ubert, P.E. - Poe & Associates of Kansas, Inc.