


SCALE  
1" = 40'

BENCH MARK: "□" CUT ON TOP OF CURB  
AT P.C. NEAR S.E. CORNER OF LOT 1, BLOCK 1,  
SCOTTSDALE AT SHADYBROOK FARM ADDITION.  
ELEV.=1312.60 (M.S.L.)

DRIVEWAY TO BE REMOVED.  
PLACE FILL AT 0.25"/FT. TO R/W

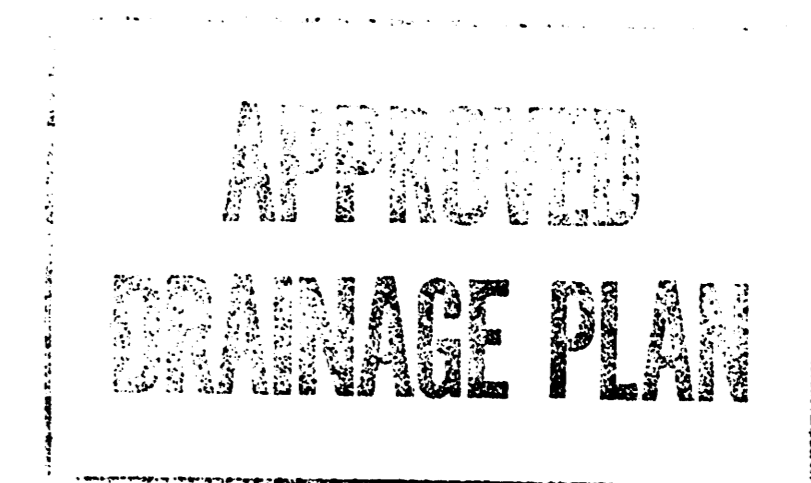

**BENCHMARK NOTE**

NOTE: IT HAS BEEN DETERMINED THAT THE COUNTY  
BENCHMARK USED FOR THIS PROJECT WAS LOW BY  
1.00 FEET. AS A RESULT, PLEASE ADD 1.0 FEET TO  
ALL GRADES INDICATED ON THIS SHEET.

SITE GRADING ESTATES AT SHADYBROOK SEDGWICK COUNTY, KANSAS					
	924 NORTH MAIN	316-264-8008			
	WICHITA, KANSAS 67203	FAX 264-4621			
http://www.fest.com/~arb		E-mail: arb@fest.com			
SAVOY, RUGGLES & BOHM, P. A. ENGINEERING & SURVEYING					
PROJECT NUMBER					
DESIGN	DRAWN	UTILITY	REVIEW	DATE	REVISED
CMB	CMB/KWL			May 5, 1998	
					SHEET 1 OF 1 Date Drawing SRB 2008 0911

SRB 2008 0911