

SCANNED


SANITARY SEWER EXTENSION ENGINEERING LAB COMPLEX

SMAC PROJECT NO. 63-1000

CITY OF WICHITA PROJECT NO. 542-80-245-80001-000-000-003

BOEING MILITARY AIRPLANE COMPANY WICHITA, KANSAS

BE&C ENGINEERS INC.
WICHITA, KANSAS

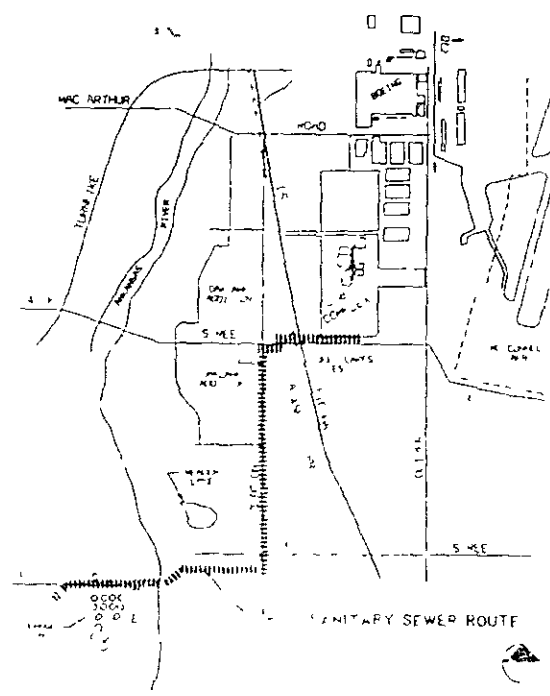

LOCATION MAP

5/10/05

SS will connect
to this -
named off
sewer
JK

AS BUILT
7-87
ROL

INDEX OF DRAWINGS

SHEET NO.	DESCRIPTION
1	TITLE AND LOCATION MAP
2	GENERAL NOTES
3	LEGEND
4	PLAN AND PROFILE STA 10 00 TO STA 18 00
5	PLAN AND PROFILE STA 18 00 TO STA 28 00
6	PLAN AND PROFILE STA 28 00 TO STA 38 00
7	PLAN AND PROFILE STA 38 00 TO STA 48 00
8	PLAN AND PROFILE STA 48 00 TO STA 58 00
9	PLAN AND PROFILE STA 58 00 TO STA 68 00
10	PLAN AND PROFILE STA 68 00 TO STA 78 00
11	PLAN AND PROFILE STA 78 00 TO STA 88 00
12	PLAN AND PROFILE STA 88 00 TO STA 98 00
13	PLAN AND PROFILE STA 98 00 TO STA 108 00
14	PLAN AND PROFILE STA 108 00 TO STA 118 00
15	PLAN AND PROFILE STA 118 00 TO STA 128 00 ELECTRICAL SECTIONS
16	4' REINFORCED CONCRETE MANHOLE DETAILS AND MANHOLE DETAILS
17	5' REINFORCED CONCRETE MANHOLE DETAILS
18	6' REINFORCED CONCRETE MANHOLE DETAILS
19	5' ANNUITY MAN AND COVER DETAILS
20	6' C.I. STRUCTURE

FILMED FROM THE S-