

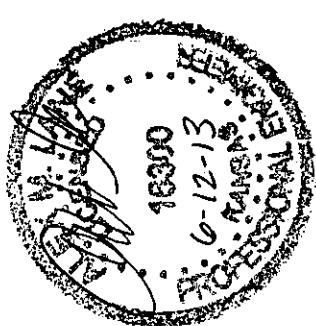


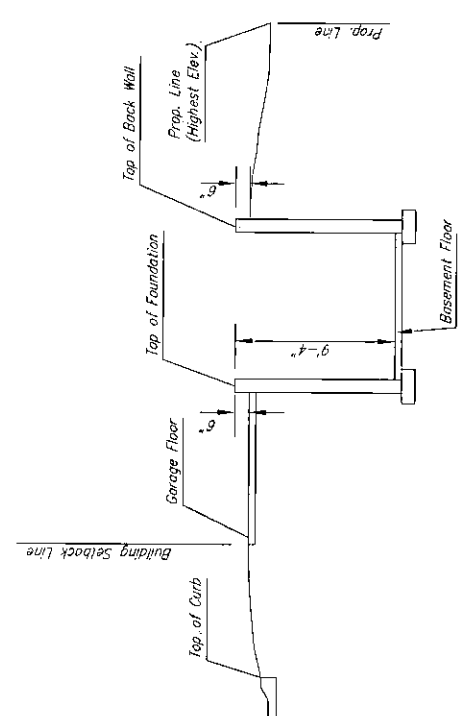

BENCH MARKS

BENCH MARK #1: SQUARE CUT IN CONCRETE
 HEADWALL NORTH SIDE OF ACCESS ROAD &
 WEBB
 ELEV.=1374.47 NGVD

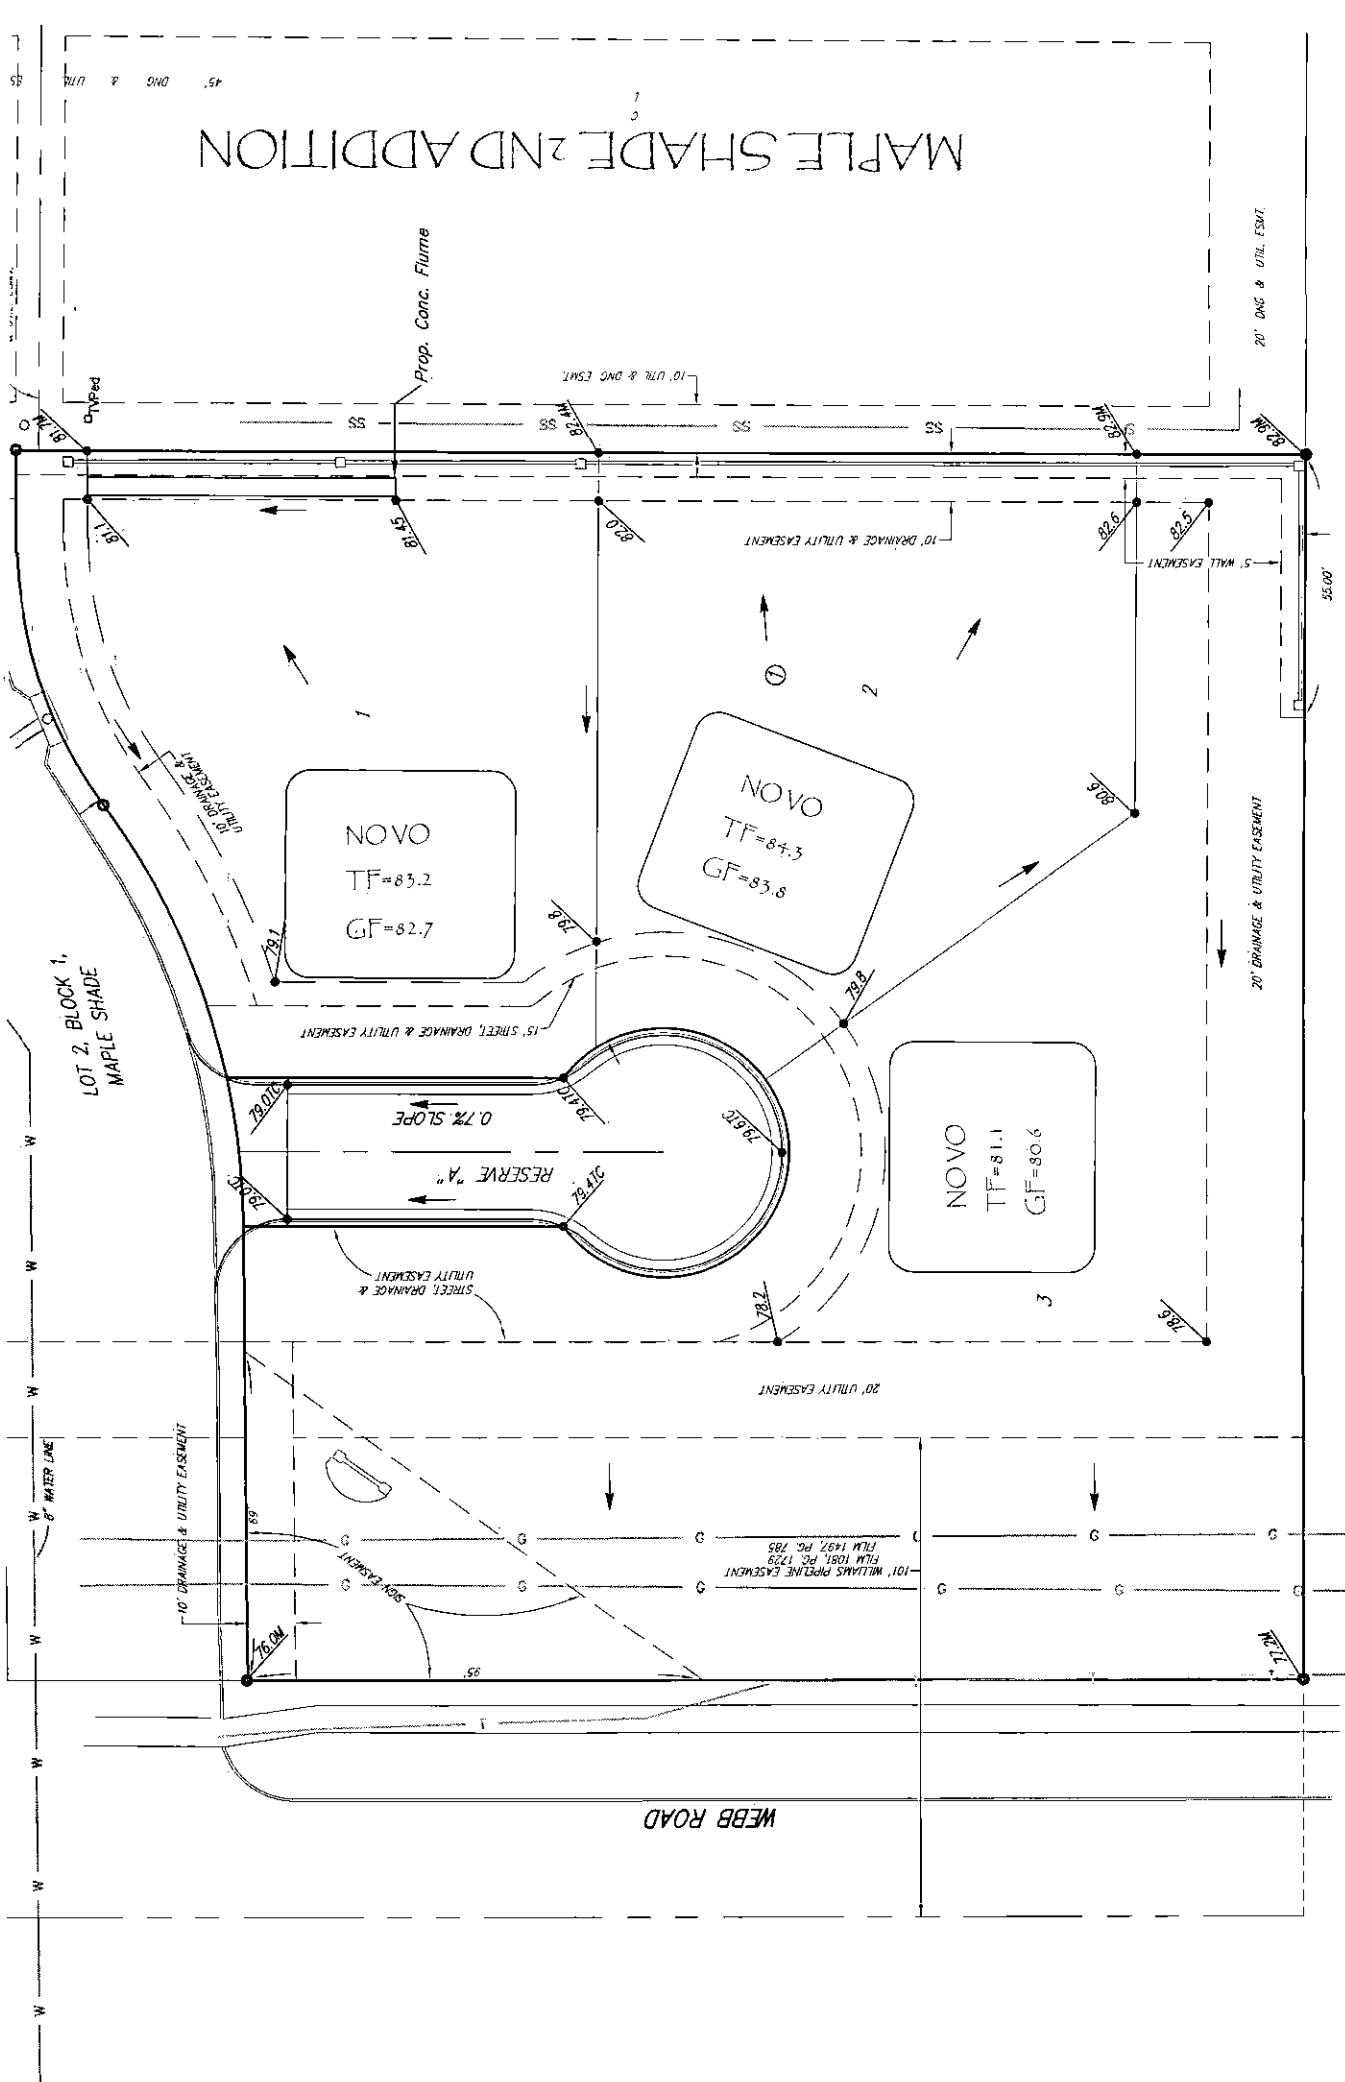

REPLAT LOT 1 MAPLE SHADE ADDITION
4 CORNER LOT GRADING PLAN

DATE	6/12/13
DESIGN	BJC
DRAWN	NSK
REVIEW	...
PROJECT NUMBER	...
ISS. JOB NO.	41306
DWG. SCALE	1"=20'
DRAWING TITLE	SURVEY BASE (4 Corner)
SHEET	1
OF	1