




LEGEND

GF = ELEVATION OF GARAGE FLOOR
 TF = TOP OF FOUNDATION ELEVATION
 VO = VIEW OUT OPENING ELEVATION
 WO = WALK-OUT OPENING ELEVATION
 RO = REAR WALL LOWEST OPENING INTO THE STRUCTURE (WALK-OUT PIT, MID-LEVEL WALK OUT)

BENCHMARK: CHISELED SQUARE ON THE TOP OF CURB AT THE SOUTHEAST CORNER OF SPRING VALLEY AND HORSEBACK
 ELEVATION = 1331.27 (NAVD88)

BENCHMARK: CHISELED SQUARE ON THE TOP OF CURB AT THE SOUTHEAST CORNER OF ALDEN AND BELLECHASE
 ELEVATION = 1323.30 (NAVD88)

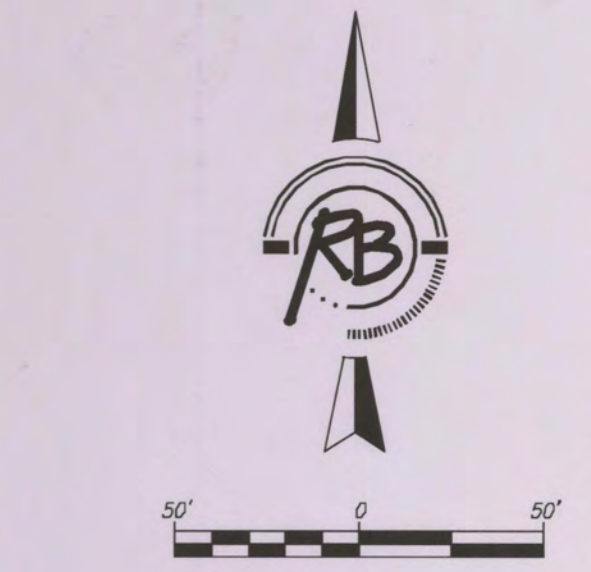


MINIMUM BUILDING PAD ELEVATION FOR LOWEST OPENING INTO STRUCTURES

BLOCK	LOT NO.	ELEVATION (NAVD88)
5	1, 2, 3, 4, 5, 6, 7, 8, 9, 10, 11	1319.0
5	12, 13, 14, 15, 16, 17, 18, 19, 20	1317.0
5	21, 22, 23, 24, 25, 26, 27	1318.3

**Bellechase 3rd Addition
 4-Corner Lot Grading Plan
 WICHITA, KANSAS**

	DATE	June 25, 2013
	DESIGN	EJG
	DRAWN	EJG
	REVIEW	
RUGGLES & BOHM ENGINEERING SURVEYING LANDSCAPE ARCHITECTURE GOVERNMENT 824 NORTH MAIN WICHITA, KANSAS 67203 P (316) 264-8008 F (316) 264-4621 WWW.RUGGLESANDBOHM.COM		
PROJECT NUMBER	472-85078	
DWG. NO.	4057E	DWG. SCALE
		100
SHEET	44	
DRAWING FILE	Engg Base {4 Corner Lot Grading (2)}	OF
		45

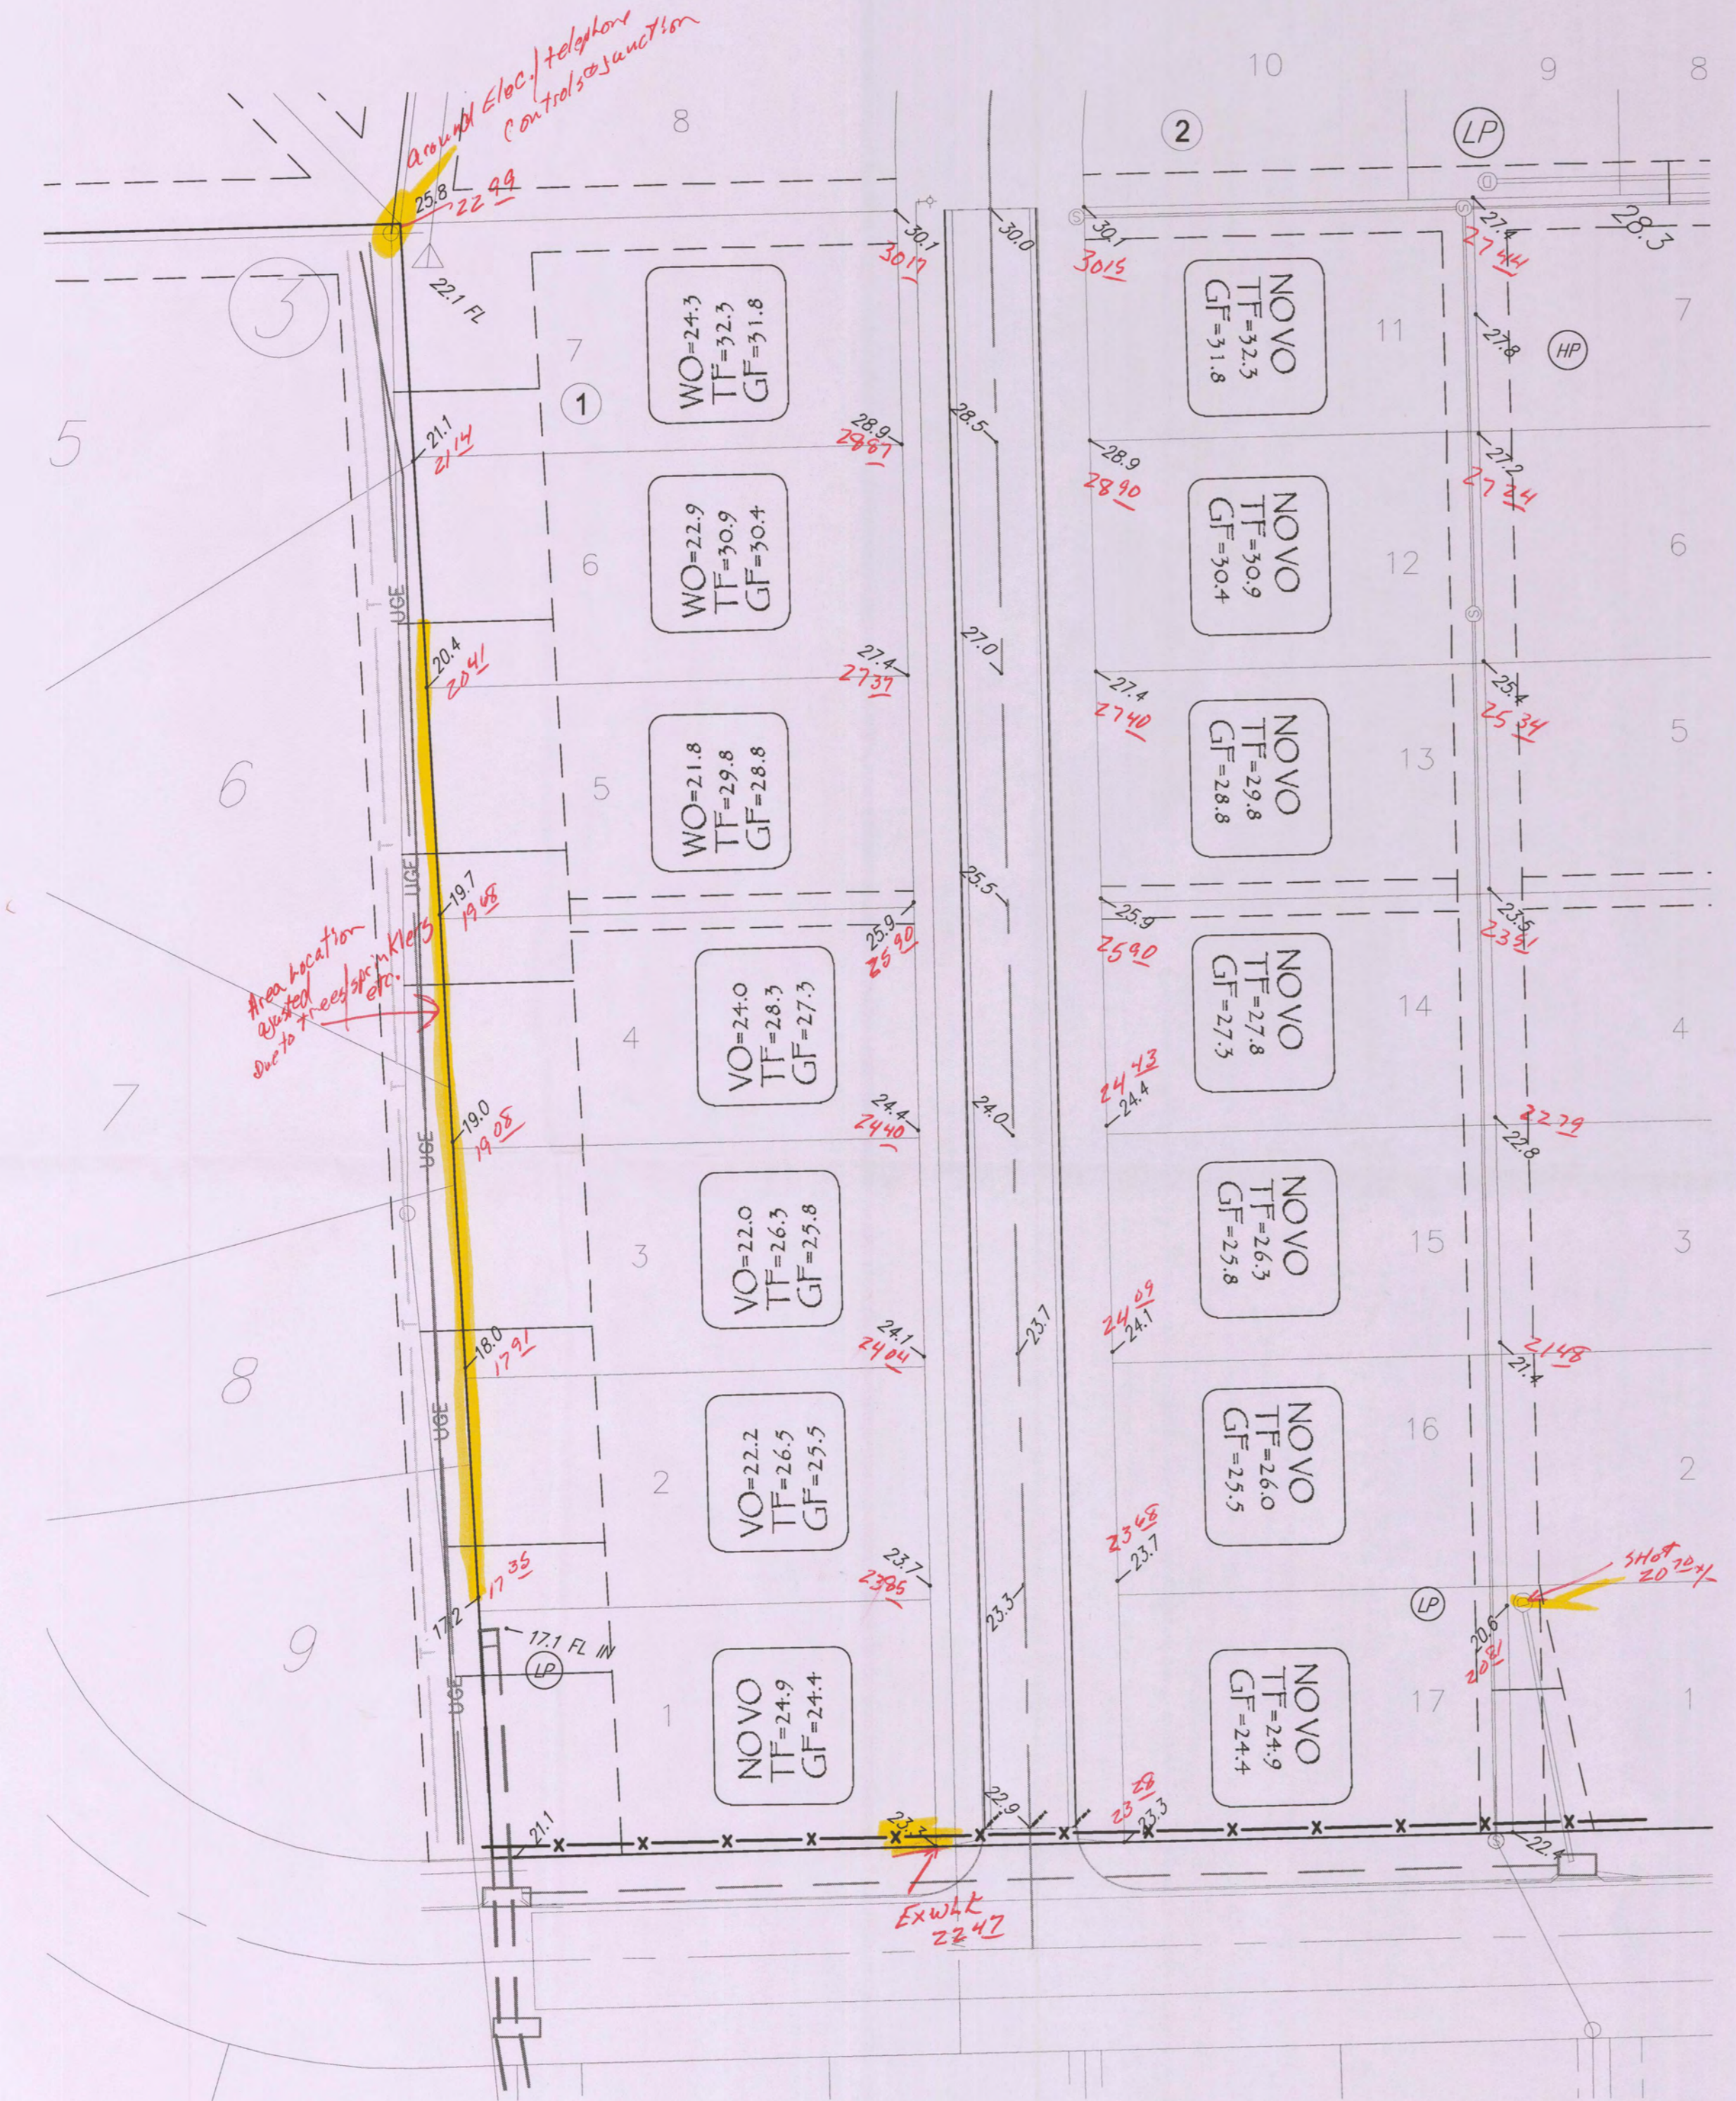

BENCHMARK: CHISELED SQUARE ON THE TOP OF CURB
AT THE SOUTHEAST CORNER OF SPRING VALLEY AND
HORSEBACK
ELEVATION = 1331.27 (NAVD88)

BENCHMARK: CHISELED SQUARE ON THE TOP OF CURB
AT THE SOUTHEAST CORNER OF ALDEN AND
BELLECHASE
ELEVATION = 1323.30 (NAVD88)

- LEGEND**
- GF = ELEVATION OF GARAGE FLOOR
 - TF = TOP OF FOUNDATION ELEVATION
 - VO = VIEW OUT OPENING ELEVATION
 - WO = WALK-OUT OPENING ELEVATION
 - RO = REAR WALL LOWEST OPENING INTO THE STRUCTURE
(WALK-OUT PIT, MID-LEVEL WALK OUT)



Bellechase 3rd Addition 4-Corner Lot Grading WICHITA, KANSAS			
	RUGGLES & BOHM		DATE June 25, 2013
	ENGINEERING SURVEYING LANDSCAPE ARCHITECTURE GOVERNMENT		DESIGN EJG
	924 NORTH MAIN WICHITA, KANSAS 67203 P (316) 264-8008 F (316) 264-4621 WWW.RUGGLESANDBOHM.COM		DRAWN EJG
	PROJECT NUMBER 472-85078	RB JOB NO. 4057E	DWG. SCALE 100
DRAWING FILE Engg Base [Bubble Map]			SHEET 45 OF 45

ENGINEERING DEPARTMENT

CITY OF WICHITA

MISCELLANEOUS INFORMATION

Signed *Joseph D. Dorsch*

Contractor *MIES CONSTR.*

Date *4-23-14*

Project *WDS to SERVE BELLECHASE 3RD ADD. (TIED w/ ROCKY CREEK (PAVING))*

Project Number *448-90576 tied w/ 766290*

CO #1: DRAINAGE IMPROVEMENT FOR ROCKY CREEK RD.

CO #2: EXTRA WORK OF EXISTING POND IN RESERVE B.

ALL OTHER WORK DONE PER PLAN.



Public Works & Utilities

TO: Kelly Fleming

FROM: Arceli Rosas

DATE: October 7, 2013

SUBJECT: Field As-Built/Corner Lot Grading Plan and White Card

Enclosed field as-built for the following project:

- **Tied with 472-85078 766290 – Bellechase 3rd Addition**