


Terradyme West 11.20.26

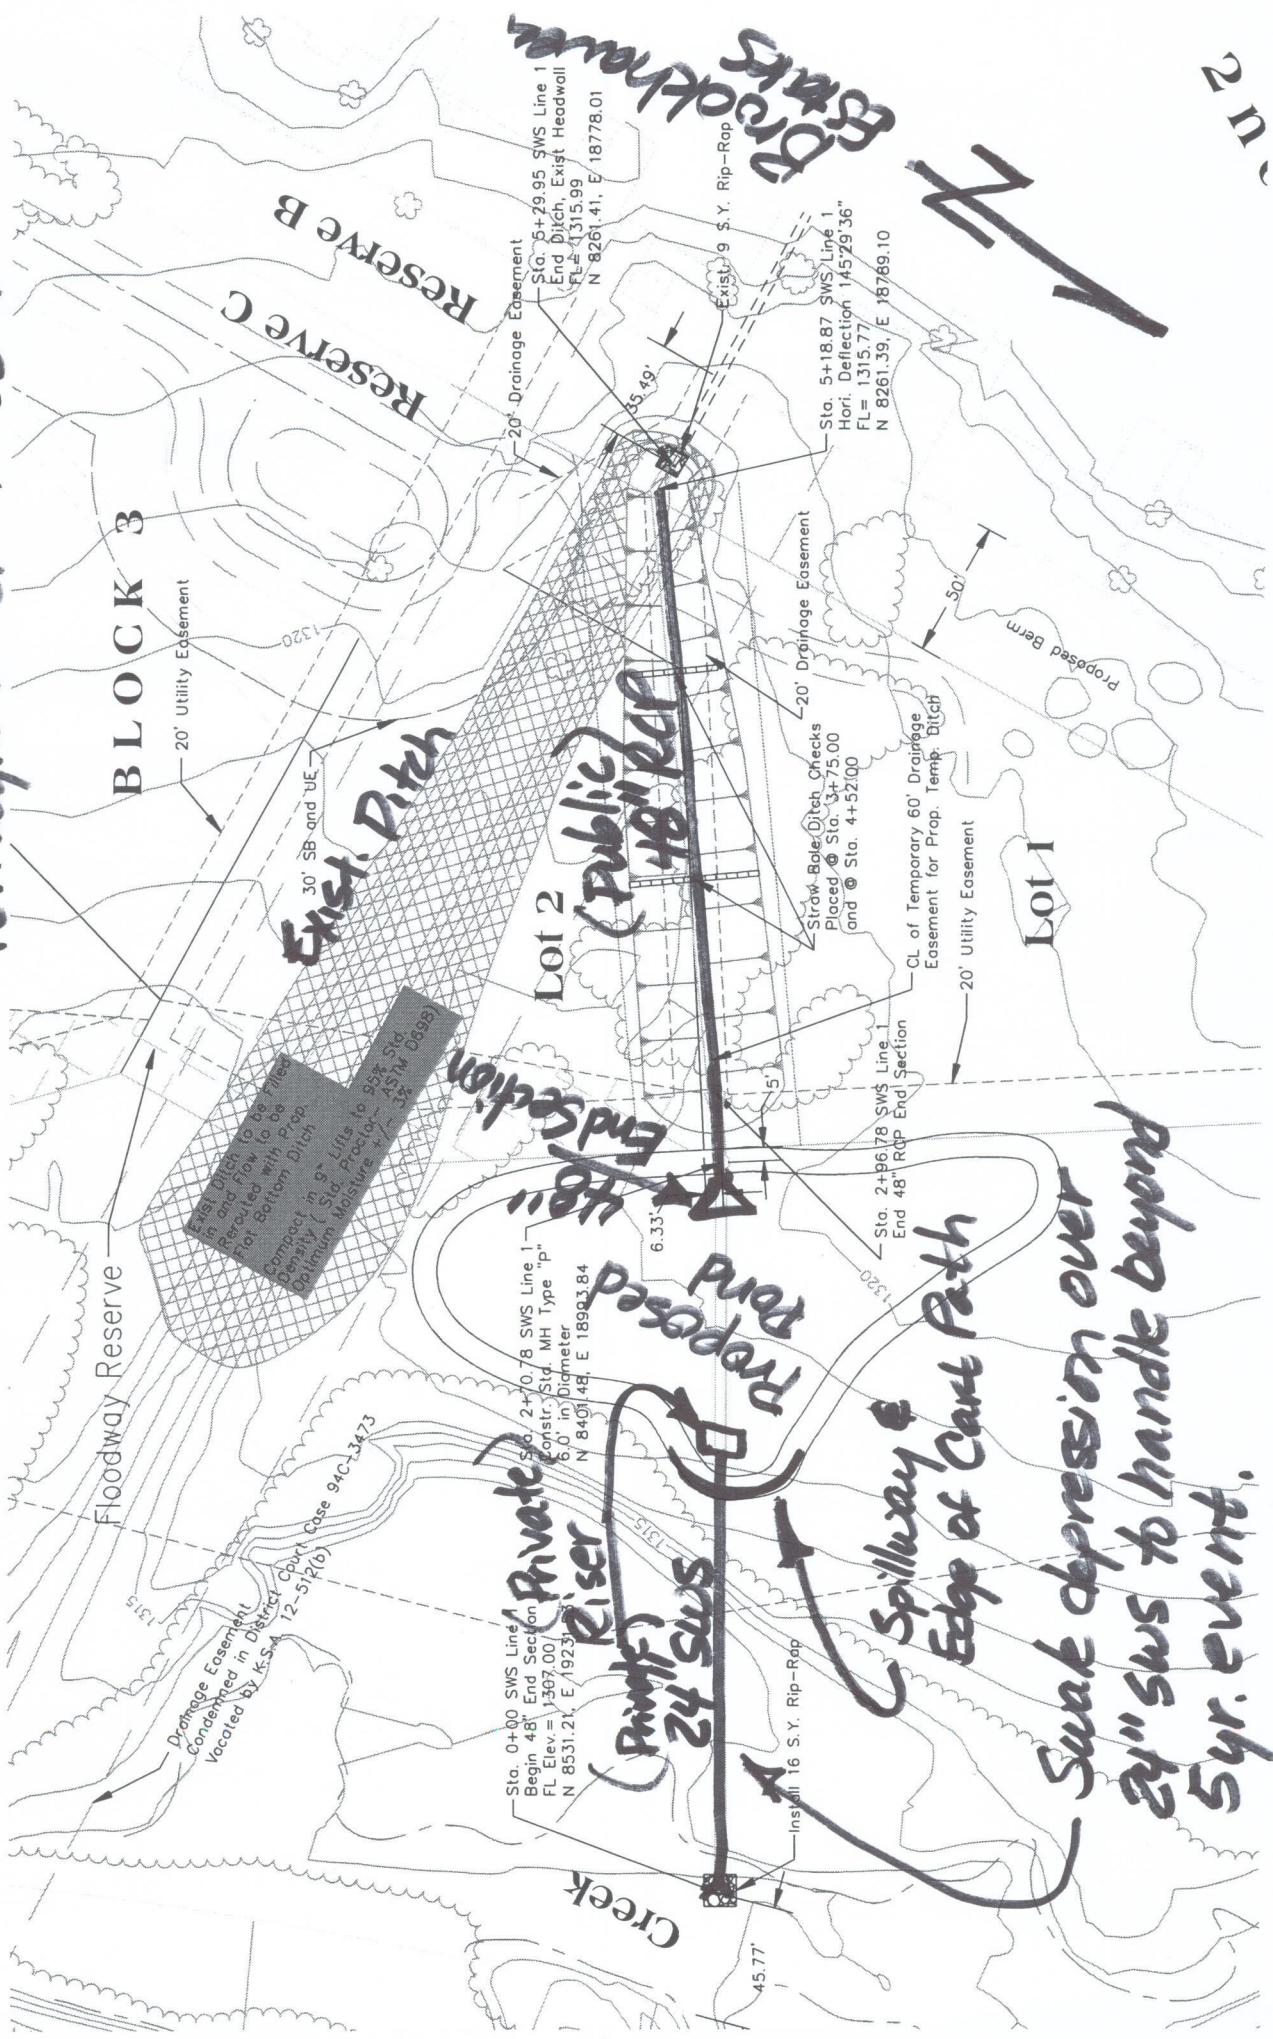

212