

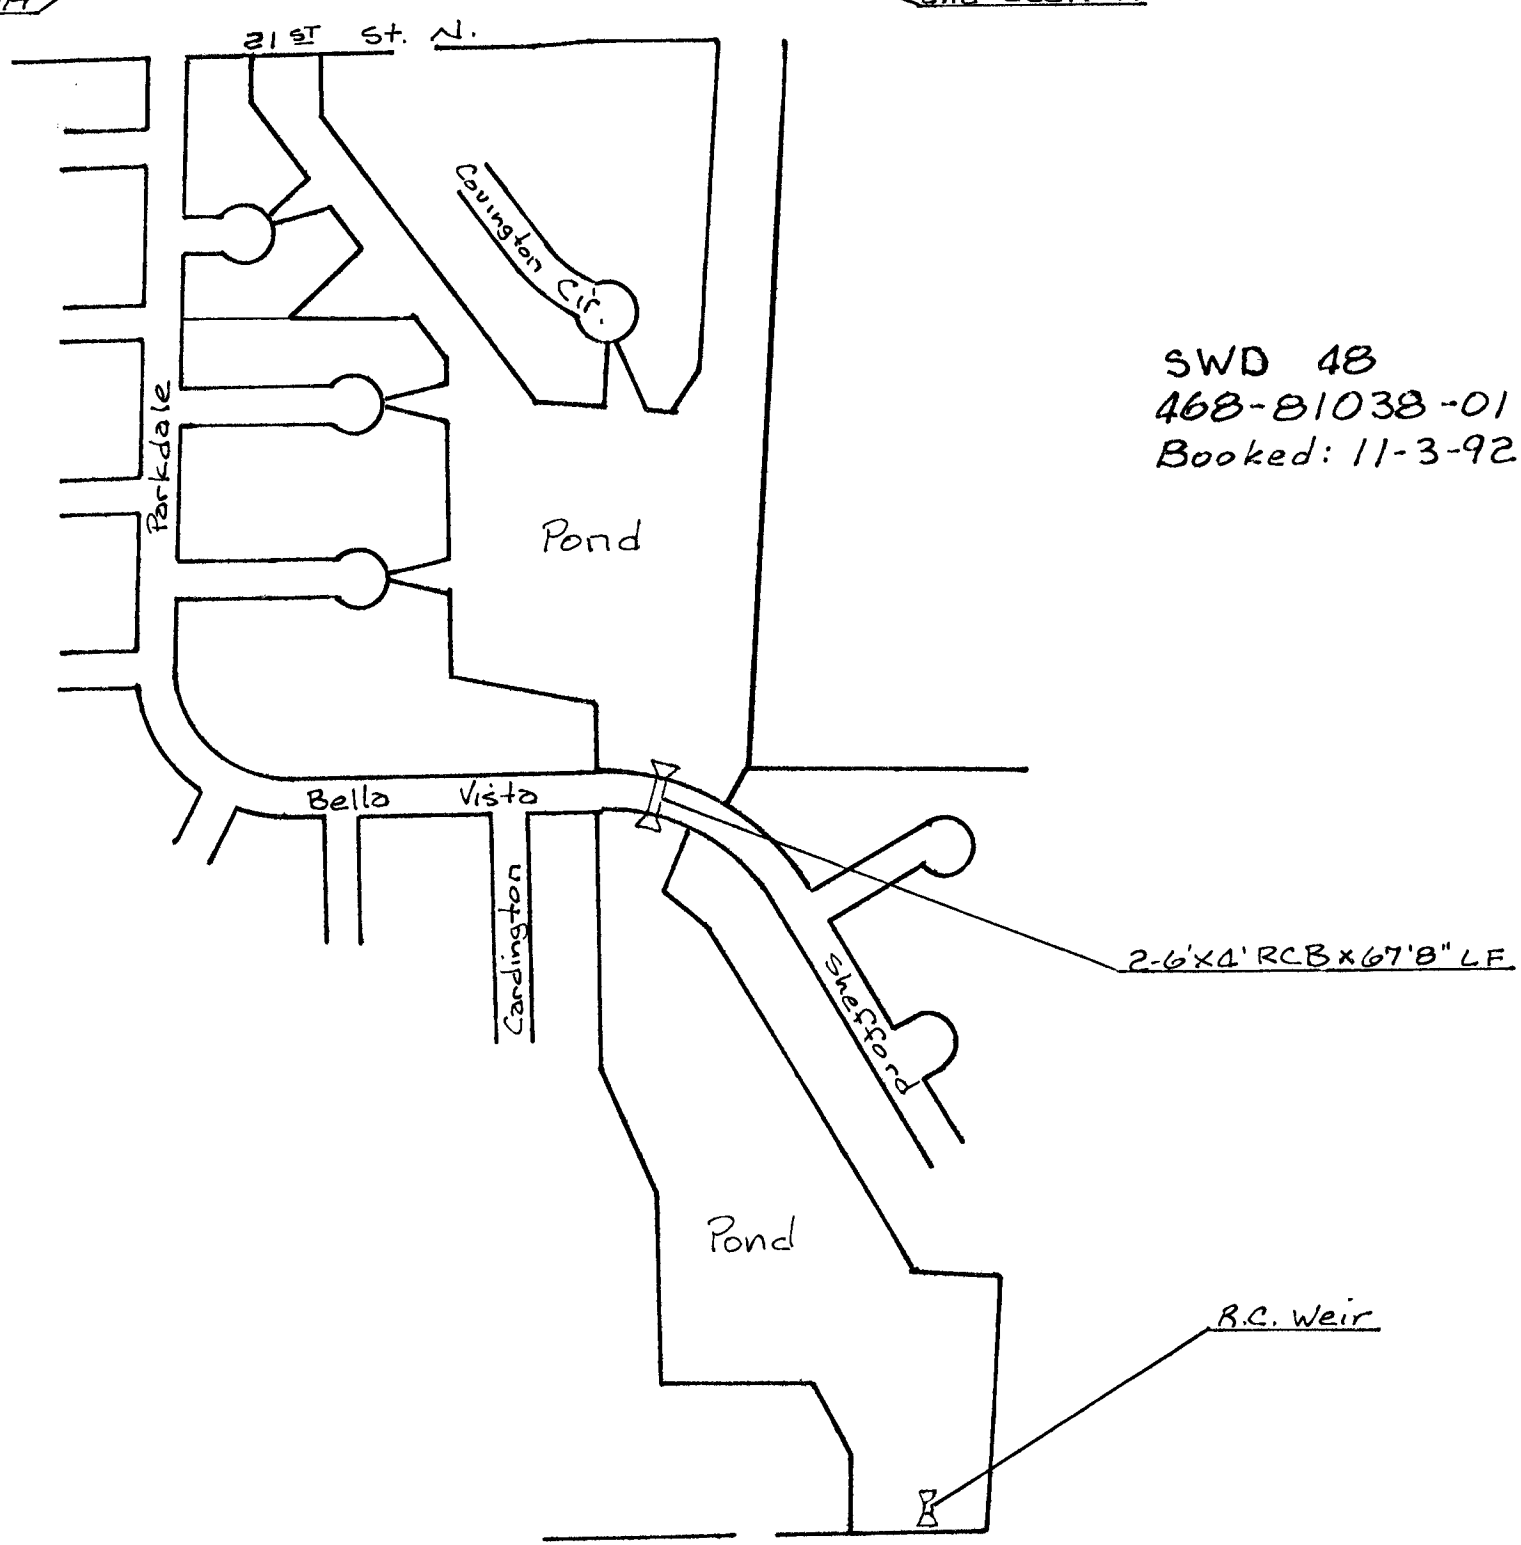


I.D. Towne Parc 3rd & 4th Priv.  
 Index No. 324 PPS  
 L.A. Knaebler Constr. Co.  
 Booked: 10-30-92, MCG

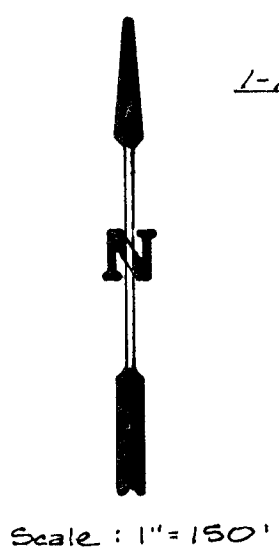

SWD 48  
 468-01038-01  
 Booked: 11-3-92, MCG

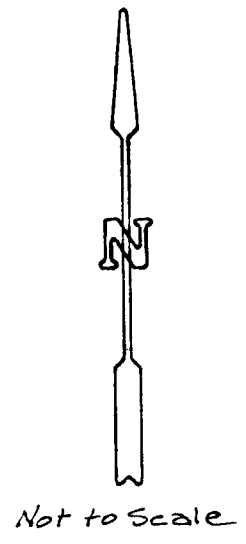

Priv. Towne Parc 3rd &  
4th Addition

Line 1

MANHOLES	CATCH BASIN INLETS
KIND No. GRADE DEPTH	NORTHWEST NORTHEAST SOUTHWEST SOUTHEAST
	SIZE KIND SIZE KIND SIZE KIND SIZE KIND
End Section 1	193.20
1-A Inlet 2	206.28 197.93
1-A Inlet 3	206.95 198.95
1-A Inlet 4	206.77 200.27
1-A Inlet 5	208.69 202.16
1-A Inlet 6	209.23 203.13
1-A Inlet 7	210.07 205.40
1-A Inlet 8	210.07 205.65

110' A 15" 41' B 15"

CATCH BASIN LEADS	MAIN LINES
N.W. N.E. S.W. S.E. FROM TO	KIND SIZE LENGTH
	M.H. M.H.
1 2	RCP 30" 229'
2 3	RCP 24" 95'
3 4	RCP 24" 91'
4 5	RCP 24" 334'
5 6	RCP 24" 63'
6 7	RCP 18" 171'
7 8	RCP 15" 41'

Line 2

End Section 1	198.01
Exists Inlet 2	197.20

1 2	RCP 21" 136'
-----	--------------

NUMBER

REMARKS

Line 3

End Section 1	193.20
1-A Inlet 2	206.48 200.90
1-A Inlet 3	206.39 201.40

1 2	RCP 18" 249'
2 3	RCP 15" 41'

SWD 48

2-6'x4'R.C.B.	1	152.5
	2	152.0
R.C. Weir	1	152.0
	2	151.72

67.8"