


SE COR BAYVIEW CONC STRO @ N/E COR Bldg.
30' S. W/2/1/2 (SOUTHWEST QUARTER 1/4 SECTION)

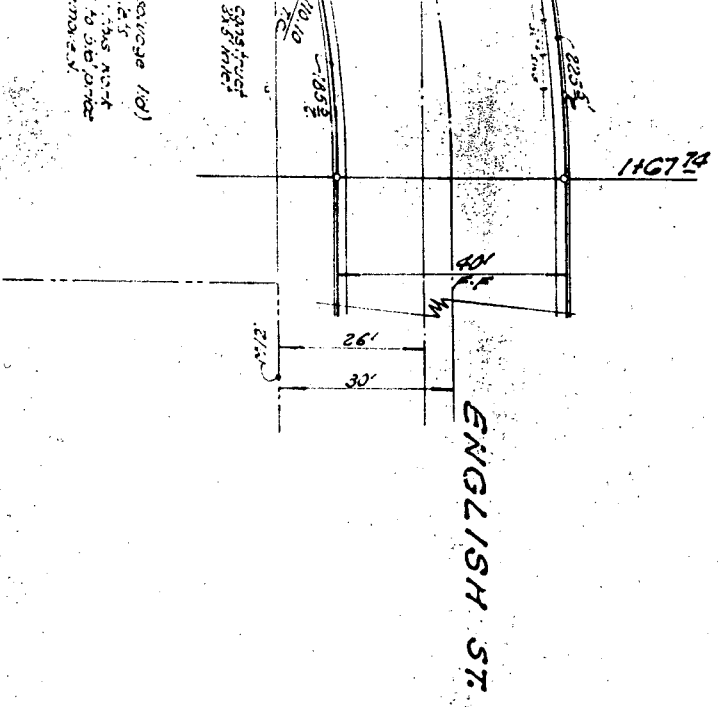

S.A.S. 11/28/85
Specs