


"UNPLATTED"  
RALPH R. WARNE  
RT. 2  
BELLE PLAINE, KS 67013

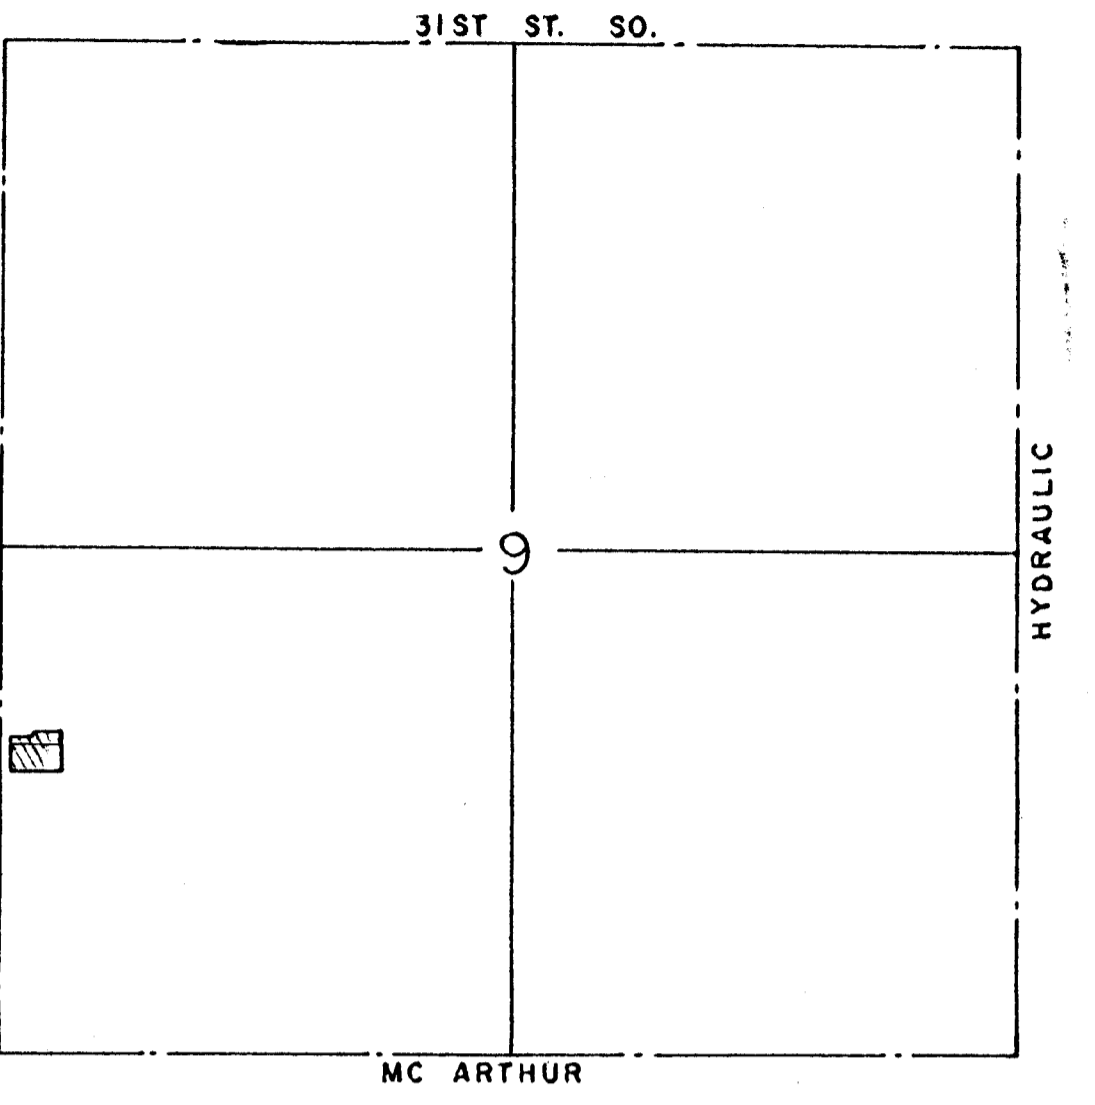

VICINITY MAP  
1" = 1000'

"UNPLATTED"  
RALPH R. WARNE  
RT. 2  
BELLE PLAINE, KS. 67013

*Need off-site drainage easement.*

REVISED DRAINAGE PLAN  
SKETCH PLAT  
ERNIE ALCORN ADDITION

"UNPLATTED"  
ERVIL F. CHAPMAN  
1023 LOCKWOOD  
WICHITA, KS. 67217

B.M. - ELEV. 89.85 - CITY STD. DISC. 32' E. & 29' S.  
OF SE COR. SE 1/4 SEC. 8 - 28 - 1E

TOPO MADE MARCH 28, 1985

LOT 1 - Zone change, Case No. Z-2663,  
from "C" to "E" - Light Industrial.  
LOT 2 - Zoned "C".

FOR:  
ERNIE ALCORN  
703 W. 45TH ST. SO.  
WICHITA, KS. 67217

LOWELL D HIGH, L.S.  
MARCH 29, 1985