


Notes:
 1 Salvage Curb Inlet Tops & 15" RCP
 if possible.

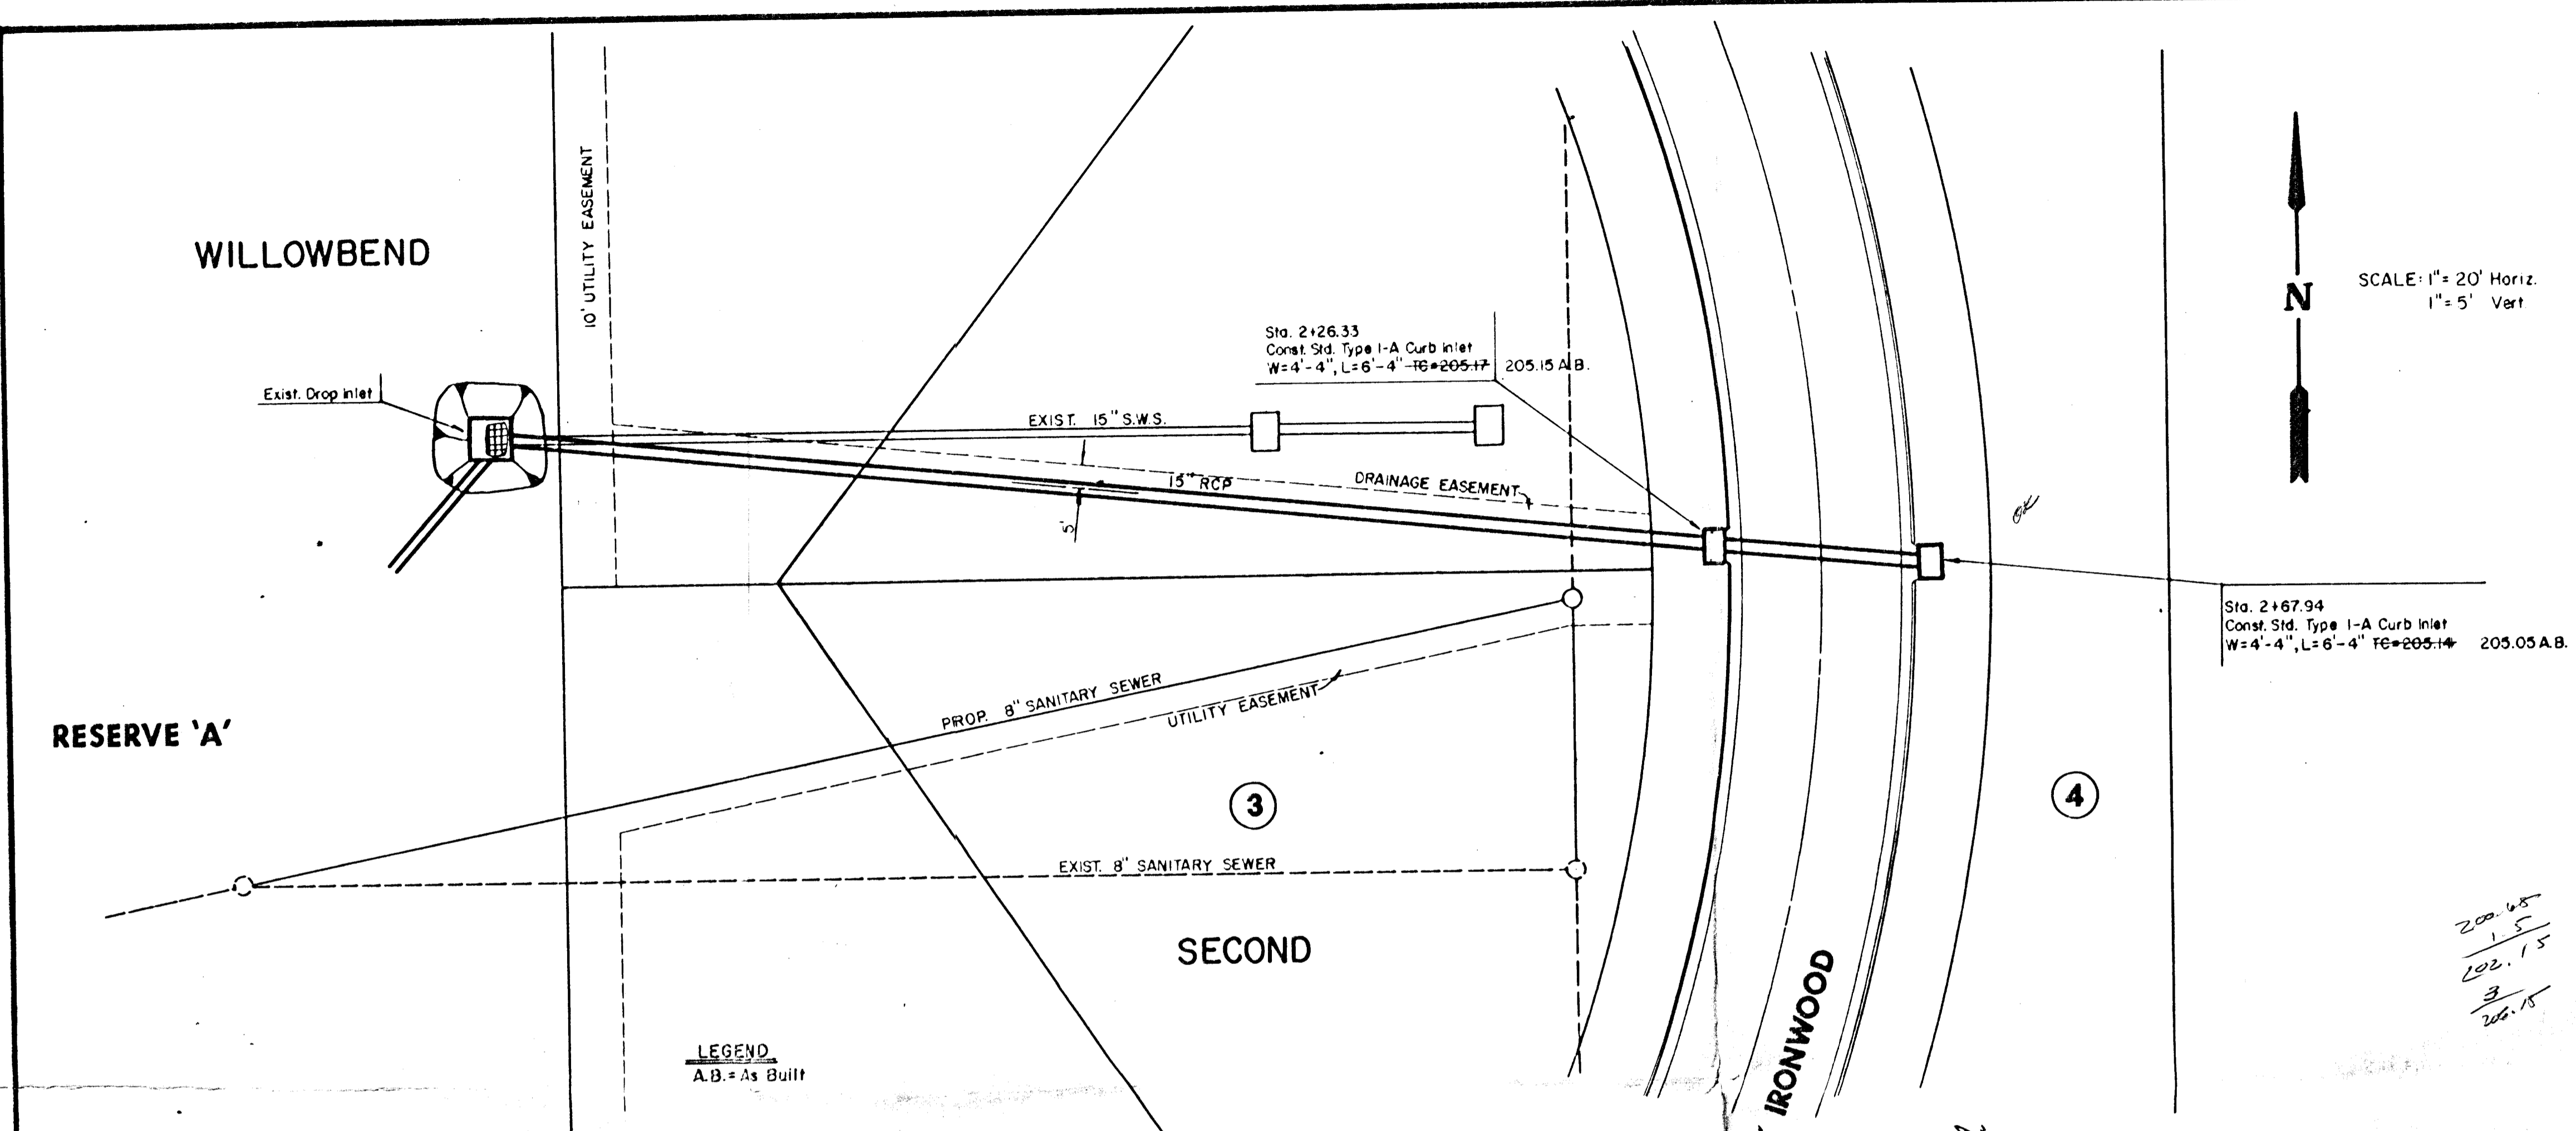

200.65
 1.5
 202.15
 3
 205.15

As Built
 Jan., 1987

LEGEND
 A.B. = As Built

