
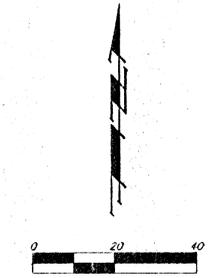


SKETCH PLAT
BORROR ADDITION
 WICHITA, SEDGWICK COUNTY, KANSAS

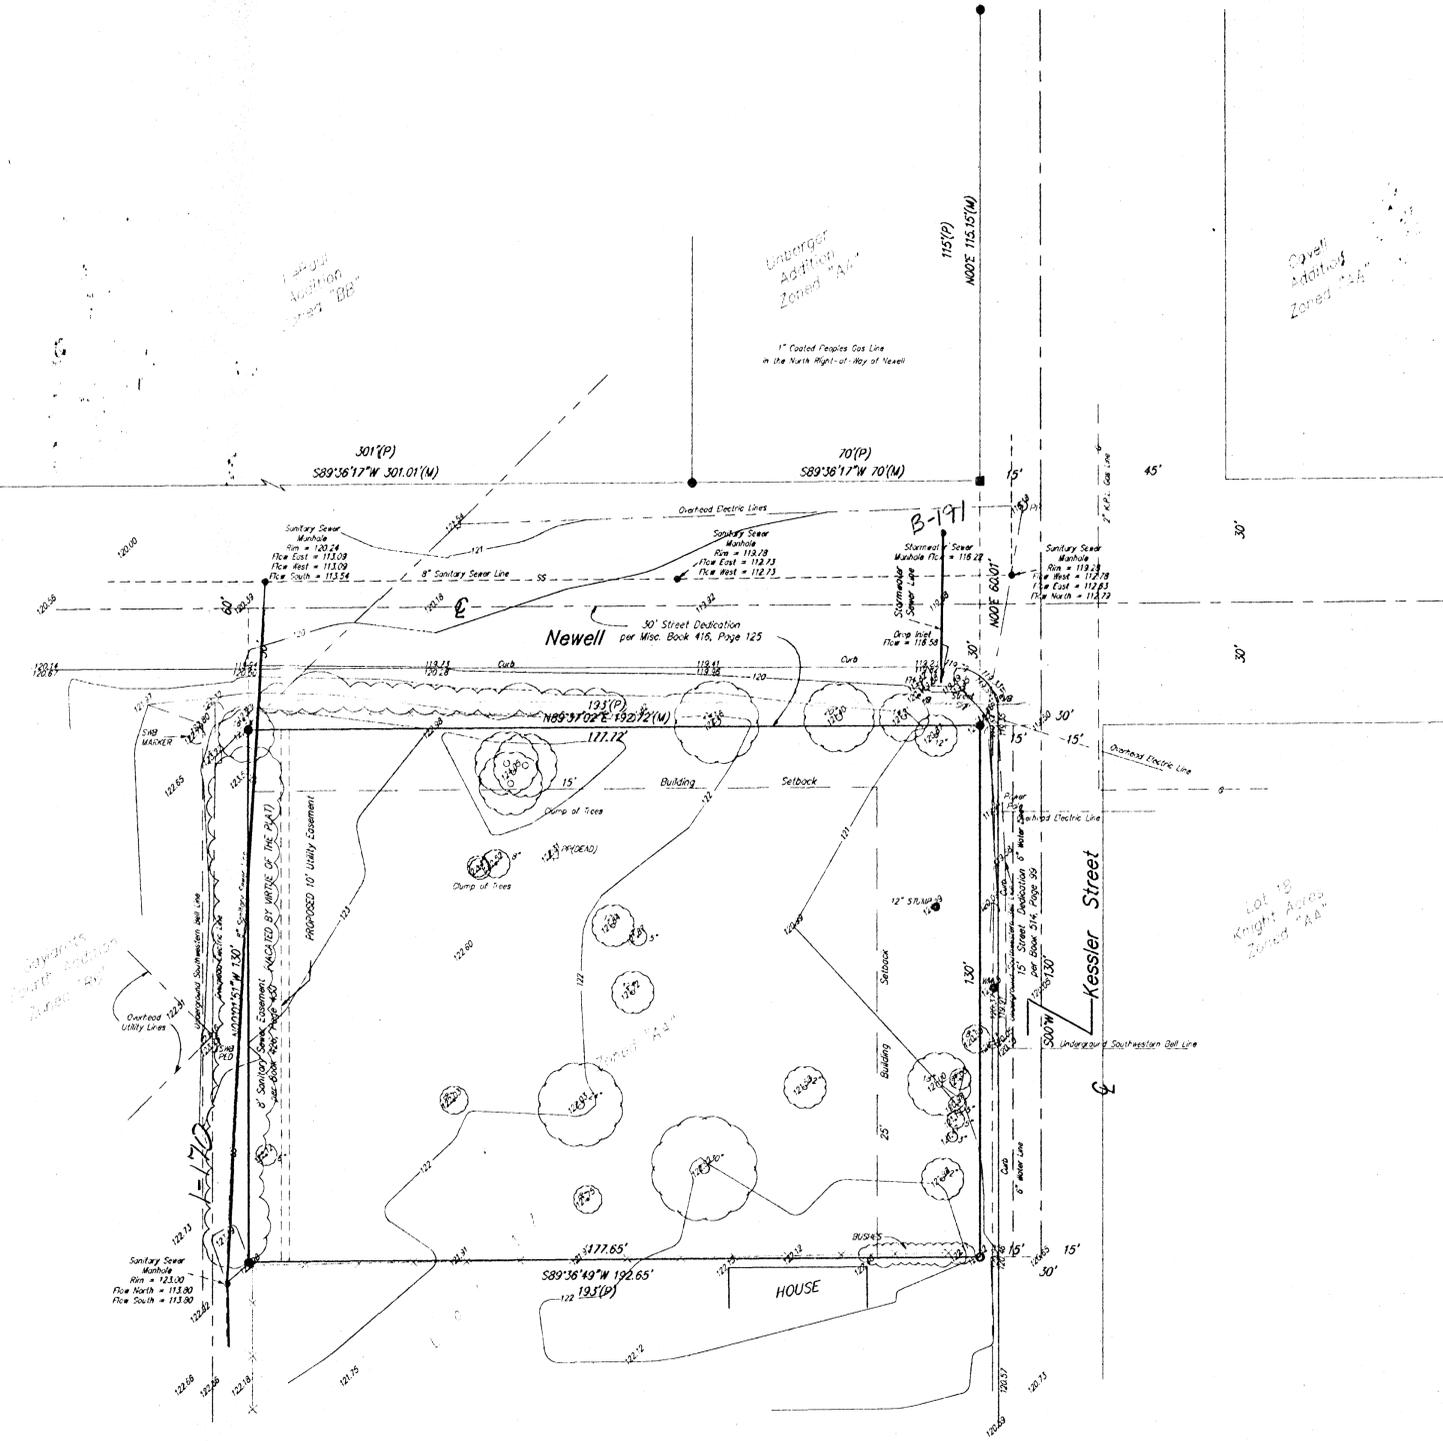


Contours @ 1' Intervals
 ● = 1/2" Iron Pipe Found
 ○ = #4 Baughman Rebar Set
 ■ = 3/4" Iron Pipe Found

LEGAL
 The north 160 feet of Lot 17, Except the north 30 feet for street, Knight Acres Addition, Wichita Sedgwick County, Kansas

BENCHMARK
 "□" 50 feet north and 50 feet west of the intersection of Central and West Street. Elevation = 122.53

OWNER
 Calvin A. Borrer &
 Barbara J. Borrer
 4615 Del Sienna
 Wichita, KS. 67212
 (316)943-1539

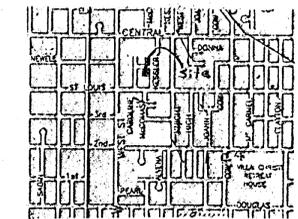

NOTE: The utility locations represented on this survey were compiled by both field observation and information from the various utility companies. If any construction or relocation is planned for this site the various utility companies should be requested to verify their locations in the field prior to final design or construction.