





Northings (N) & Eastings (E): State Plane Coordinates - Kansas Grid South - NAD83 (2011), EPOCH 2023.  
 Elevations: NAVD88 (Geoid 18).  
 As-Built Survey Shots By: Baughman Company, P.A.

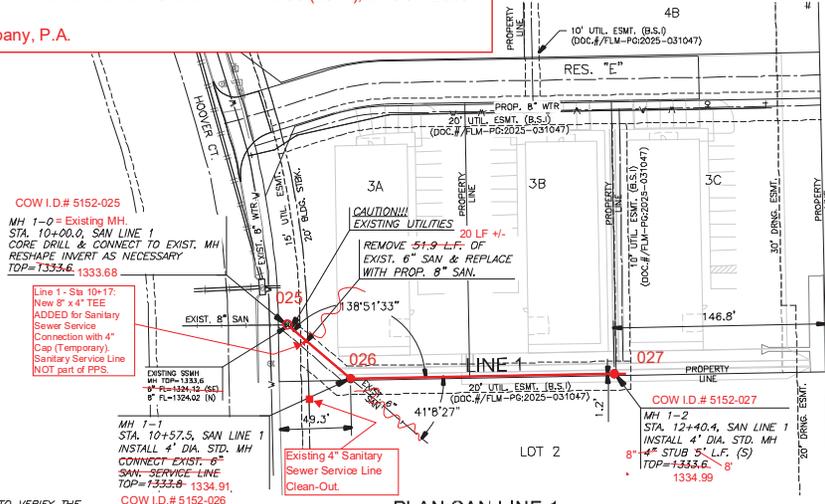

- NOTES:**
- CONTRACTOR TO VERIFY THE DEPTH AND LOCATION OF EXISTING UTILITIES PRIOR TO CONSTRUCTION.
  - CONTRACTOR IS RESPONSIBLE FOR BY-PASS PUMPING FOR ALL FLOW THROUGH THE EXISTING 6" SERVICE LINE. COORDINATE WITH OWNER ON LOT 2 FOR ANY INTERRUPTIONS TO SERVICE. REFER TO NOTE #24 ON SHEET 01.

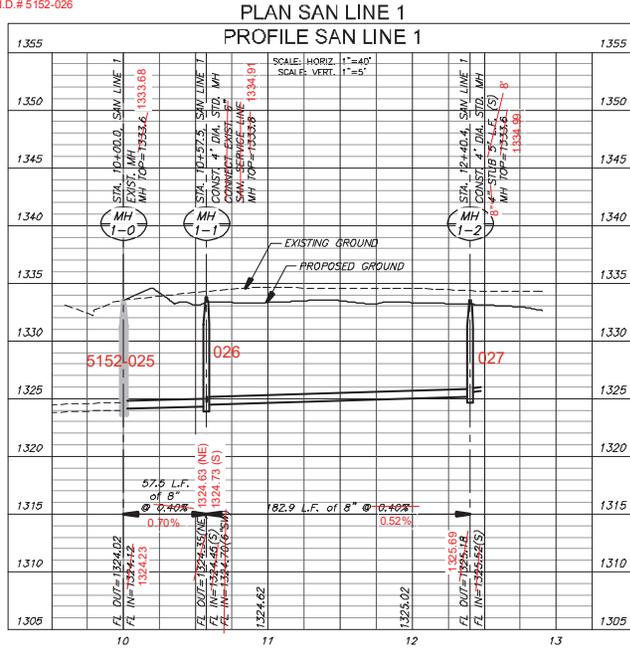

AS-BUILT GPS SURVEY

Northing	Easting	Top Lid Elevation	Item	Station
1,711,387.73	1,628,711.94	1333.68	MH 1-0	10+00.0
1,711,344.09	1,628,675.23	1334.91	MH 1-1	10+57.5
1,711,160.99	1,628,677.67	1334.99	MH 1-2	12+40.4

**NOTE:**  
 Nearby existing building sanitary sewer service waste was temporarily By- Passed to Manhole 1-0, during Sanitary Sewer Line 1 installation.



PRIVATE SANITARY SEWER FOR  
**HOOVER INDUSTRIAL PARK 2ND**  
 WICHITA, KANSAS

SAN LINE 1

PROJECT NO.	2025-008569PPS
SCALE	1" = 40'
DRAWN BY	HHK
CHECKED BY	DFL
DATE	KDA
SHEET NO.	CU101-S
	02 OF 10

