

GENERAL NOTES:

1. The Contractor shall comply with all applicable safety regulations. All construction shall be completed following current City Standard Specifications and Special Provisions.

2. Contractor will be required to provide notice to utility companies a minimum of seventy-two (72) hours prior to any excavation, as follows:

Kansas One-Call 687-2470

The Contractor must notify the following in case of an emergency:

AT&T 1-800-246-8464
 Black Hills Energy 1-800-694-8989
 City of Wichita Water & Sewer 1-316-219-9921
 City of Wichita Stormwater 1-316-268-4090
 City of Wichita Traffic 1-316-268-4034
 Cox Communications 1-888-249-1630
 Kansas Gas Service 1-888-482-4930
 Westar Energy 1-800-544-4857

3. Utility service lines, poles, etc. are to be adjusted as necessary by others prior to construction unless the plans specifically call for their adjustment by the Contractor or unless the plans specifically identify a utility to be adjusted by its owner during construction. Existing utilities and their location, as shown on the plans, represent the best information obtainable for design. The Contractor will be required to work around existing utilities within the right-of-way which do not conflict with proposed construction.

4. Rubble from the removal of miscellaneous structures and access excavation which is to be wasted shall be disposed of on sites to be provided by the Contractor. These sites shall be approved by the Engineer as to suitability, appearance and site location. Locations, in the opinion of the Engineer, that will leave an unsightly appearance will not be approved. All disposal sites must be approved by the Kansas Department of Health and Environment. Material either stockpiled or disposed of in a flood plain will require a Kansas State Board of Agriculture permit. Any material dumped in waters of the United States or wetlands is subject to U.S. Corps of Engineers permitting regulations. Any material buried or stockpiled beyond approved construction limits will require additional archaeological investigations unless buried in a previously approved borrow location.

5. Trees and shrubs in public right-of-way which are in direct conflict with proposed new construction shall be removed by the Contractor with the City Engineer's approval. Trees and shrubs which are not in direct conflict with proposed new construction shall be saved and protected from damage.

6. The Contractor shall give all property owners and/or tenants of developed property abutting the construction of this project a minimum of ten (10) days notice prior to start of construction.

7. The Contractor shall be responsible for preserving property irons. The Contractor will be required to re-establish any property irons which are damaged or destroyed by his construction operations. Such irons shall be re-established by a licensed land surveyor in accordance with state laws.

8. The Engineering Division shall field locate water valves one time during construction when requested by the Contractor. It shall be the Contractor's responsibility to preserve such field locations during the construction process. Water valves, valve boxes or fire hydrants damaged during construction shall be repaired by Contractor at his own expense. Valve boxes and water meters within the project limits shall be adjusted to match final grades by the contractor.

9. The Contractor shall notify the inspecting engineer and Dawnita Reinhardt at 316-268-4574 with the City of Wichita with the anticipated construction start date and notify them of project completion. Staking and inspection for this project will be the responsibility of the Contractor.

10. If traffic will be impacted by construction, a traffic control plan must be submitted and approved by the City Traffic Engineer, Mike Armour at micarmour@cityofwichita.gov before construction can begin. The Contractor shall be responsible for all traffic control measures to facilitate construction. All construction zone markings and signage shall conform to the latest version of the Manual on Uniform Traffic Control Devices (MUTCD) as published by the US Dept. of Transportation, Federal Highway Administration. All costs associated with construction markings and signage shall be the Contractors responsibility.

11. All elevations shown are NAVD 88.

12. All areas disturbed during construction that will not be under proposed pavement shall be restored to match existing conditions.

13. Any sidewalk, drive approach, curb, or street pavement removed to construct project must have a pavement cut permit and be replaced by the City contractor. Permits can be obtained by calling 316-268-4501 or 316-268-4480.

14. All applicable fees (tap, equity in lieu of & main benefit) must be paid before any connections can be made on this project. Quotes can be obtained on fees by calling 316-268-4535.

15. City Maintenance of sanitary sewer mains ends at last structure within the easement or right-of-way.

16. All stubs and capped pipes shall be located with green plastic tape in the same manner as risers.

17. Connecting to Existing Manholes: Prior to laying sewer lines using existing stubs in existing manholes, the Contractor shall expose and verify the elevation, grade and alignment of existing stubs and notify the Engineer of any deviation from the plans. Where the stub is unusable due to elevation grade or alignment, the Contractor shall remove the stub and plug the hole, and reshape the existing manhole invert to provide smooth flow. Where connecting to an existing manhole that does not have an existing stub, the Contractor shall core cut into existing manhole wall to make connection using approved water stop gasket, and reshape the existing manhole invert to provide smooth flow. The cost to connecting to existing manholes is incidental to the project.

18. Contractor shall limit the extent of trench open overnight and weekends to less than 50 feet.

19. Contractor shall provide positive drainage away from all manhole covers.

20. The Contractor shall prevent any construction debris from entering the existing sanitary sewer during construction.

21. The Contractor shall be responsible for maintaining continuous flow of sewage through construction. Contractors proposed method for maintaining sewage flow shall be submitted and approved by the Sewer Maintenance Division (316-268-4073) prior to starting and by-passing of sewage flows.

22. Any over excavation from manhole and pipe removal shall be backfilled with AB-3 compacted to 90-95% ASTM D698.

23. The Contractor shall protect from damage and support existing utilities through construction as approved by the utility owner and the Engineer at the contractors expense.


SANITARY SEWER SYSTEM REMOVAL

to serve

DOUGLAS FLATS

1301 W DOUGLAS AVE CITY OF WICHITA, KANSAS


Paul Gunzelman, P.E. City Engineer
 Project Number
 2025-035210PPS (53030982) (SEH-185445)

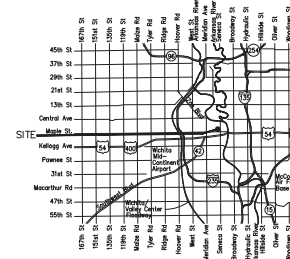

Vicinity Map

5347B
 SSI-07


| Sheet List Table | |
|------------------|----------------------|
| Sheet | Sheet Title |
| 1 | TITLE |
| 2 | SSWR REMOVAL PPRO |
| 3 | EROSION CONTROL PLAN |
| 4 | BMP 1 |
| 5 | BMP 2 |
| 6 | BMP 3 |
| 7 | BMP 4 |
| 8 | BMP 5 |

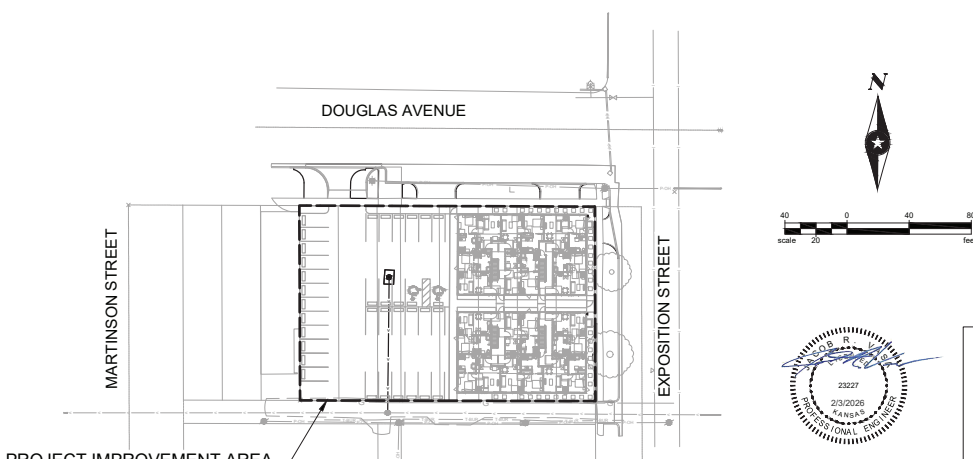

CONTROL POINTS

- 6 FOUND 3/4" IRON PIPE APPROXIMATELY 110.0 FEET WEST FROM THE NORTHWEST CORNER OF SUBJECT PROPERTY. N 1684730.9523 E 1643247.9616
- 8 AT THE INTERSECTION OF MARTINSON AND TEXAS AVENUE FOUND 3/4" IRON PIPE APPROXIMATELY 192.2 FEET SOUTH AND 106.1 FEET WEST FROM THE SOUTHWEST CORNER OF SUBJECT PROPERTY. N 1684414.8318 E 1643254.8281
- 12 AT THE INTERSECTION OF EXPOSITION STREET AND TEXAS AVENUE FOUND 3/4" IRON PIPE APPROXIMATELY 189.7 FEET SOUTH AND 34.0 FEET EAST FROM THE SOUTHWEST CORNER OF SUBJECT PROPERTY. N 1684420.2110 E 1643584.8250
- 33 CHISELED "X" CUT ON TOP OF CURB IN THE SOUTHEAST QUADRANT OF DOUGLAS AVENUE AND EXPOSITION STREET APPROXIMATELY 10.4 FEET NORTH AND 51.2 FEET EAST FROM THE NORTHEAST CORNER OF LOT 41, MARTINSON'S 4TH ADDITION N 1684743.5152 E 1643599.3547 ELEV 1300.07

AS BUILT

| | |
|--|---|
| <p>Contractor: McCullough Excavation 15 May 2026</p> | <p>Project Inspector: Eric Miner  117 E. Lewis, Wichita, KS 67202 (316)264-0242</p> |
|--|---|

APPROVED AS NOTED
 BY WICHITA PUBLIC WORKS
 ENGINEERING DIVISION

Engineering Bethany Mally 1/23/26
 Utilities Scott Macey 1/23/26

NOTE TO CONTRACTORS

Inspection and testing for this project is to be provided by a Licensed Consulting Engineering Firm under contract with the Owner/Developer. Said inspection to be in accordance with the City of Wichita standard construction engineering practices and certified by a Licensed Professional Engineer in the state of Kansas. No work shall be performed by the Contractor without such inspection shall any work be commenced without written authorization by City Engineering. All Construction and Materials shall comply with current City of Wichita Specifications and Standards and Special Provisions (on file and available at Wichita.gov).

An approved copy of these plans signed by City staff are required on-site.





PHONE: 402.513.8200
 15750 DODGE RD.
 SUITE 304
 OMAHA, NE 68118
www.sehinc.com


AS BUILTS



BUILT PER PLAN

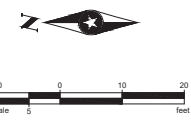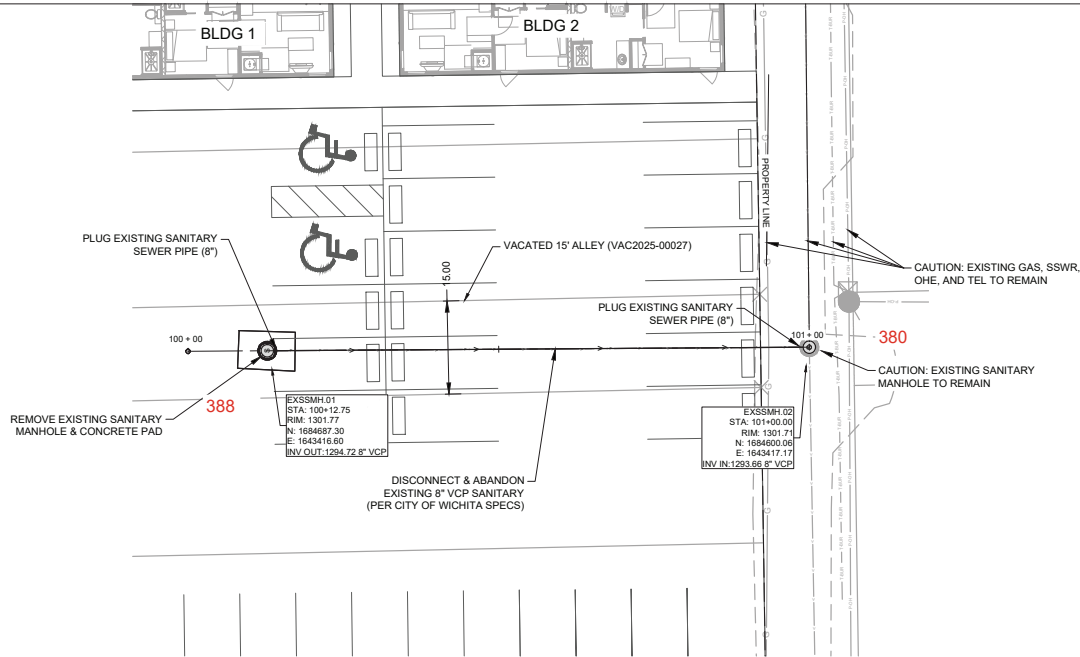

- UTILITY NOTES:
- CONTRACTOR TO VERIFY DEPTH AND LOCATION OF EXISTING UTILITIES. CONTRACTOR TO RELOCATE ANY EXISTING UTILITIES AS NECESSARY FOR CONSTRUCTION.
 - CONTACT UTILITIES COMPANIES 3 WEEKS PRIOR TO CONSTRUCTION TO COORDINATE TEMPORARY REMOVAL/REPLACEMENT, HEIDE BRYAN, EVERGY, (316) 261-6354, SHANNON BRINKMEYER, AT&T, (316)-268-2931, TRAVIS TAYLOR, COX COMM., TRAVIS.TAYLOR@COX.COM

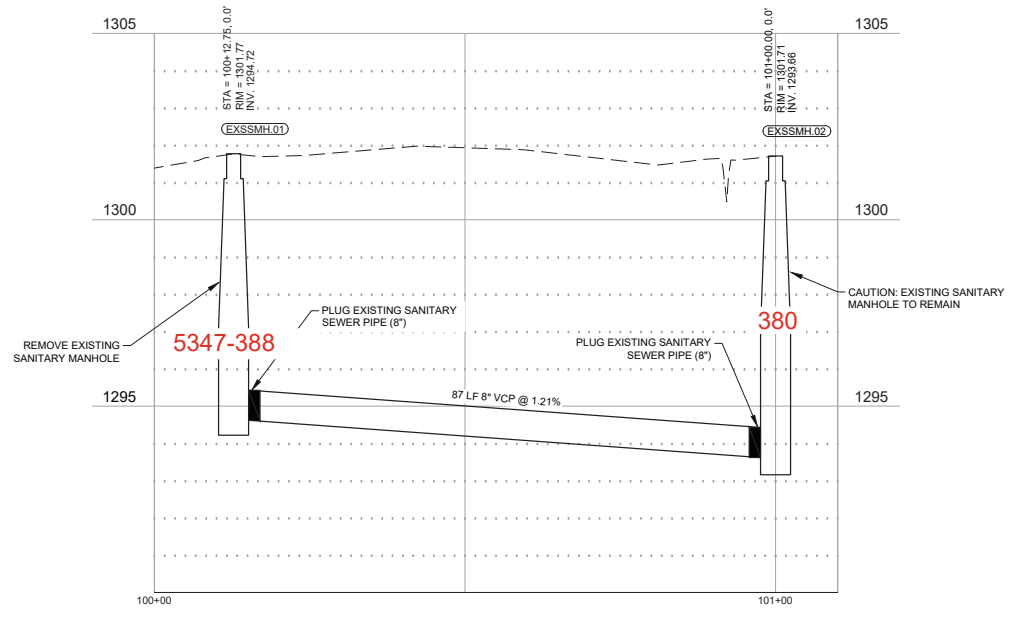



SHORT ELLIOTT HENDRICKSON INC.

PHONE: 402.513.8200
13750 DODGE RD., SUITE 304
OMAHA, NE 68118
www.sehinc.com

DOUGLAS FLATS

SSWR REMOVAL PPRO

SANITARY SEWER SYSTEM

PROJECT NUMBER: IN185445

DESIGN: JRV DRAWN: JRB

DATE: 01-09-2026

SHEET: 2 OF 8

S:\18\2026\185445\185445-Final.dwg(185445-Final.dwg) 2/3/2026 8:40 PM X:\EJ\JWIN\CS1\185445-Final.dwg(185445-Final.dwg) PPS_PPRO.dwg