

GENERAL NOTES:

1. The Contractor shall comply with all applicable safety regulations. All construction shall be completed following current City Standard Specifications and Special Provisions.

2. Contractor will be required to provide notice to utility companies a minimum of seventy-two (72) hours prior to any excavation, as follows:

Kansas One-Call 687-2470

The Contractor must notify the following in case of an emergency:

AT&T 1-800-246-8464  
Black Hills Energy 1-800-694-8989  
City of Wichita Water & Sewer 1-316-219-8921  
City of Wichita Stormwater 1-316-268-4090  
City of Wichita Traffic 1-316-268-4034  
Cox Communications 1-888-249-3530  
Kansas Gas Service 1-888-482-4950  
Energy 1-800-544-4857

3. Utility service lines, poles, etc. are to be adjusted as necessary by others prior to construction unless the plans specifically call for their adjustment by the Contractor or unless the plans specifically identify a utility to be adjusted by its owner during construction. Existing utilities and their location, as shown on the plans, represent the best information obtainable for design. The Contractor will be required to work around existing utilities within the right-of-way which do not conflict with proposed construction.

4. Rubble from the removal of miscellaneous structures and excess excavation which is to be wasted shall be disposed of on sites to be provided by the Contractor. These sites shall be approved by the Engineer as to suitability, appearance and site location. Locations, in the opinion of the Engineer, that will leave an unsightly appearance will not be approved. All disposal sites must be approved by the Kansas Department of Health and Environment. Material either stockpiled or disposed of in a flood plain will require a Kansas State Board of Agriculture permit. Any material dumped in waters of the United States or wetlands is subject to U.S. Corps. of Engineers permitting regulations. Any material buried or stockpiled beyond approved construction limits will require additional archaeological investigations unless buried in a previously approved borrow location.

5. Trees and shrubs in public right-of-way which are in direct conflict with proposed new construction shall be removed by the Contractor with the City Engineer's approval. Trees and shrubs which are not in direct conflict with proposed new construction shall be saved and protected from damage.

6. The Contractor shall give all property owners and/or tenants of developed property abutting the construction of this project a minimum of ten (10) days notice prior to start of construction.

7. The Contractor shall be responsible for preserving property irons. The Contractor will be required to re-establish any property irons which are damaged or destroyed by his construction operations. Such irons shall be re-established by a licensed land surveyor in accordance with state laws

8. The Engineering Division shall field locate water valve one time during construction when requested by the Contractor. It shall be the Contractor's responsibility to preserve such field locations during the construction process. Water valves, valve boxes or fire hydrants damaged during construction shall be repaired by Contractor at his own expense. Valve boxes and water meters within the project limits shall be adjusted to match field grades by the contractor.

9. The Contractor shall notify the consultant engineer and Dawnita Reinhardt at 316-650-0740 with the City of Wichita with the anticipated construction start date and notify them of project completion. Staking and inspection for this project will be the responsibility of the Contractor.

10. If traffic will be impacted by construction, a traffic control plan must be submitted and approved by the City Traffic Engineer at [traffic@wichita.gov](mailto:traffic@wichita.gov) before construction can begin. The Contractor shall be responsible for all traffic control measures to facilitate construction. All construction zone markings and signage shall conform to the latest version of Manual on Uniform Traffic Control Devices (MUTCD) as published by the US Dept. of Transportation, Federal Highway Administration. All costs associated with construction markings and signage shall be the Contractors responsibility.

11. All elevations shown are NAVD88.

12. All areas disturbed during construction that will not be under proposed pavement shall be restored to match existing conditions per City specifications.

13. All applicable fees (tap, equity, in lieu of & main benefit) must be paid before any connections can be made on this project. Quotes can be obtained on fees by calling 316-268-4555.

14. All stubs and capped pipes shall be located with green plastic tape in the same manner as risers.

15. Connecting to Existing Manholes:  
Prior to laying sewer lines using existing stubs in existing manholes, the Contractor shall expose and verify the elevation, grade and alignment of existing stubs and notify the Engineer of any deviation from the plans. Where the stub is unusable due to elevation grade or alignment, the Contractor shall remove the stub and plug the hole, and reshape the existing manhole invert to provide smooth flow. Where connection to an existing manhole that does not have an existing stub, the Contractor shall core cut into existing manhole wall to make connection using approved water stop gasket, and reshape the existing manhole invert to provide smooth flow. The cost of connect to existing manholes is incidental to the project.

16. Contractor shall provide positive drainage away from all manhole covers.

17. The Contractor shall prevent any construction debris from entering the existing sanitary sewer during construction.

18. The Contractor shall be responsible for maintaining continuous flow of sewage through construction. Contractors proposed method for maintaining sewage flow shall be submitted and approved by the Sewer Maintenance Division (316-268-4073) prior to starting and by-passing of sewage flows.

19. Any over excavation from manhole and pipe removal shall be backfilled with AB-3 compacted to 90-95% ASTM D698.

20. The Contractor shall protect from damage and support existing utilities through construction as approved by the utility owner and the Engineer at the contractor's expense.

21. All areas disturbed during construction are to be seeded as follows:

Seed --- Rye grass; 5 lbs./1000 Sq. Ft.

All costs associated with seeding including mobilization, preparation of ground, seeding, fertilizing, mulching, etc. shall be included in the L.S. bid item "Seeding".

22. All existing and proposed erosion control measures including silt fencing, erosion control mat, straw bales, inlet barriers, and const. entrance shall be maintained throughout construction by the contractor and until project is accepted by the City of Wichita. The on-site engineer shall complete weekly reports on the status of erosion control measures. The contractor shall be required to comply with maintenance and/or replacement of erosion control measures as determined by the on-site engineer until project is accepted by City of Wichita. Maintenance and/or replacement of erosion control measures to be paid by L.S. bid item "Maintain Existing BMPs".

23. The Contractor shall not begin work on the project until the Project Inspector is assigned and on site. Any work completed without inspection will be required to be uncovered for inspection at the Contractor's expense.

Benchmarks

BM #1: "□" Square Cut  
Chiseled on top of curb, and  
drive way end of return.  
Elevation=1299.40 (NAVD88)

Control Point Used for As-Built GPS Survey.

N=368,615.73 E=17,543,584.78

BM #2: "□" Square Cut  
Chiseled on top of curb.  
Elevation=1299.32 (NAVD88)

AS - BUILT PLANS  
SANITARY SEWER IMPROVEMENTS

to serve

MAPLE ST. APARTMENTS

721 W. Maple St.

CITY OF WICHITA, KANSAS

Paul Gunzelman, P.E. City Engineer

2025-013467PPS

53030982

Baughman Job # 26-04-E483



NOTE:

Baughman Company, Inc. provided  
Post-Construction Inspection on these  
Sanitary Sewer Manhole Adjustments.

Utility Contractor: Carr's Plumbing and Maintenance  
Superintendent: Lee Roush  
Inspection: Baughman Company  
Inspector: Jeff Priddle + Eric Purk  
As-Built Plans: Larry Powell & Jeff Priddle  
June 08, 2026

Materials Used for Sanitary Sewer Manhole Adjustments:

\* Existing Frames and Covers.

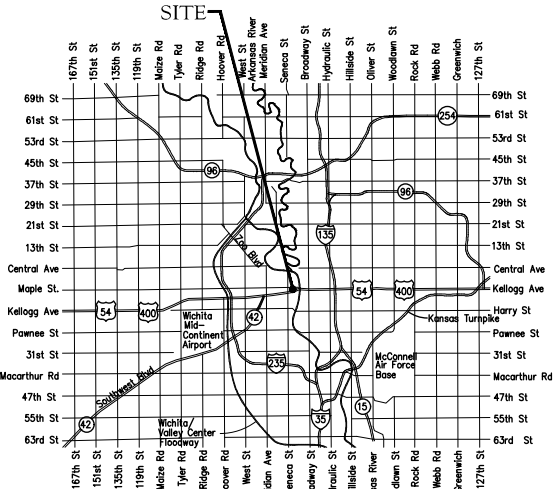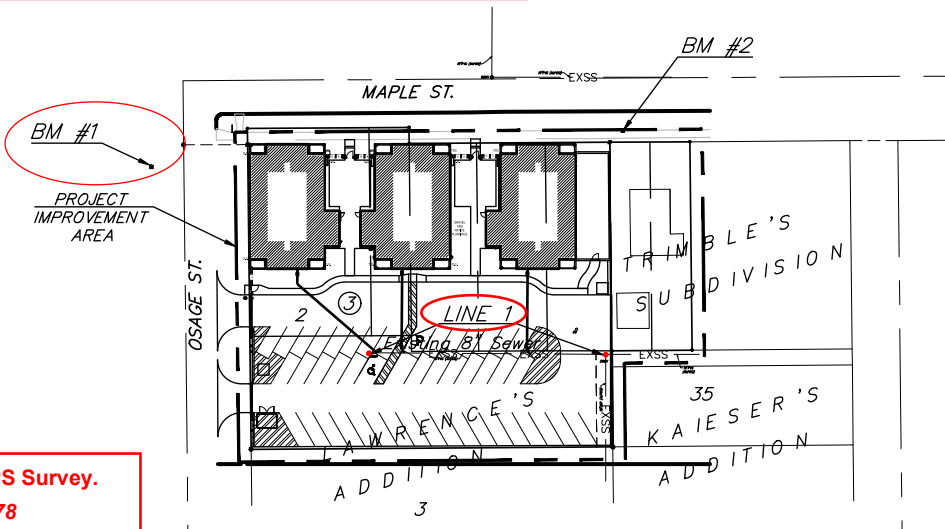

Vicinity Map

Construction Started = August 2025

Construction Ended = May 2026 +/-

Sheet Index

|                              |      |
|------------------------------|------|
| Title Sheet                  | 1    |
| Line 1                       | 2    |
| Erosion Control Plan         | 3    |
| Precast SS Manhole Detail    | 4    |
| Manhole Frame & Cover Detail | 5    |
| Erosion Control BMP Details  | 6-10 |
| Copy of Plat                 | 11   |

APPROVED AS NOTED  
BY WICHITA PUBLIC WORKS  
ENGINEERING DIVISION


Engineering approved by Shawn Mellies on 7/21/2025

Utilities approved by Scott Macey on 7/21/2025

NOTE TO CONTRACTORS

Inspection and testing for this project is to be provided by a Licensed Consulting Engineering Firm under contract with the Owner/Developer. Said inspection to be in accordance with the City of Wichita standard construction engineering practices and certified by a Licensed Professional Engineer in the state of Kansas. No work shall be performed by the Contractor without such inspection nor shall any work be commenced without written authorization by City Engineering. All Construction and Materials shall comply with the current City of Wichita Specifications and Standards and Special Provisions (on file and available at [Wichita.gov](http://Wichita.gov)).

An approved copy of these plans signed by City staff are required on-site.


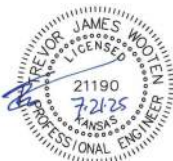


**BAUGHMAN COMPANY**  
315 Ellis St. Wichita, KS 67211 316-262-7271  
[BaughmanCo.com](http://BaughmanCo.com)

July 21, 2025

BM #1: "□" Square Cut  
Chiseled on top of curb, and  
drive way end of return.  
Elevation=1299.40 (NAVD88)

BM #2: "□" Square Cut  
Chiseled on top of curb.  
Elevation=1299.32 (NAVD88)

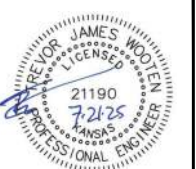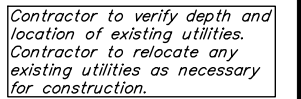

BAUGHMAN  
COMPANY

315 Ellis St.  
Wichita, KS 67211  
316-262-7271  
BaughmanCo.com

MAPLE ST.  
APARTMENTS

**LINE 1**

## SANITARY SEWER IMPROVEMENTS

PROJECT NUMBER:  
25-03-E058

DESIGN: DRAWN:

DATE: July 21, 2025

SHEET **2** OF **11**

L-3-5



Julius N. Bear

100

RECEIVED BY TRANSIT DEPT.  
 DEC 8 1915  
 W. P. BOARD.  
 CO. CLERK.

John D. O., S. 1874, and  
described in "Plot Book C," pages  
16-19.

H. R. Wadsworth

Ry. B. & Co., New York City


*H. D. Wickerson*

**FOR REFERENCE ONLY  
NOT TO SCALE**



This digital plat record accurately reproduces in all details the original plat filed with the Sedgwick County Register of Deeds. Digitized under the supervision of Register of Deeds Bill Meek by Sedgwick County Geographic Information Systems.

Bill Meek, Register of Deeds  
Digitized rendition of original signature

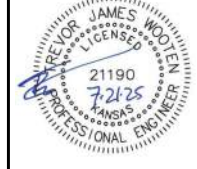BAUGHMAN  
COMPANY

315 Ellis St.  
Wichita, KS 67211  
316-262-7271  
BaughmanCo.com

MAPLE ST.  
APARTMENTS

**COPY OF  
PLAT**

## SANITARY SEWER IMPROVEMENTS

PROJECT NUMBER:  
25-03-E058

DESIGN: DRAWN:

DATE: July 21, 2025

SHEET **11** OF **1**