




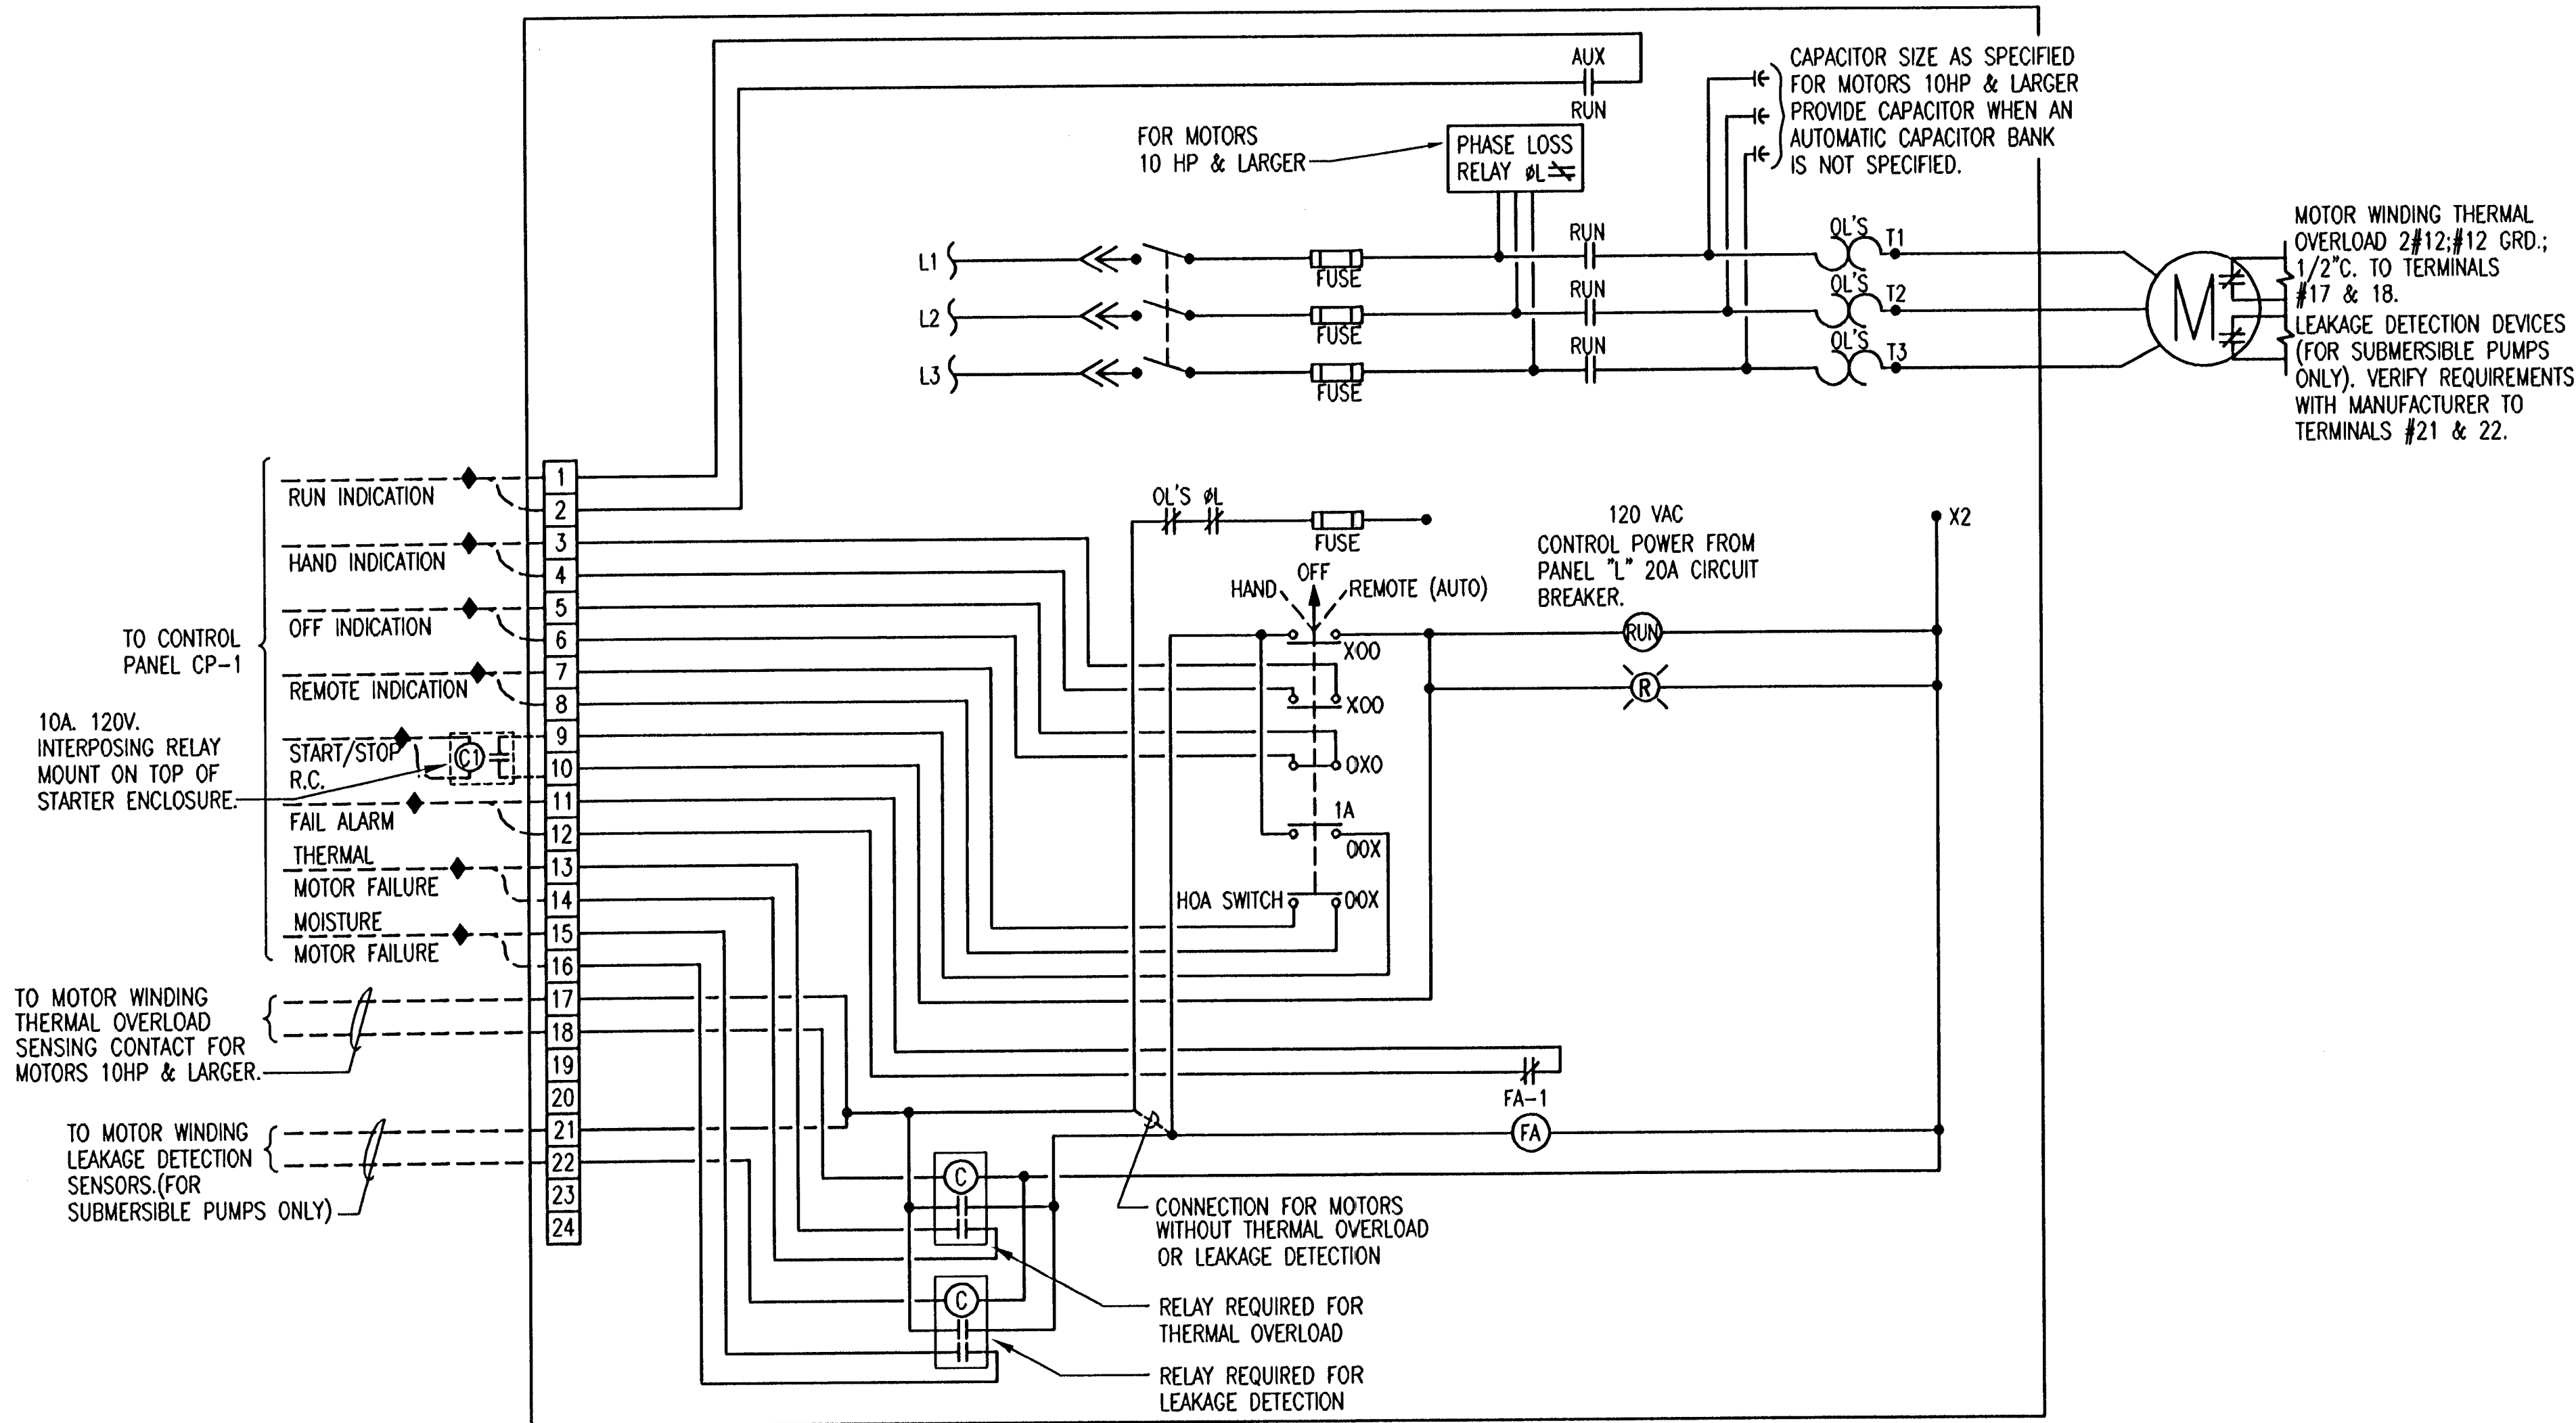


1 TYPICAL ACROSS-THE-LINE STARTER WIRING DIAGRAM
NO SCALE (NOTE: ALLOW ADDITIONAL 3" OF HEIGHT PER STARTER FOR RELAYS).

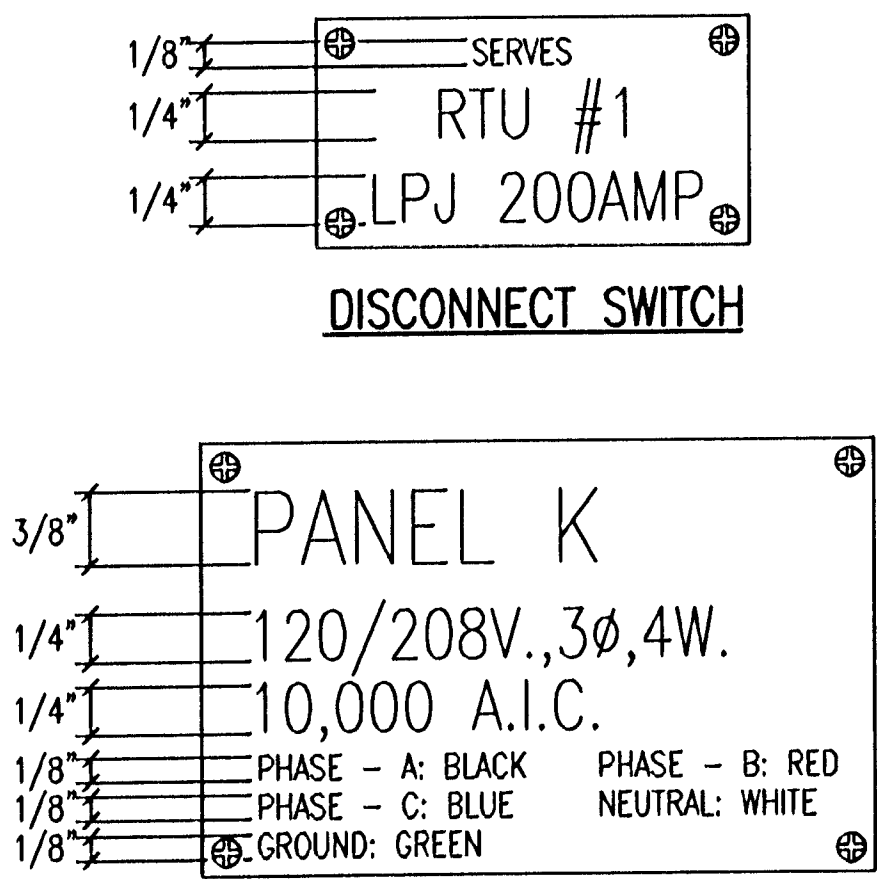

2 TYPICAL NAME PLATES
NO SCALE

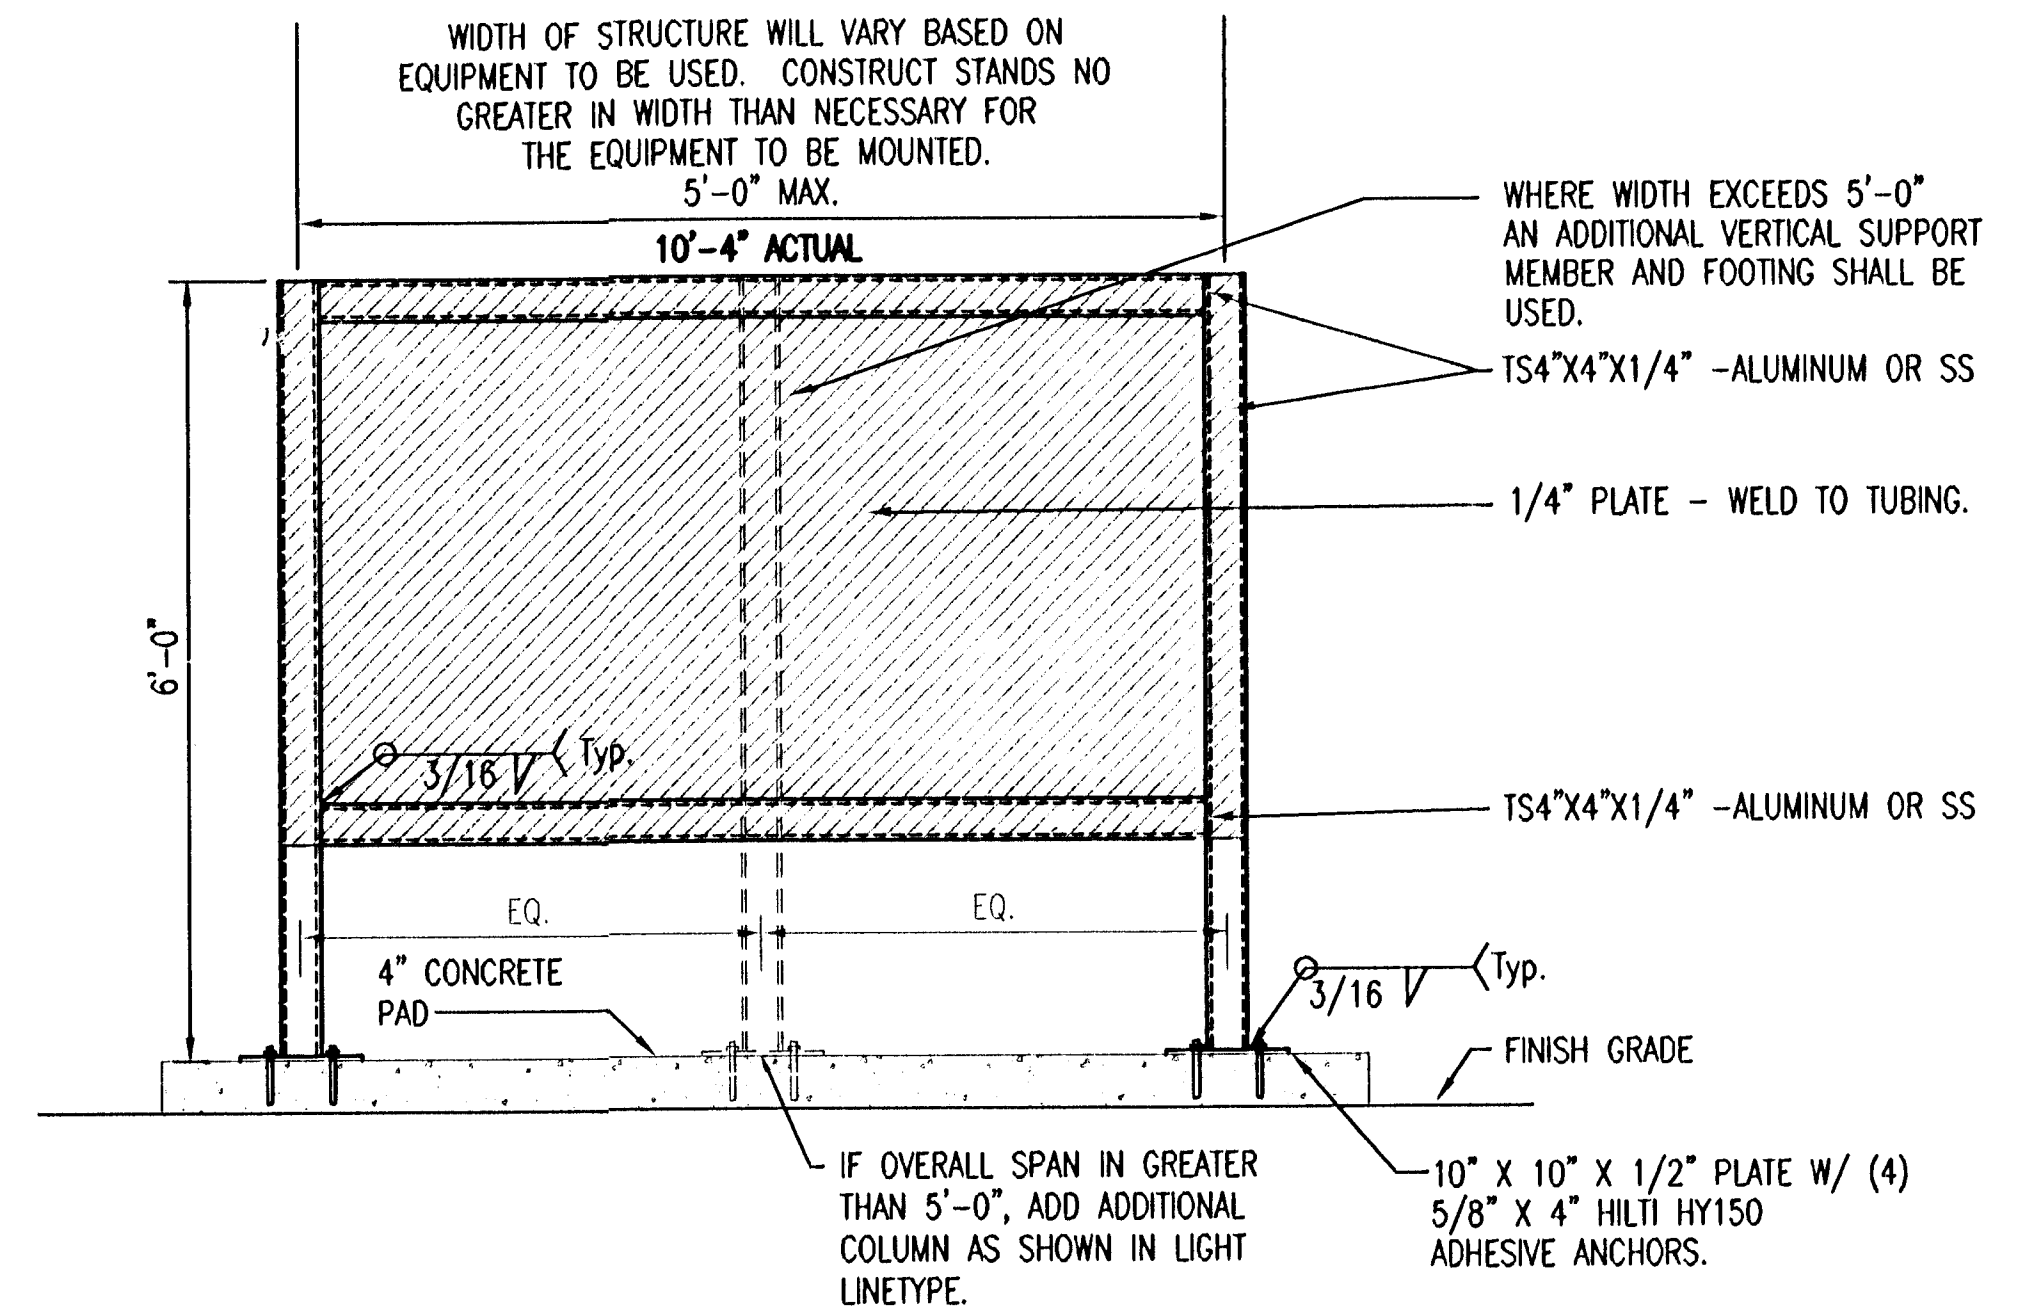

3 TYPICAL ELECTRICAL STRUCTURE DETAIL
NO SCALE

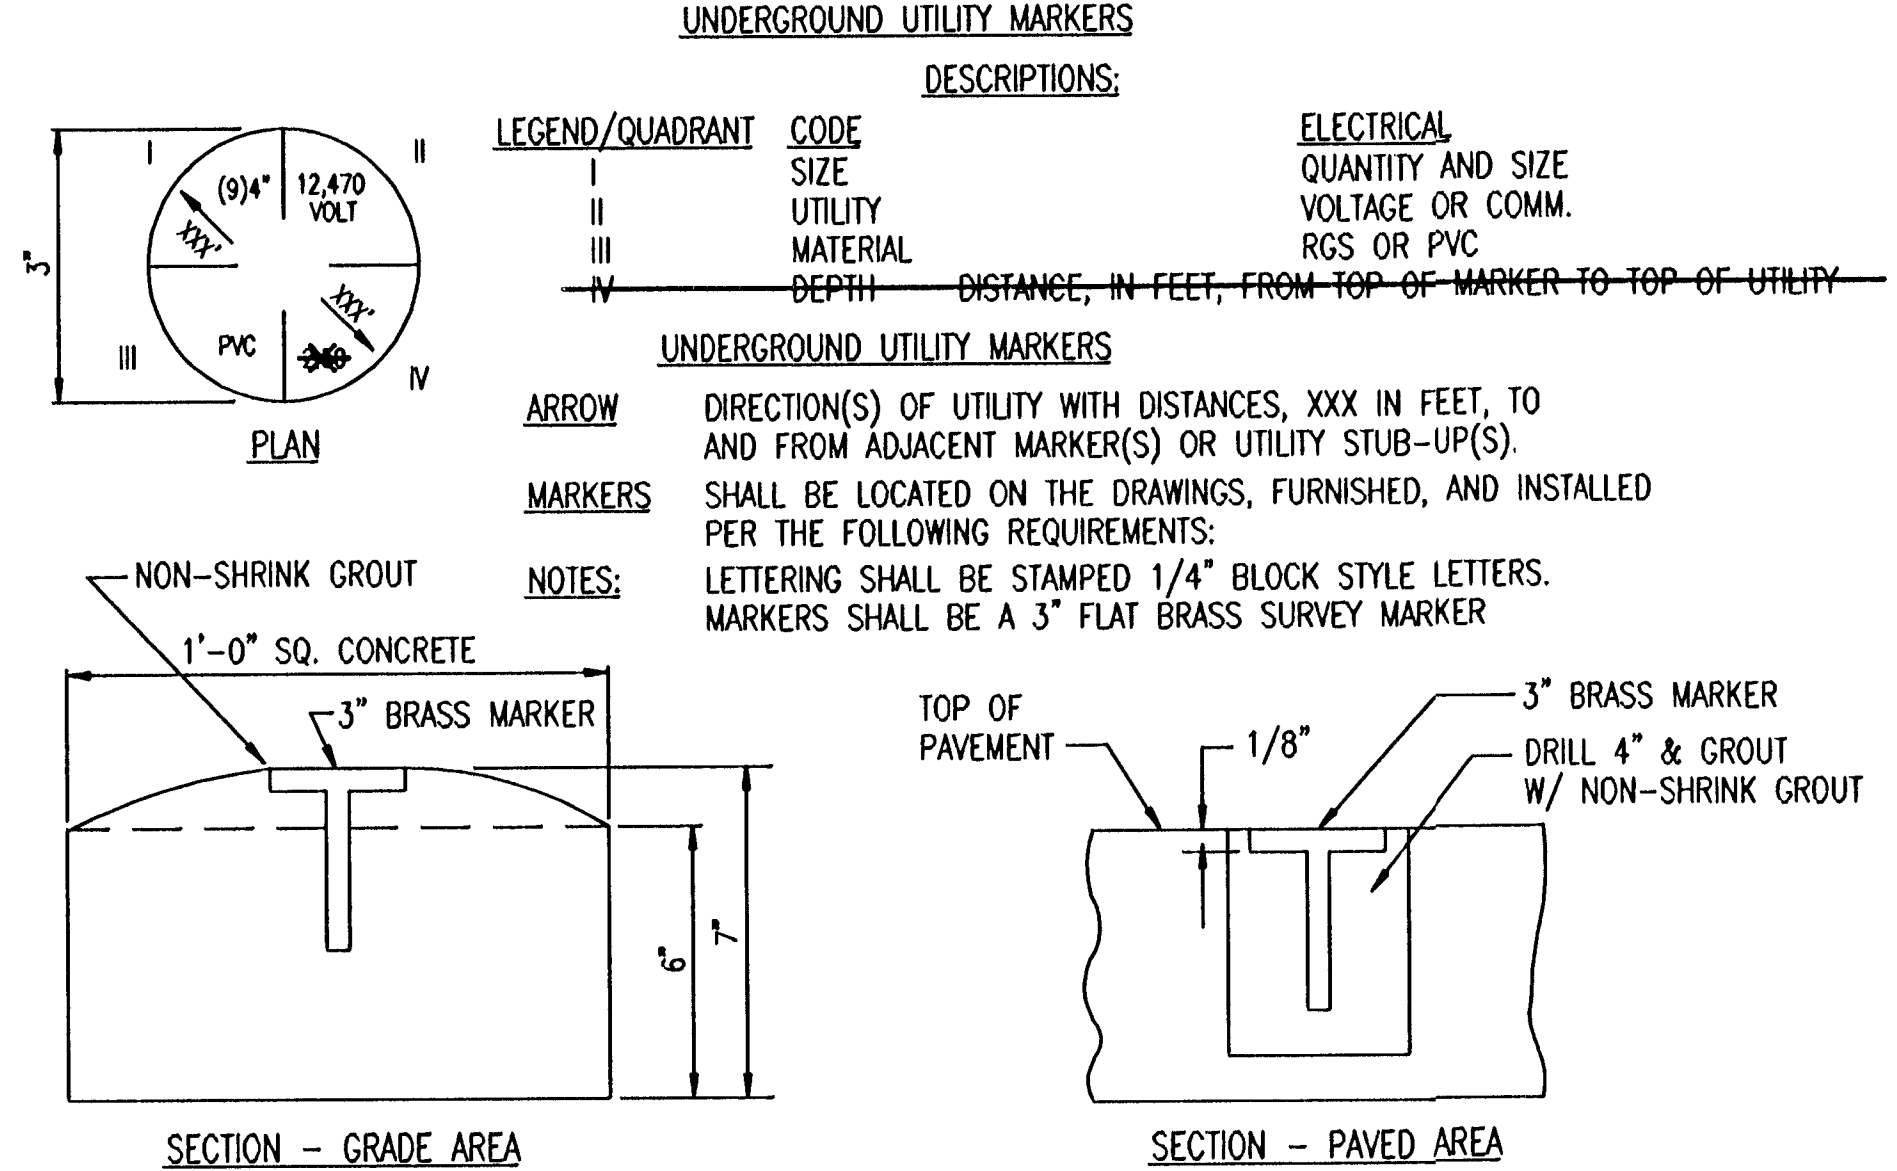

4 UTILITY MARKER DETAIL
NO SCALE

Bob E. E. E.
26 JAN 07
RECORD DRAWING

THE WICHITA AIRPORT AUTHORITY COLONEL JAMES JABARA AIRPORT	
ELECTRICAL DETAILS	
SANITARY SEWER AND WATER DISTRIBUTION SYSTEM SOUTHWEST AREA SITE DEVELOPMENT IMPROVEMENTS	
Professional Engineering Consultants, P.A. 303 S. TOPEKA • WICHITA, KANSAS 67202 316-262-2691 • FAX 316-262-3003	
Date SEPTEMBER 2005	Job No. 05471-019